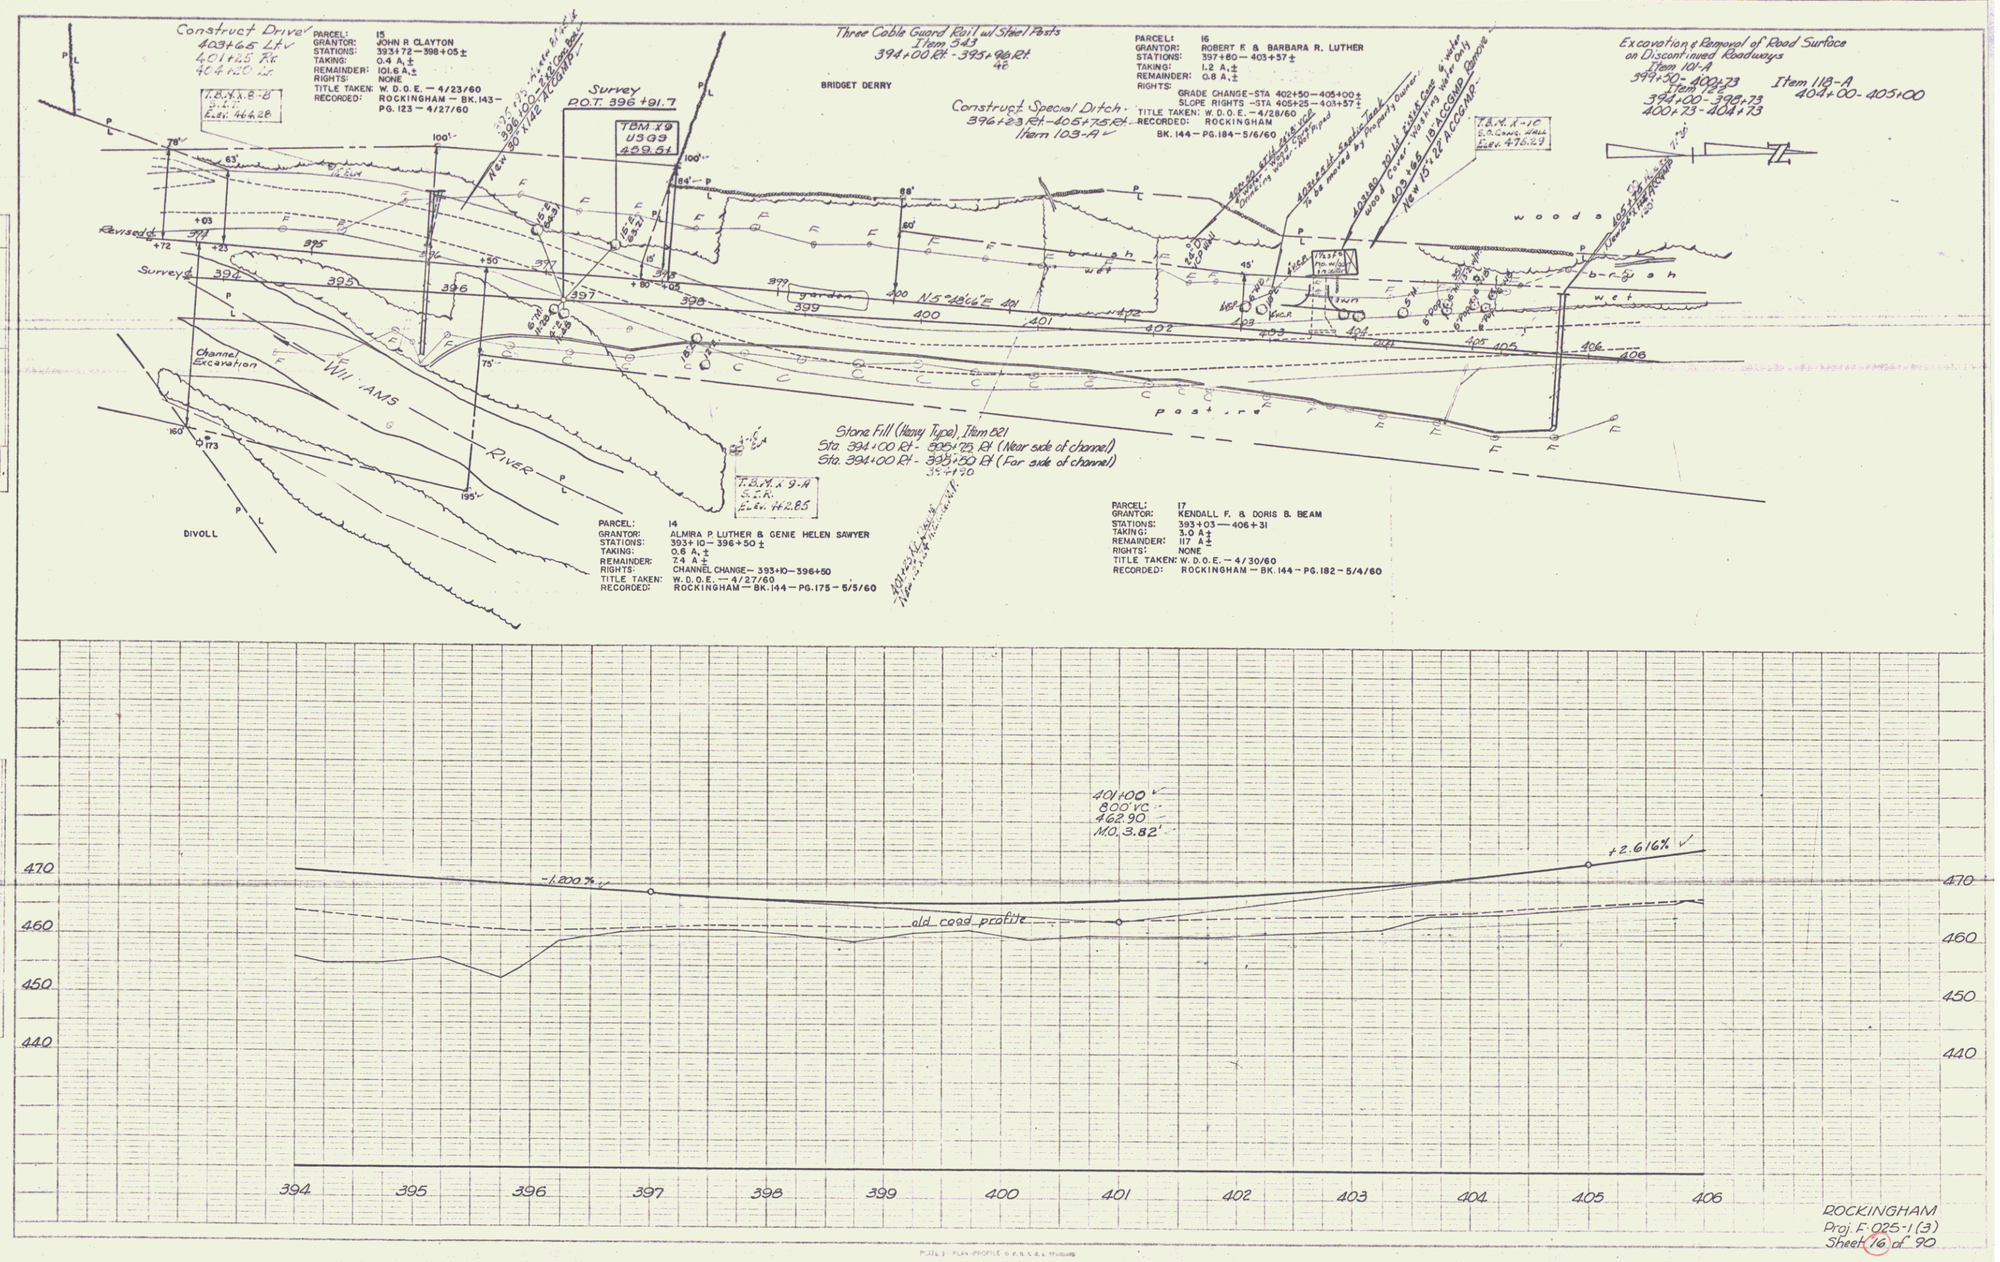
Construct Drive
403+65 Lt
401+25 Rt
404+20 Lt
PARCEL: 15
GRANTOR: JOHN R CLAYTON
STATIONS: 393+72 – 398+05 ±
TAKING: 0.4 A. ±
REMAINDER: 101.6 A. ±
RIGHTS: NONE
TITLE TAKEN: W. D. O. E. – 4/23/60
RECORDED: ROCKINGHAM – BK. 143 – PG. 123 – 4/27/60
T.B.M. X 8-B
S.C.R.
Elev. 466.28
Survey
P.O.T. 396+91.7
TBM X9
U599
459.51
Three Cable Guard Rail w/ Steel Posts
Item 543
394+00 Rt. - 395+96 Rt.
BRIDGET DERRY
Construct Special Ditch
396+23 Rt - 405+75 Rt.
Item 103-A
PARCEL: 16
GRANTOR: ROBERT F. & BARBARA R. LUTHER
STATIONS: 397+80 – 403+57 ±
TAKING: 1.2 A. ±
REMAINDER: 0.8 A. ±
RIGHTS: GRADE CHANGE – STA 402+50 – 405+00 ±
SLOPE RIGHTS – STA 405+25 – 403+57 ±
TITLE TAKEN: W. D. O. E. – 4/28/60
RECORDED: ROCKINGHAM
BK. 144 – PG. 184 – 5/6/60
Excavation & Removal of Road Surface on Discontinued Roadways
Item 101-A
394+50 - 400+73
Item 122
394+00 - 399+73
400+73 - 404+73
Item 118-A
404+00 - 405+00
T.B.M. X-1C
S.C.R.
Elev. 476.29
Revised
Survey
Channel Excavation
WILLIAMS RIVER
DIVOLL
Stone Fill (Heavy Type), Item 821
Sta. 394+00 Rt - 395+75 Rt (Near side of channel)
Sta. 394+00 Rt - 393+50 Rt (Far side of channel)
T.B.M. X 9-A
S.C.R.
Elev. 472.85
PARCEL: 14
GRANTOR: ALMIRA P. LUTHER & GENE HELEN SAWYER
STATIONS: 393+10 – 396+50 ±
TAKING: 0.6 A. ±
REMAINDER: 7.4 A. ±
RIGHTS: CHANNEL CHANGE – 393+10 – 396+50
TITLE TAKEN: W. D. O. E. – 4/27/60
RECORDED: ROCKINGHAM – BK. 144 – PG. 175 – 5/5/60
PARCEL: 17
GRANTOR: KENDALL F. & DORIS B. BEAM
STATIONS: 393+03 – 406+31
TAKING: 3.0 A. ±
REMAINDER: 117 A. ±
RIGHTS: NONE
TITLE TAKEN: W. D. O. E. – 4/30/60
RECORDED: ROCKINGHAM – BK. 144 – PG. 182 – 5/4/60
woods
brush
wet
pasture
garden
N 15°28'66" E
401+00
800' VC
462.90
M.O. 3.82'
-1.200%
+2.616%
old road profile
470
460
450
440
394
395
396
397
398
399
400
401
402
403
404
405
406
ROCKINGHAM
Proj. F-025-1(3)
Sheet 16 of 90
8