




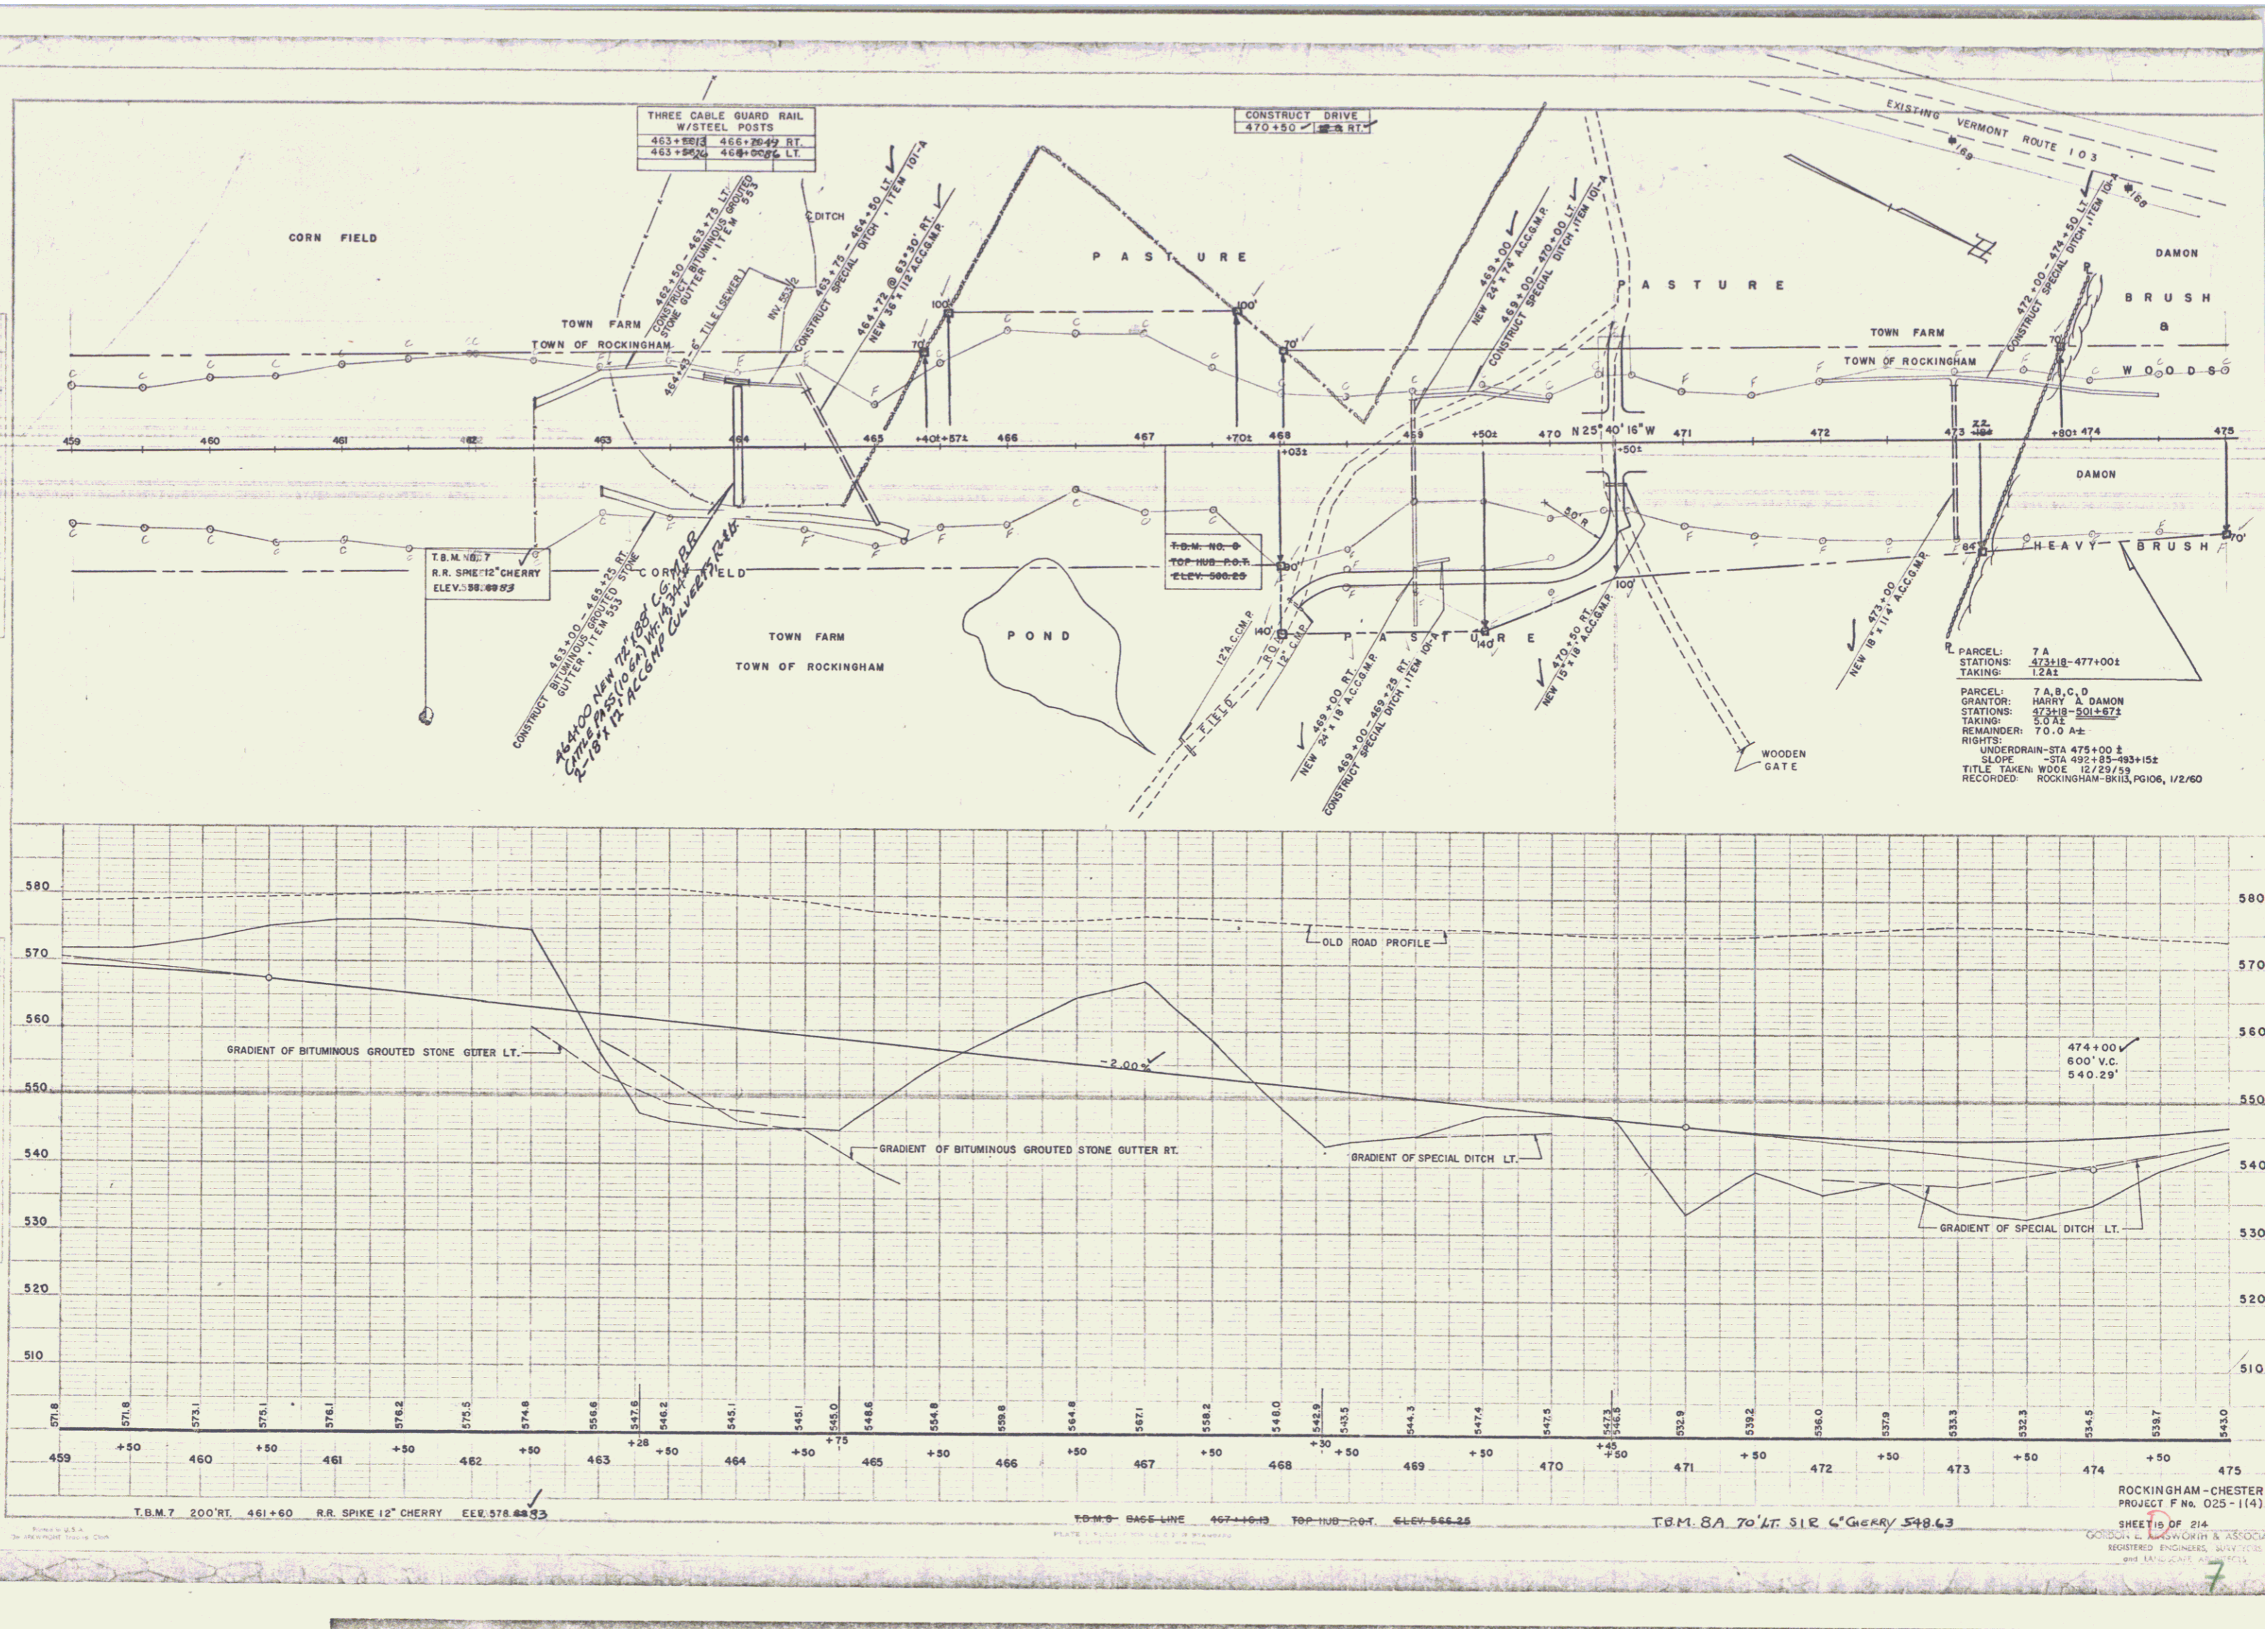

T.B.M. 7 200' RT. 461+60 R.R. SPIKE 12" CHERRY ELEV. 578.88 33
 T.O.M. BASE LINE 467+10 RT. TOP HUB - P.O.T. ELEV. 546.25
 T.B.M. 8A 70' LT. 512 6" CHERRY 548.63
 ROCKINGHAM-CHESTER PROJECT F No. 025-1(4)
 SHEET 15 OF 214
 GORDON E. ANSWORTH & ASSOCIATES
 REGISTERED ENGINEERS, SURVEYORS
 AND LANDSCAPE ARCHITECTS
 125 WEST STREET
 VERMONT, U.S.A.