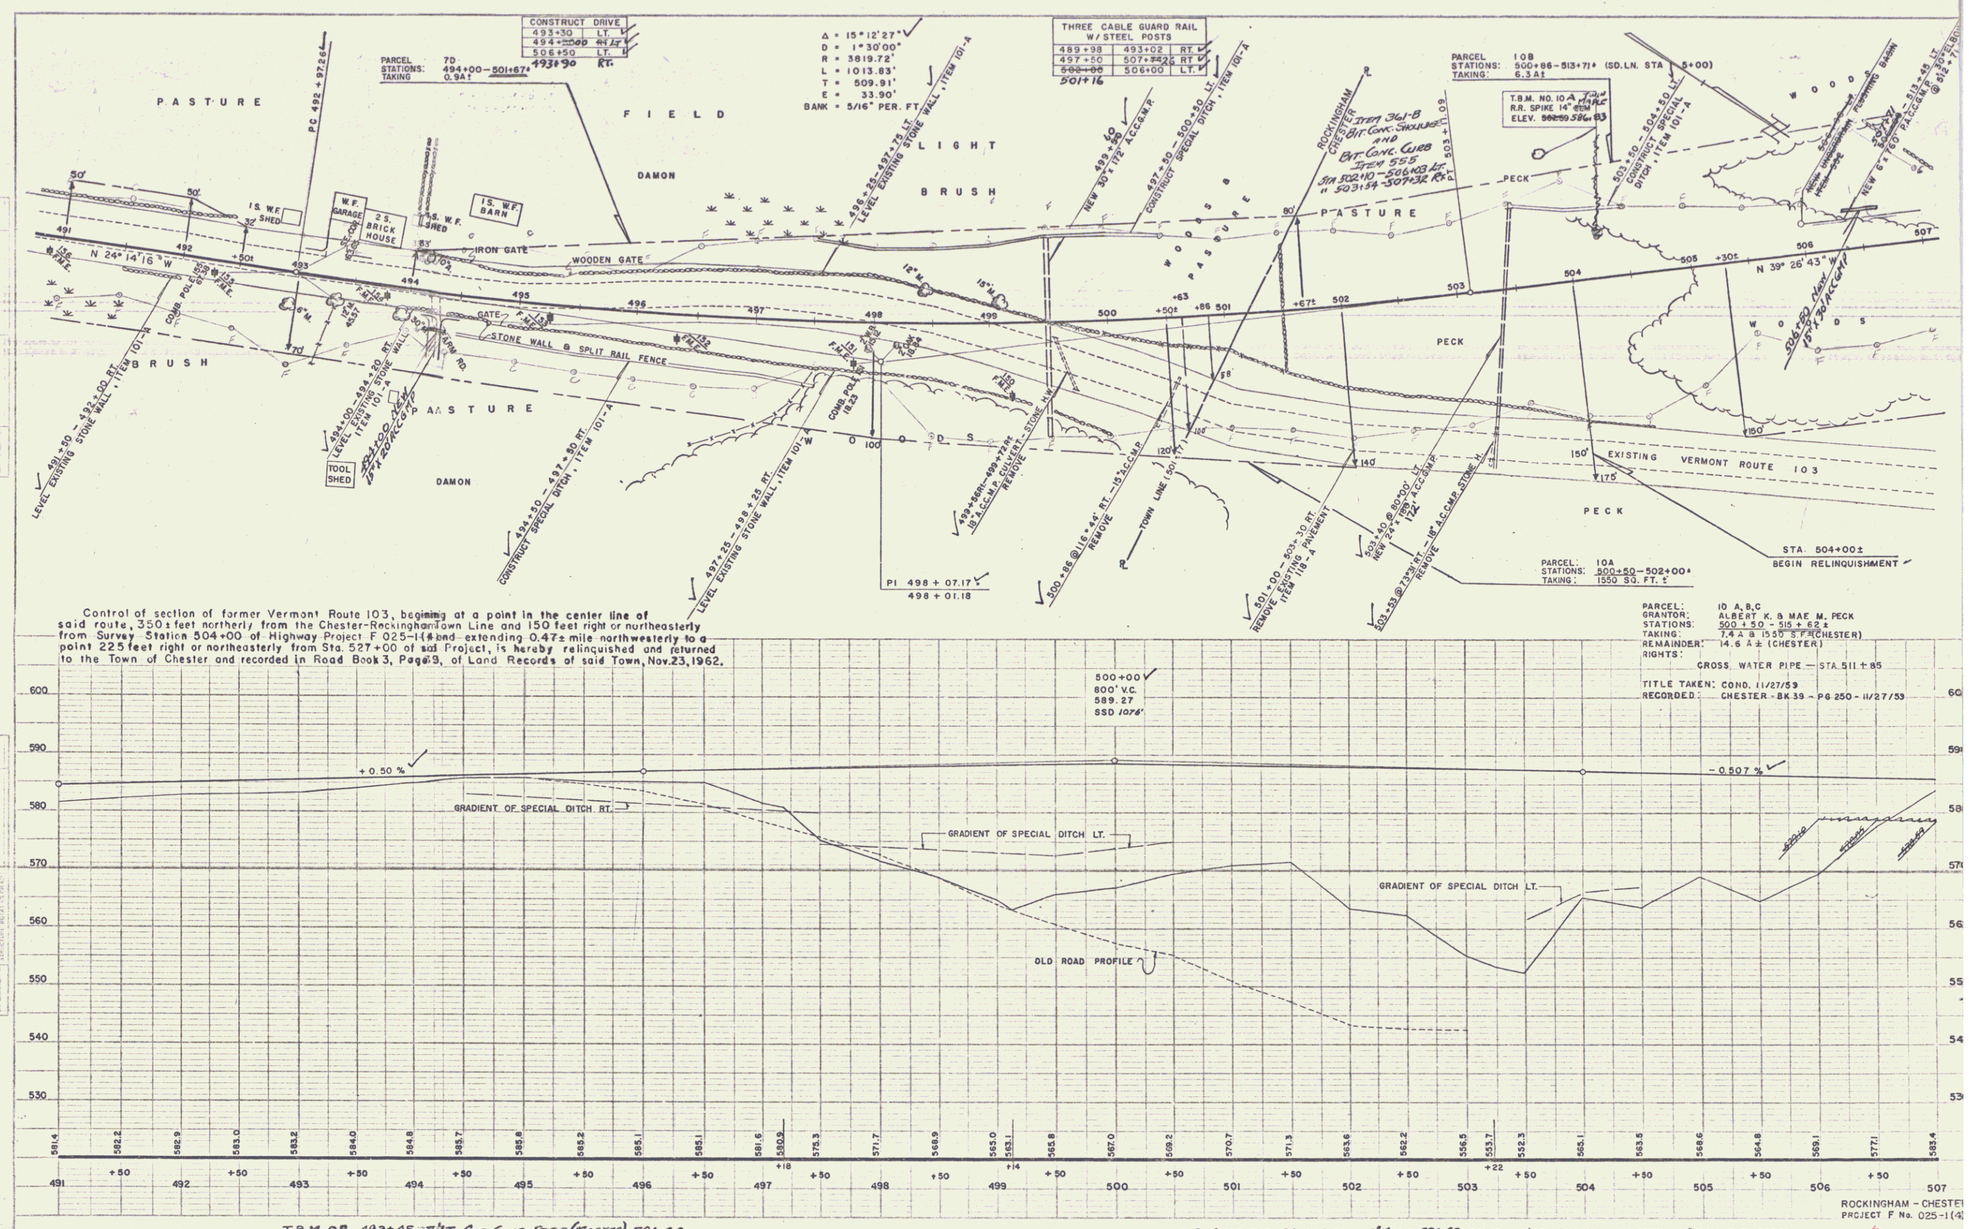

Control of section of former Vermont Route 103, beginning at a point in the center line of said route, 350± feet northerly from the Chester-Rockingham Town Line and 150 feet right or northeasterly from Survey Station 504+00 of Highway Project F 025-1(4) and extending 0.47± mile northwesterly to a point 225 feet right or northeasterly from Sta. 527+00 of said Project, is hereby relinquished and returned to the Town of Chester and recorded in Road Book 3, Page 9, of Land Records of said Town, Nov. 23, 1962.