
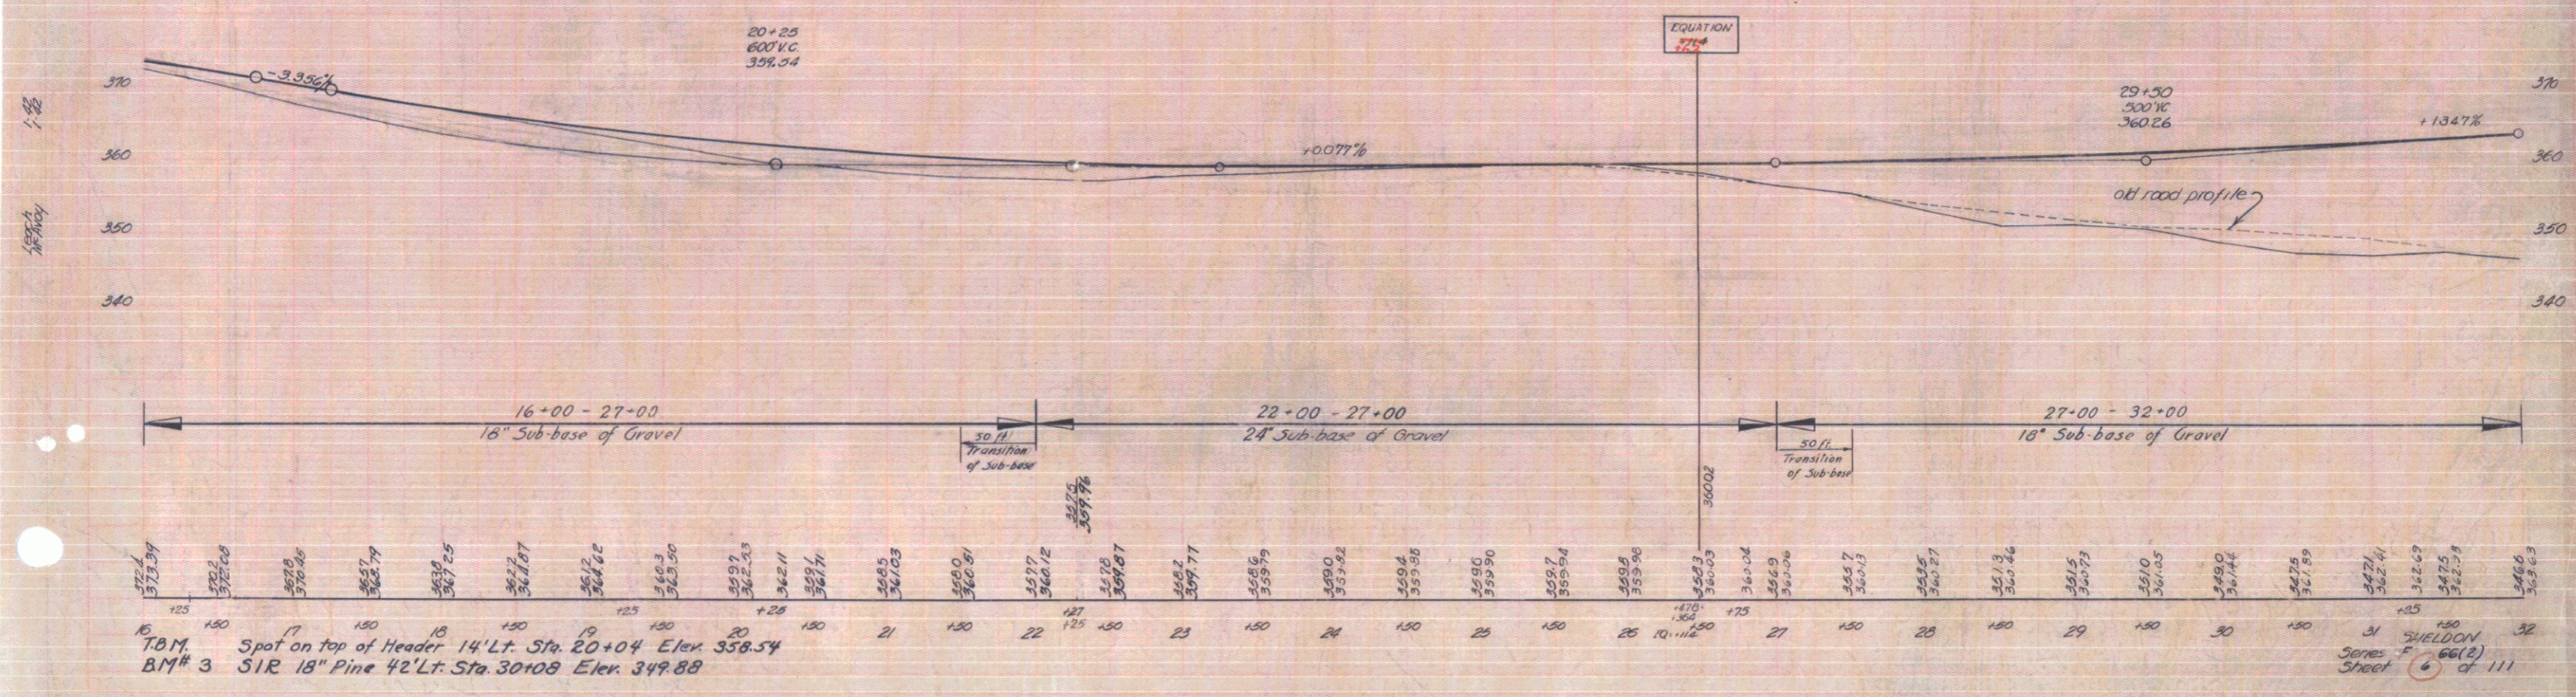


PARCEL	INSTRUMENT	DATE	GRANTOR	GRANTEE	RECORDED	REMARKS
A, B	CORP D.O.E.	11-4-43	MISSISSQUOI CORP	ST OF VT	BOOK PAGE DATE	
					22 225-B 3-24-44	

F
66(2)1946 6 111

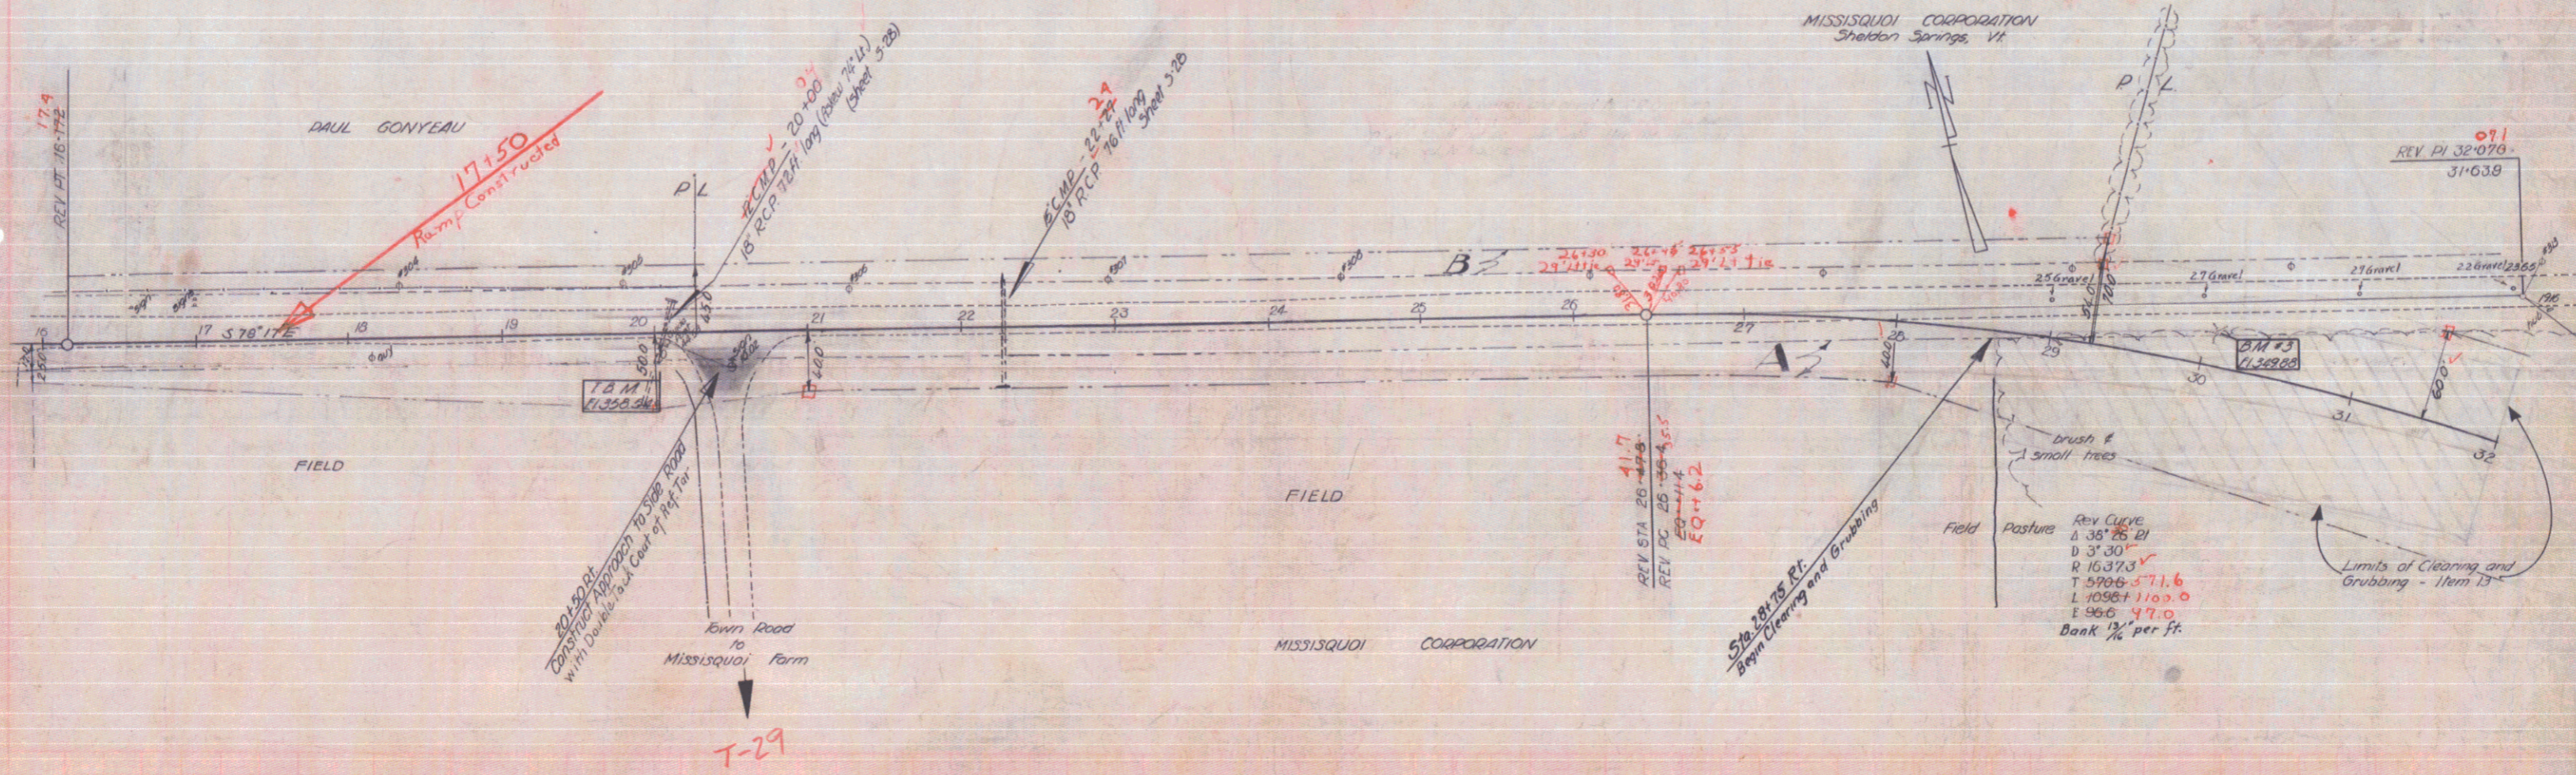

TBM Spot on top of Header 14' Lt. Sta. 20+04 Elev. 358.54
BM# 3 51R 18" Pine 42' Lt. Sta. 30+08 Elev. 349.88

31 SHELDON
Series F 66(2)
Sheet 6 of 111