Sign placed by the State of Vermont.

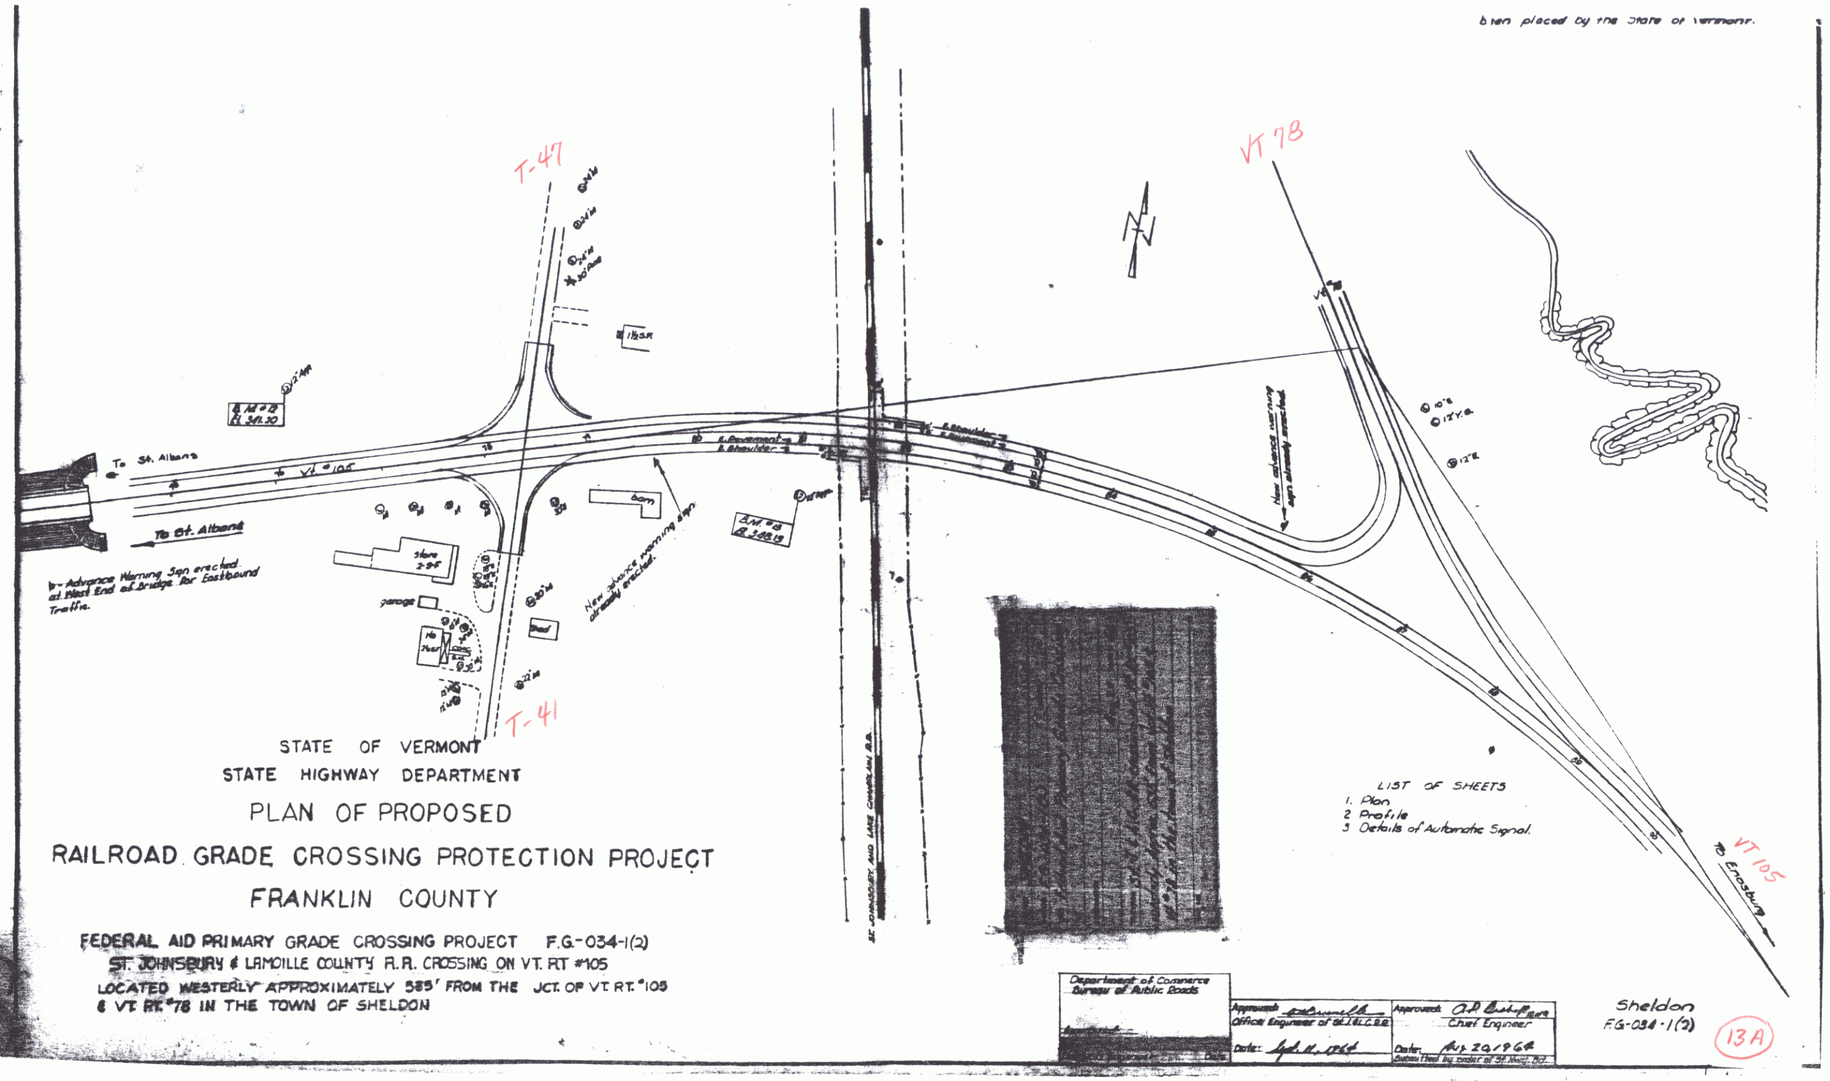

STATE OF VERMONT
STATE HIGHWAY DEPARTMENT

PLAN OF PROPOSED
RAILROAD GRADE CROSSING PROTECTION PROJECT
FRANKLIN COUNTY

FEDERAL AID PRIMARY GRADE CROSSING PROJECT F.G.-034-1(2)
ST. JOHNSBURY & LAMOILLE COUNTY R.R. CROSSING ON VT. RT #105
LOCATED WESTERLY APPROXIMATELY 585' FROM THE JCT. OF VT. RT. #105
& VT. RT. #78 IN THE TOWN OF SHELDON

Department of Commerce
Bureau of Public Roads

Approved [illegible]
Office Engineer of St. H.C.S.B.R.
Date: Feb. 11, 1964

Approved [illegible]
Chief Engineer
Date: Aug. 20, 1964
Submitted by order of St. Hwy. Bd.

Sheldon
F.G-034-1(2)

13A

8