134-L 1932 Hwy

GUIDE POSTS OF WOOD

STATION	LEFT	RIGHT
130+42	1	—
136+40	1	—

WOOD GUARD RAIL

STATION	LEFT	RIGHT
145+84	24	24

CABLE GUARD RAIL

STA TO STA	LORR	LENG	CONST	PAY LENG
130+25 - 131+73	Lt	48	40	88
130+35 - 131+73	Rt	48	40	88
133+36 - 137+27	Rt	191	40	231

REINFORCED CONCRETE PIPE CULVERTS

STATION	SKEW	LENG	CONC A	CRM	REINF STEEL
150+42	33°	32	1.8 cy		29#
186+40	15°	40		2.7 cy	

Parcel	Kind of Instrument	Date of Instrument	Grantor	Grantee	Recorded Book	Recorded Page	Recorded Date	Remarks
B	Q.C.D	7-13-32	Geo. Langlois	St. of Vt.	1	448	8-19-32	Essex
A'-B'	Q.C.D.	7-13-32	W. & E. Demar	" - "	23	424	8-19-32	Berkshire

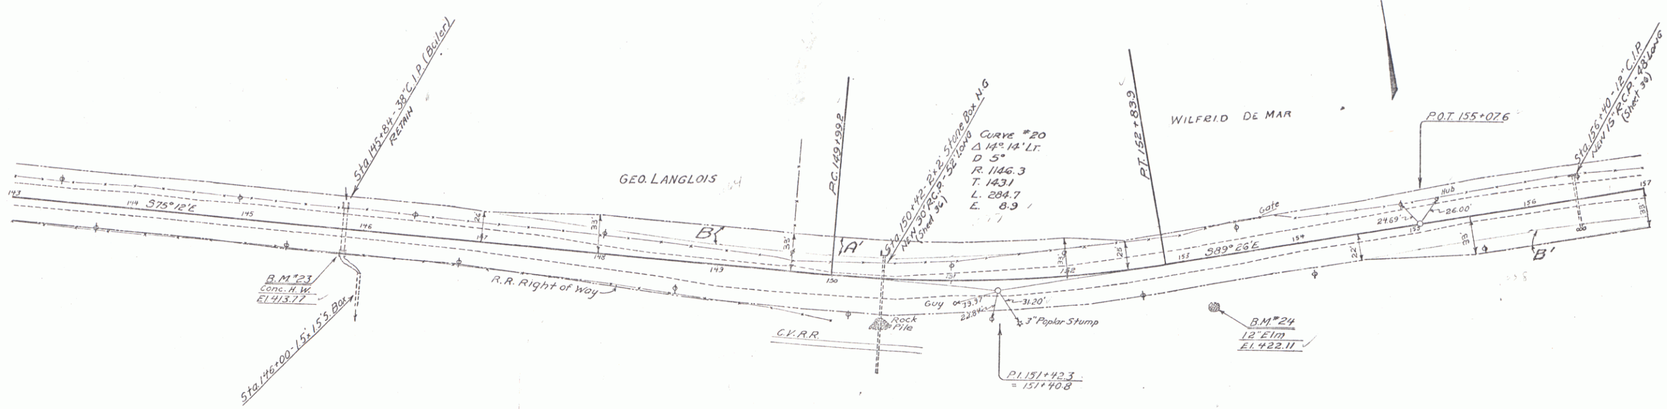

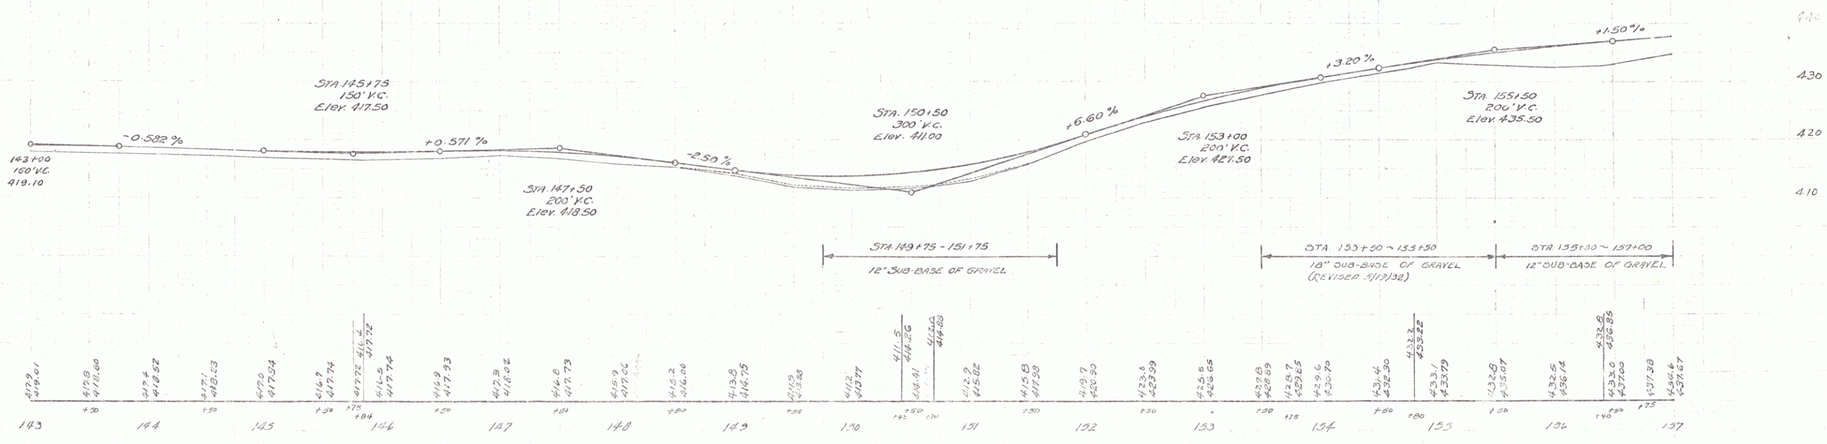

B.M. #23 PAINT SPOT ON CONC. CULV. HEADWALL 17.5 FT. RT. STA. 145+82 ELEV. 413.77

B.M. #24 SPIKE IN ROOT 12" ELM 38 FT. AT STA. 153+16 ELEV. 422.11

SERIES F 116-13A-L
SHEET 14 OF 90

12