134-L, 1932 25 90

GUIDE POSTS OF WOOD

STATION	LEFT	RIGHT
320+73	2	2

CABLE GUARD RAIL

STA TO STA	LOCK	LENG.	CONSTANT	PAY LENG
326+08 - 328+08	LT.	200'	40'	240'
327+60 - 328+08	Rt.	48'	40'	88

CULVERT REPAIRS

STATION	TYPE	REPAIRS	CONC.	REINF. STEEL
320+73	8'x6' CONC. ARCH	EXTEND 5' U.	6.2	600#

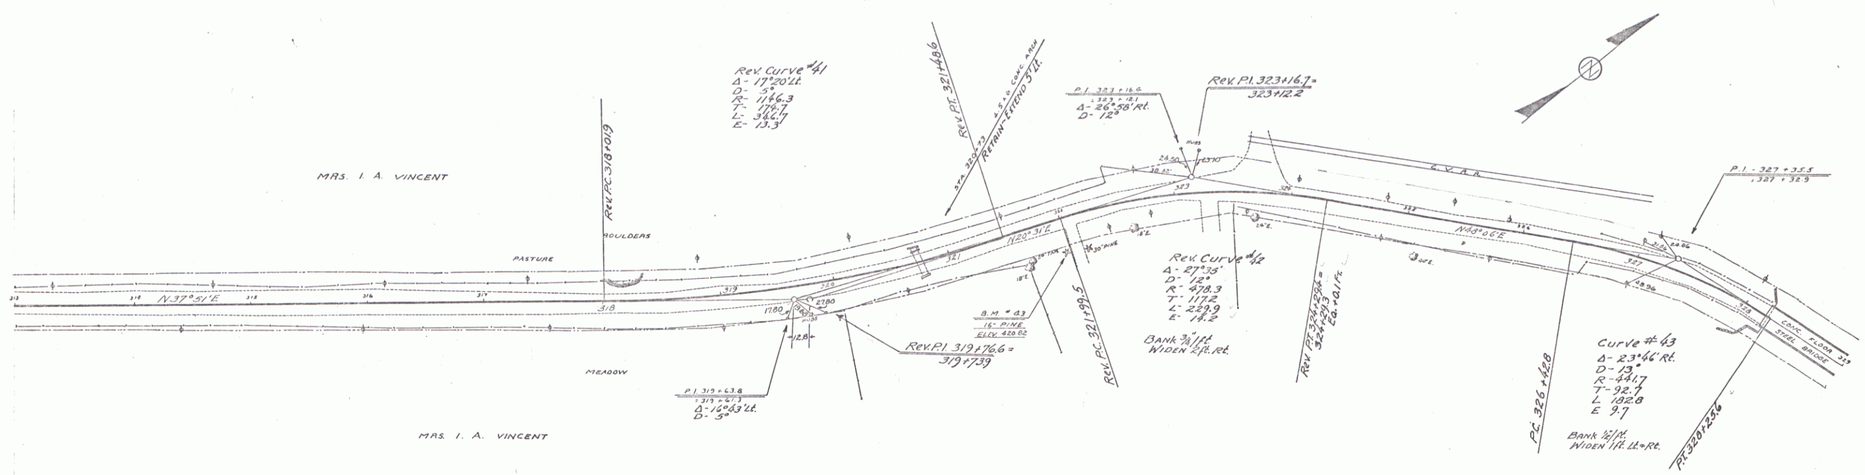

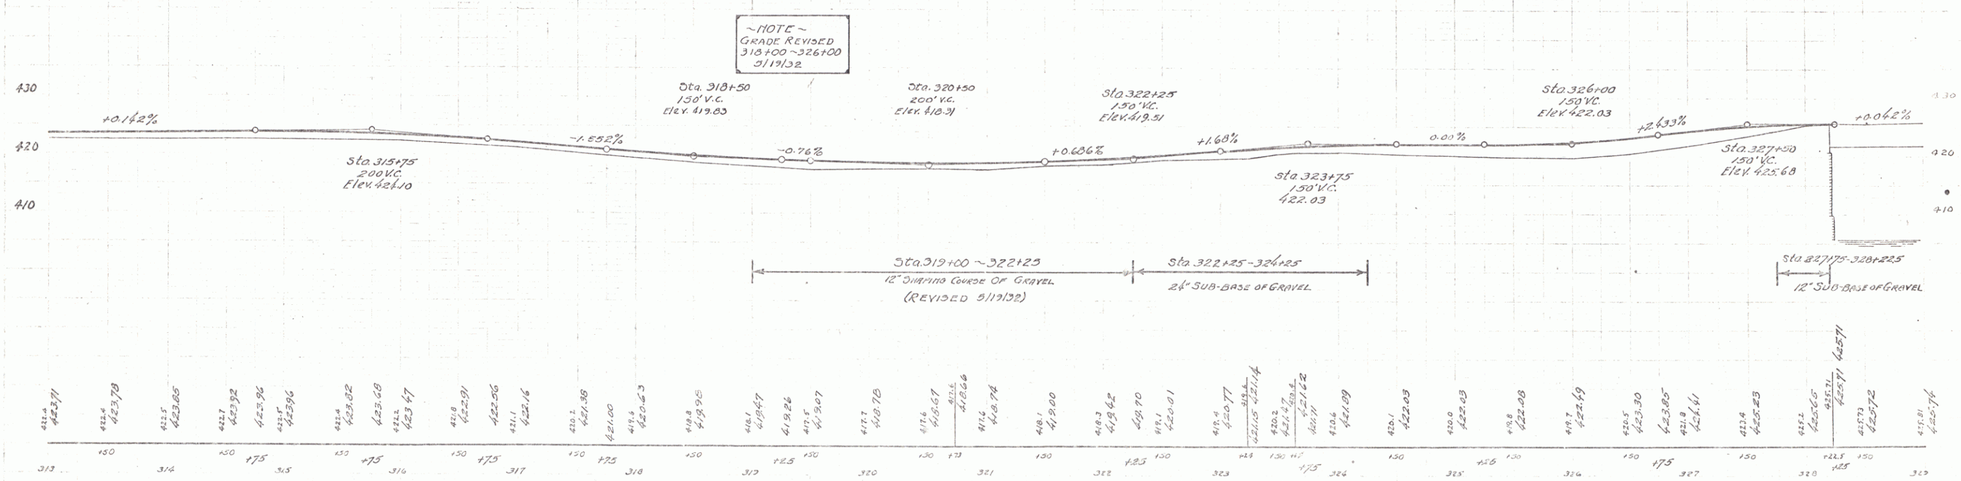

B.M. # 43 SPIKE IN ROOT 16" PINE 20 FT. RT. STA. 321+90 ELEV. 420.82

SERIES F No. 134-L
SHEET 25 OF 90

See Berkshire
F-FL 034-1(1)

23