134-L, 1932 32

GUIDE POSTS OF WOOD

STATION	LEFT	RIGHT
429+27	1	1

REINFORCED CONCRETE PIPE CULVERTS

STATION	SIZE	LENG.	CONC. A	C.R.M.	REINF. STEEL
429+27	12"	36'	~	20 CY.	~

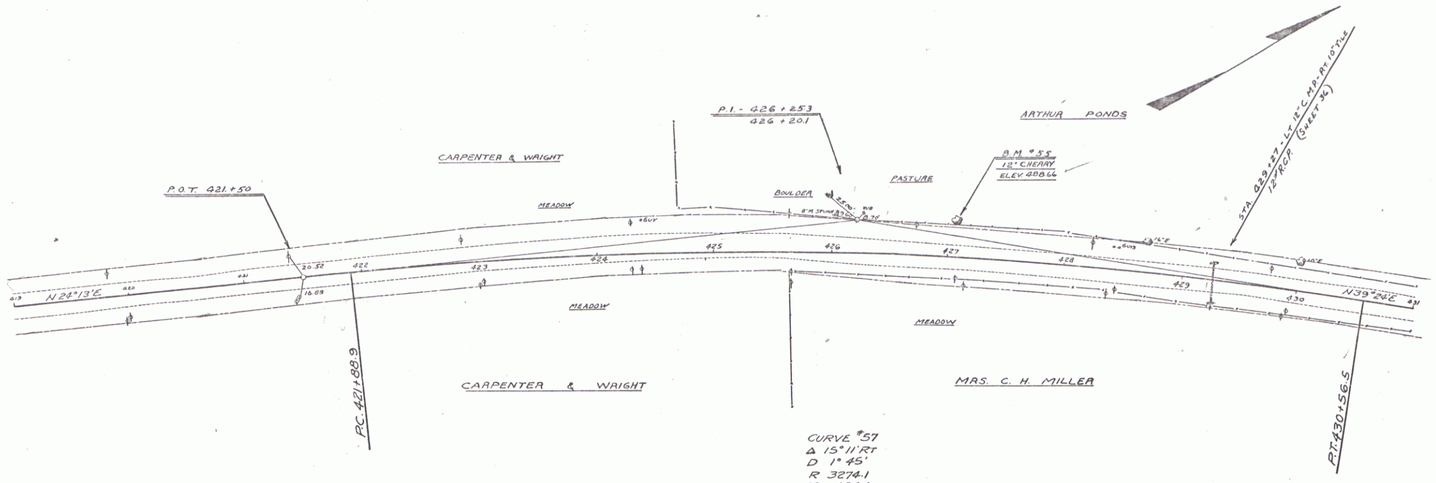

CURVE #57
Δ 15°11' Rt
D 1°45'
R 3274.1
T 436.4
L 867.6
E 28.9

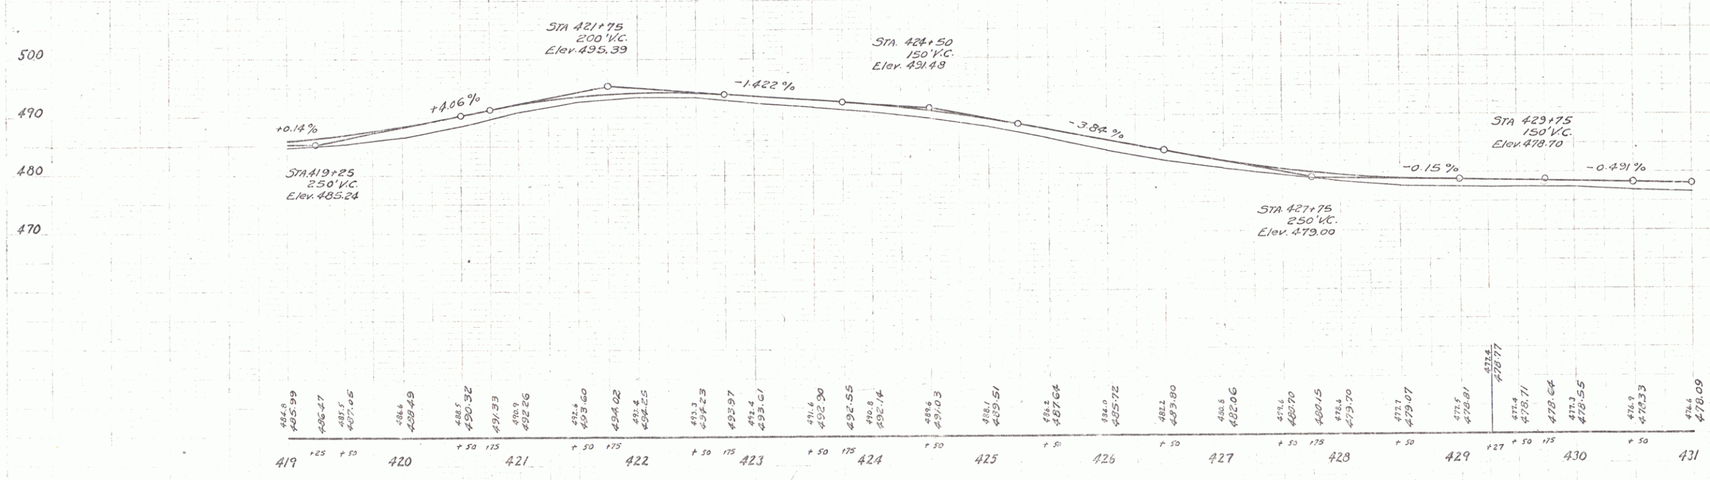

B.M. #55 SPIKE IN TRUNK 12" CHERRY 28 FT. LT. STA. 427+07 ELEV. 488.66

SERIES F No. 134-L
SHEET 32 OF 90

30