134-L 1932 34 90

STD. UNDERDRAIN WITH 6" PERF. C.G.M. PIPE (CONTD)

STA TO STA	℄ LOW	LENGTH	CRM.
448+23 to 453+93	℄	370'	~

GROUTED COBBLE GUTTER

STA TO STA	LOW ℄	LENG	WIDTH	AREA
450+25 to 451+75	Rt.	150'	3.0	50 s.y.

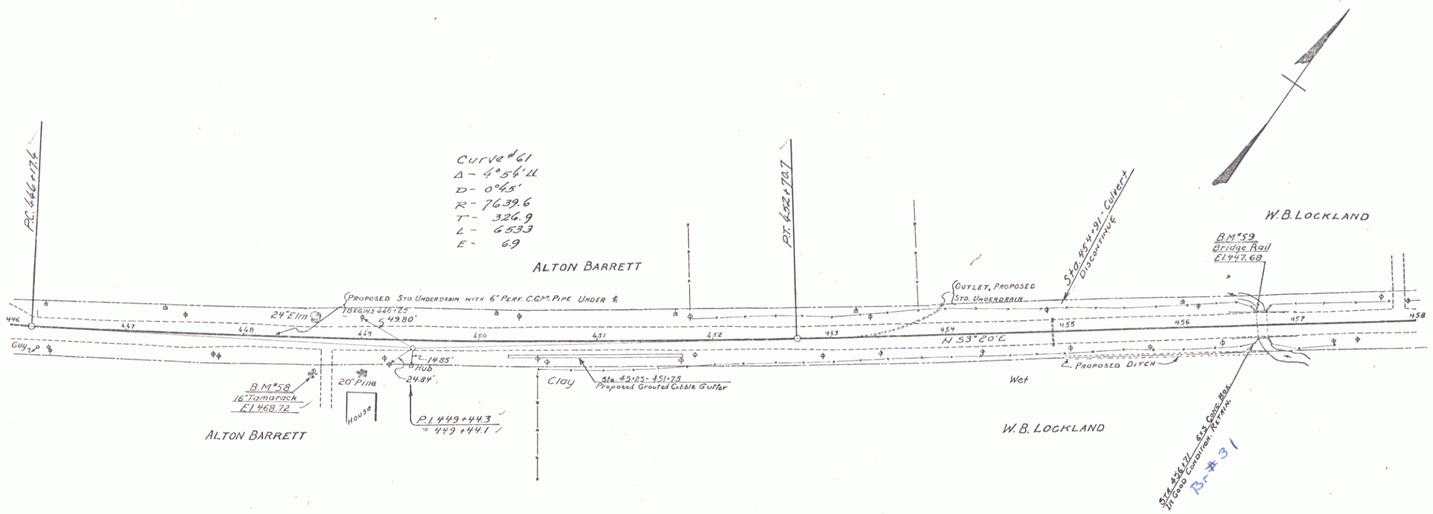

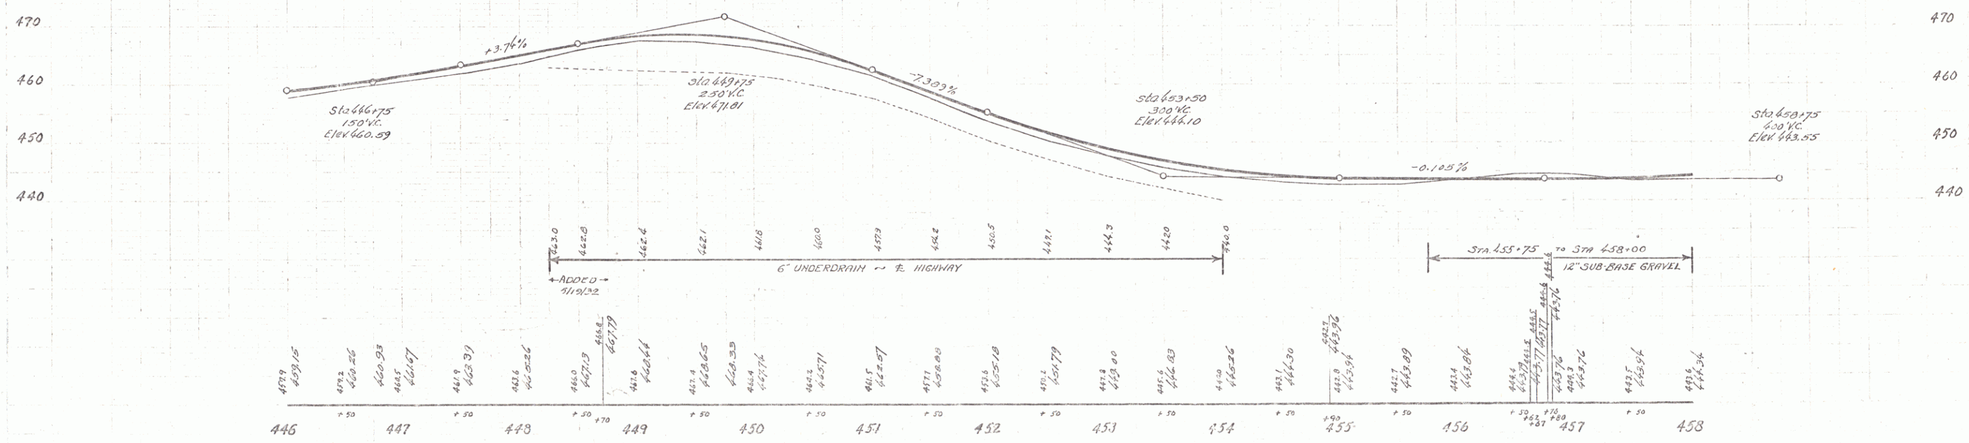

B.M. #58 SPIKE IN ROOT 16" TAMARACK 27 FT. RT. STA. 449+60 ELEV. 468.72

B.M. #59 CONC. BRIDGE RAIL 11 FT. LT. STA 456+67 ELEV. 447.68

Series F No. 134
Sheet 34 of 90

32