PROJECT DESIGNATION	STATE	FEDERAL PROJ. NO.	FISCAL YEAR	SHEET NO.	TOTAL SHEETS
9	VT.	FR 20A	1928		

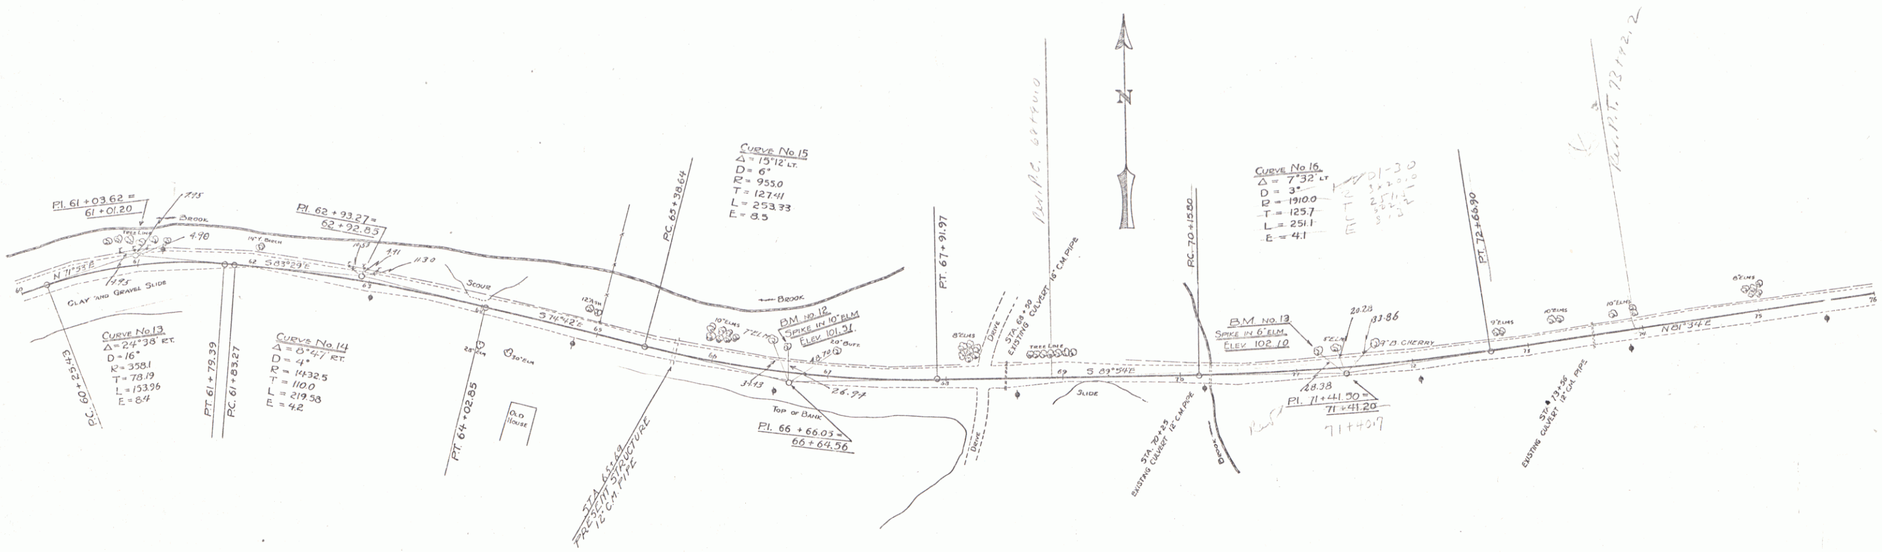

B.M. No. 12 ~ Spike in 10" Elm 19 ft. left of Sta. 66 + 62 ~ Elev. 101.51
B.M. No. 13 ~ Spike in butt 6" Elm 13 ft. left of Sta. 71 + 18 ~ Elev. 102.10

Series No. 20A.
Sheet 2 of 23 Sheets

E.C. Ball 7/1/28
E.C. Ball 7/1/28
E.C. Ball 7/1/28

2