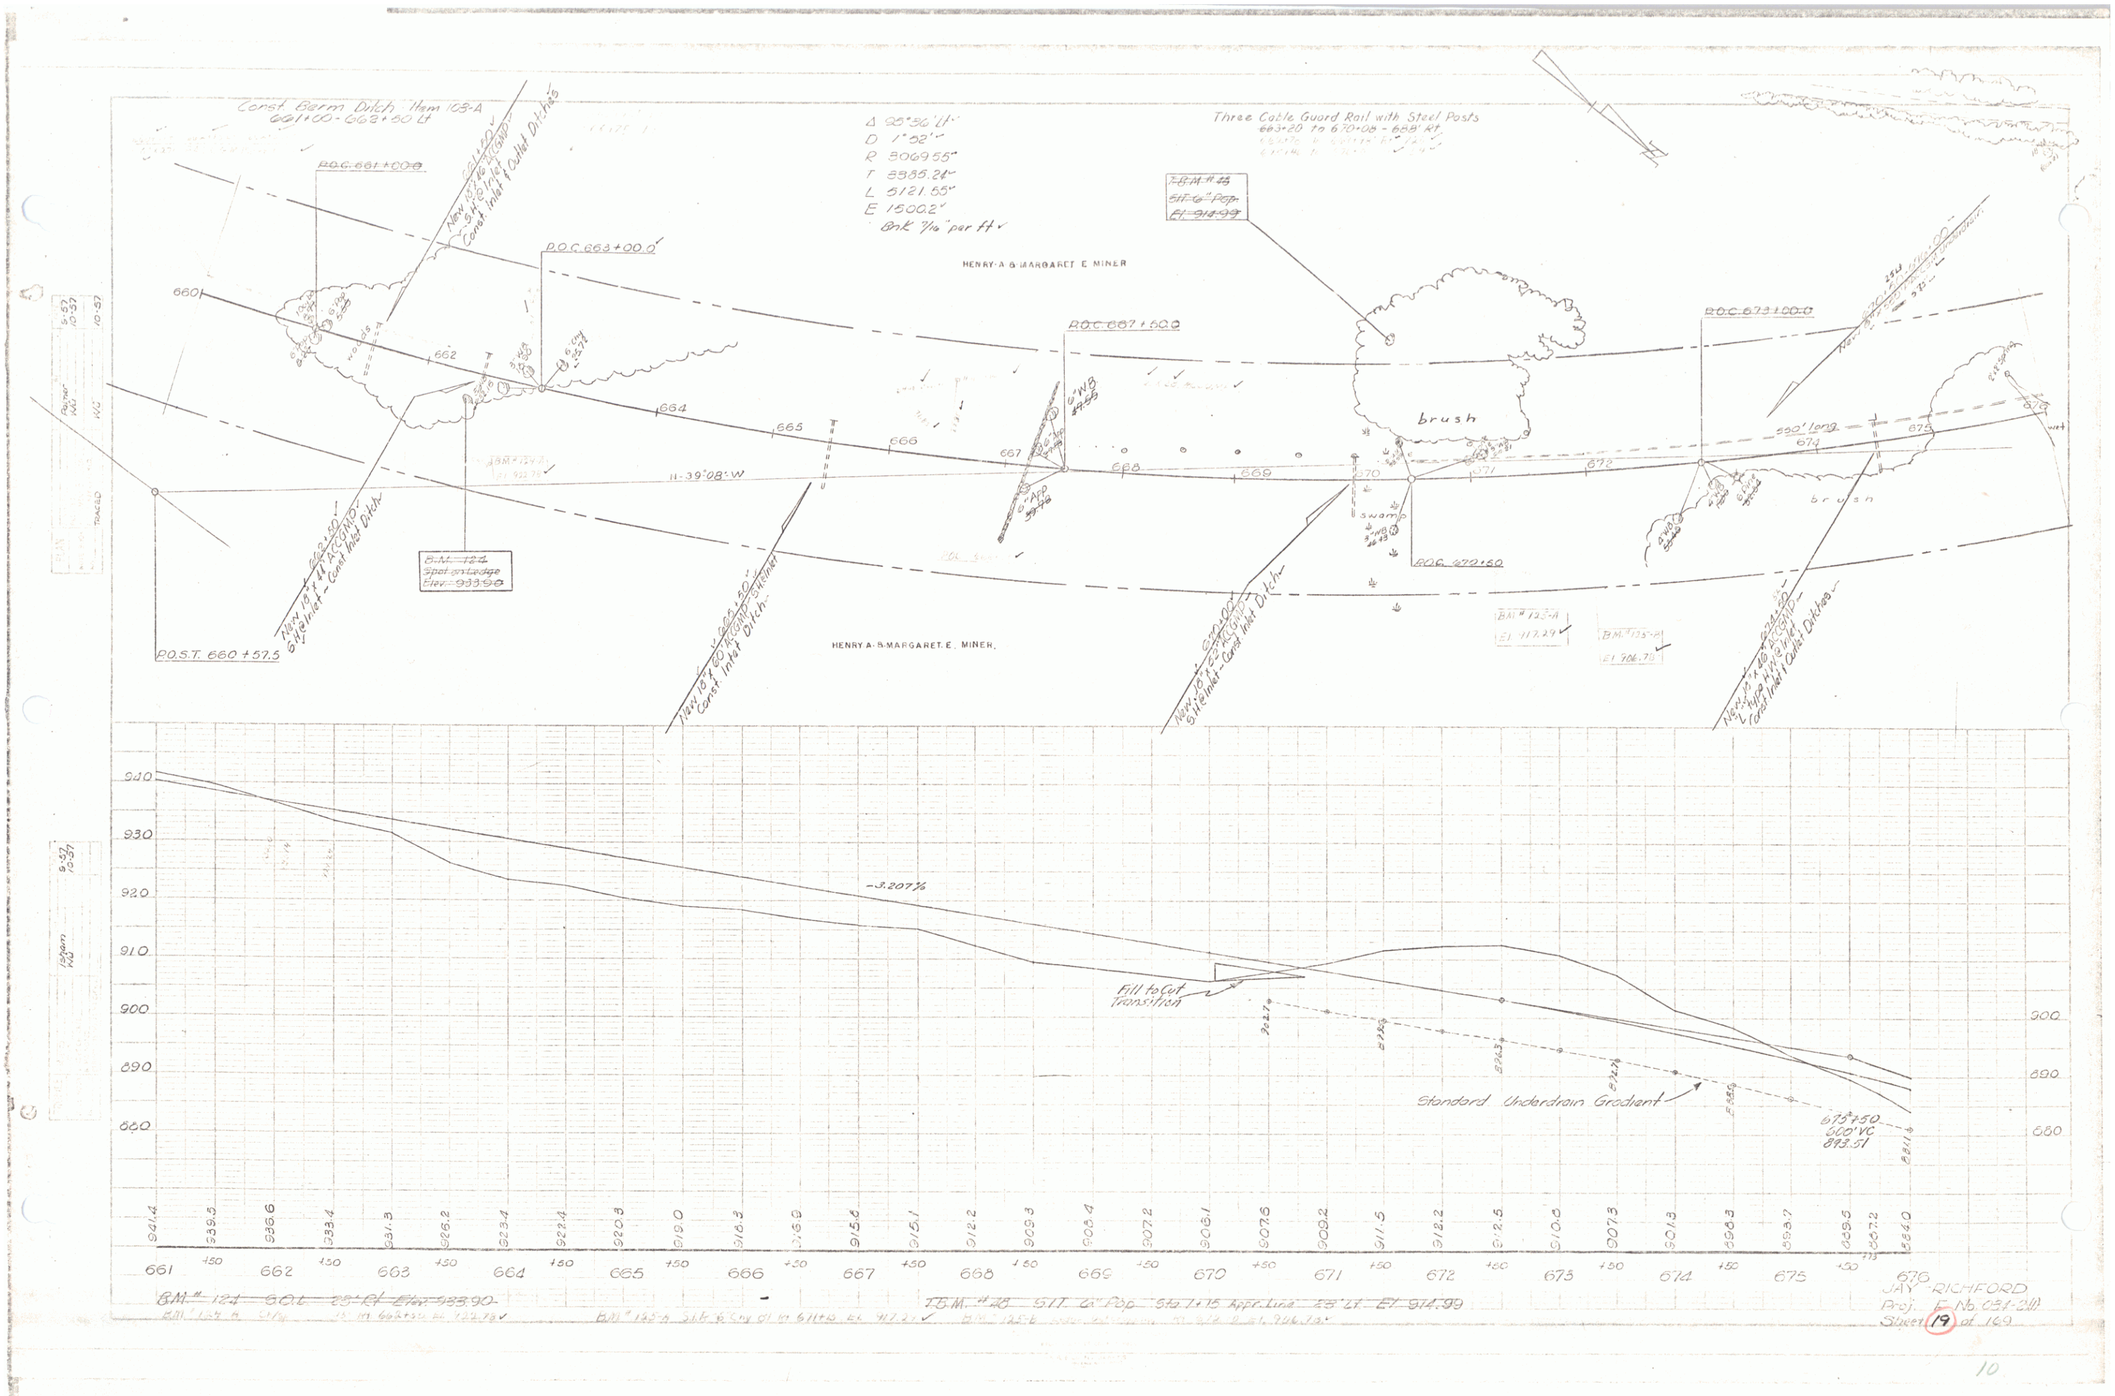
Const Berm Ditch - Item 108-A
669+00 - 663+50 Lt
Δ 25°36' Lt
D 1°02'
R 5669.55'
T 1385.26'
L 2121.65'
E 150.02'
Bnk 7/10' per ft
Three Cable Guard Rail with Steel Posts
663+20 to 670+08 - 688' Rt
HENRY A & MARGARET E MINER
P.O.C. 661+00.0
P.O.C. 663+00.0
P.O.C. 667+60.0
P.O.C. 673+00.0
P.O.S.T. 660+57.5
P.O.C. 670+60
brush
swamp
N-39°08'-W
-3.207%
Fill to Cut Transition
Standard Underdrain Gradient
673+50
600' VC
893.51
JAY RICHFORD
Proj. F-No. 031-2(1)
Sheet 19 of 109

10