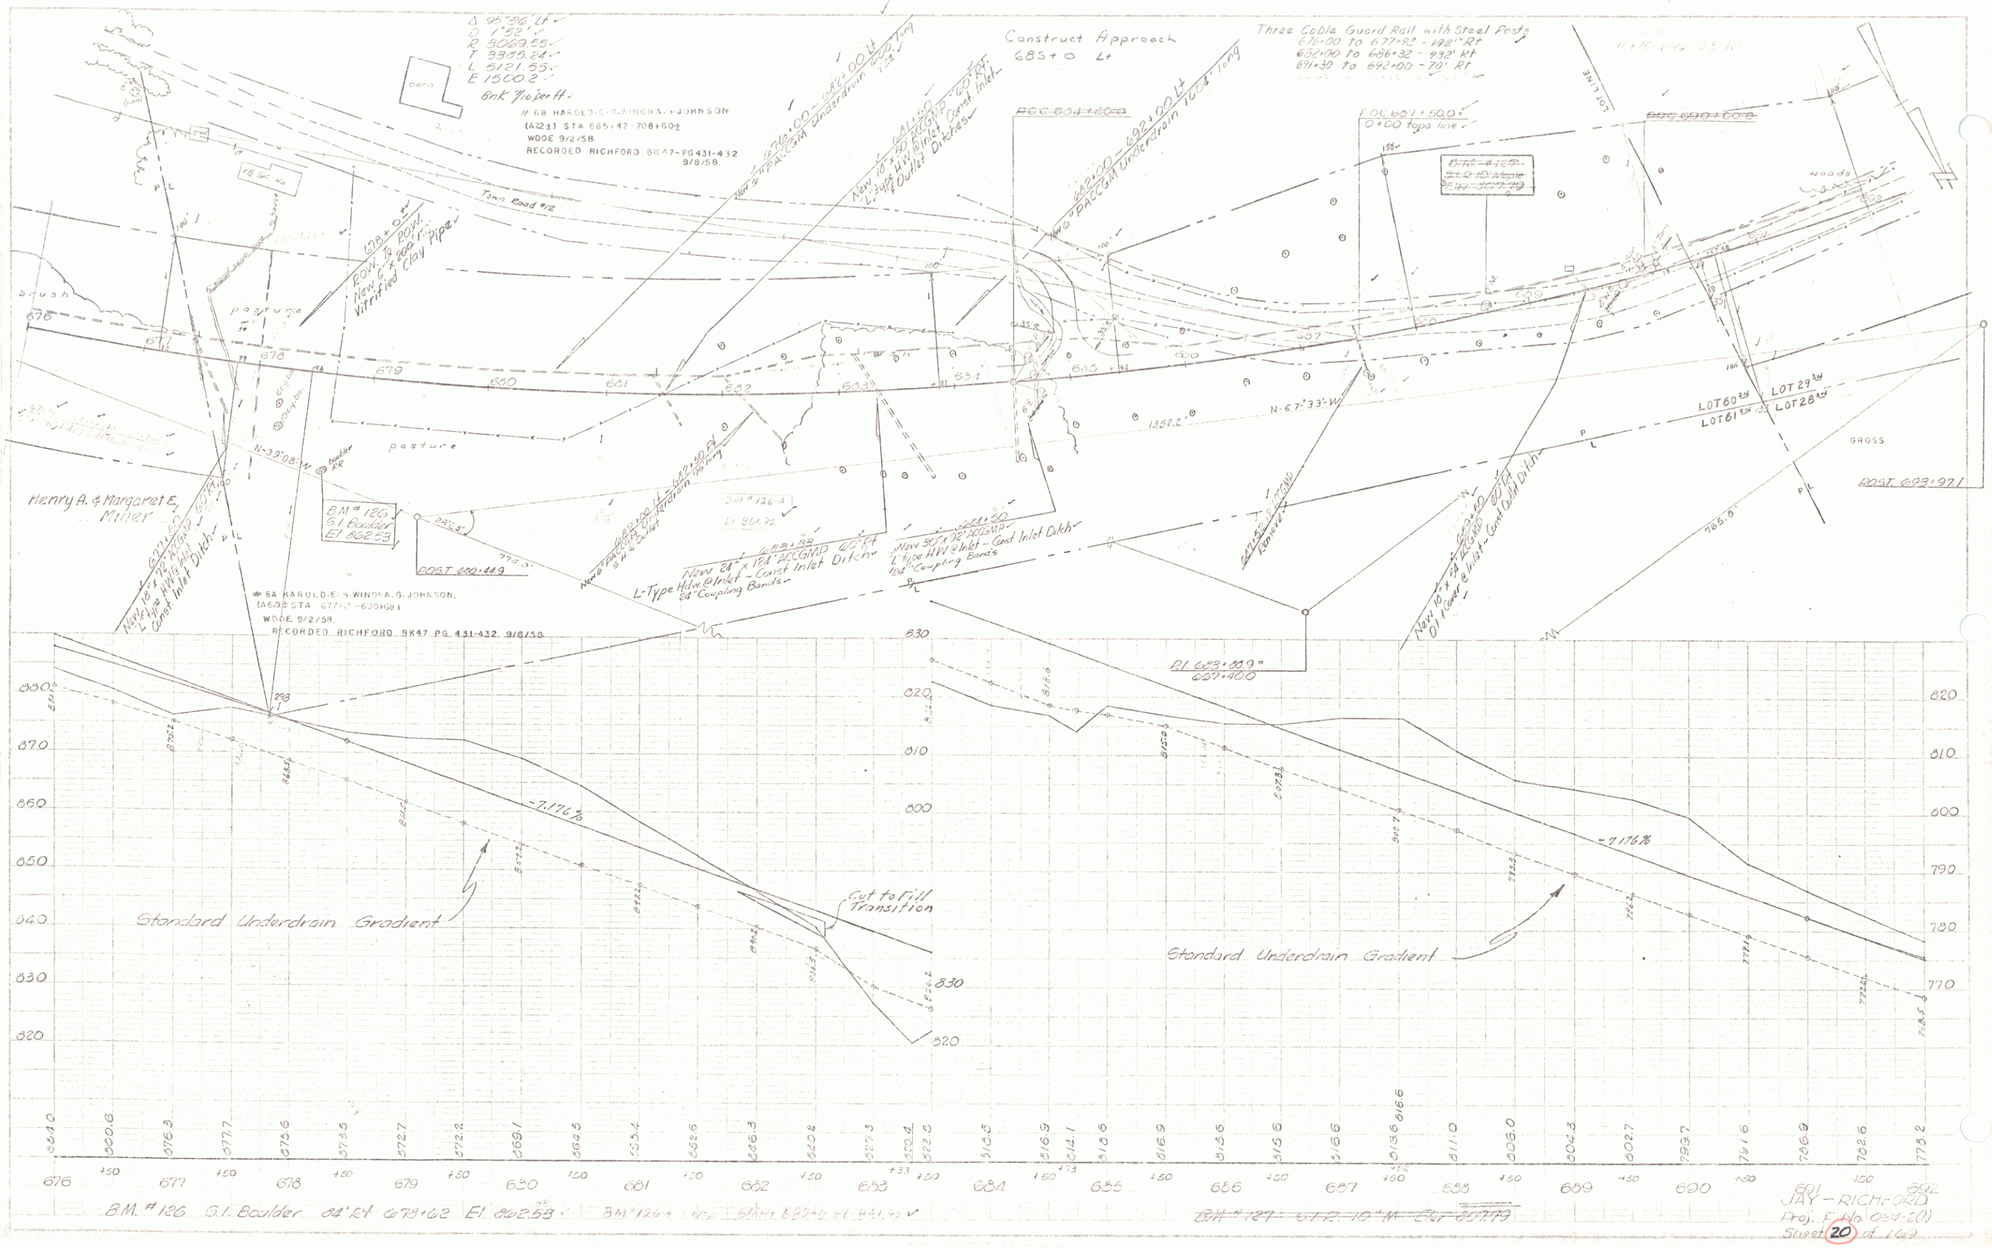
Construct Approach
685+0 Lt
Three Cable Guard Rail with Steel Posts
676+00 to 677+83 - 182' Rt
652+00 to 656+32 - 432' Rt
691+30 to 692+00 - 70' Rt
Town Road #12
Henry A. & Margaret E. Miner
pasture
woods
GRASS
Standard Underdrain Gradient
Cut to Fill Transition
-7.176%
B.M. #126 S.I. Boulder 84' Rt 678+62 El 802.53
JAY - RICHFORD
Proj. F No. 0514-2(1)
Sheet 20 of 143

11