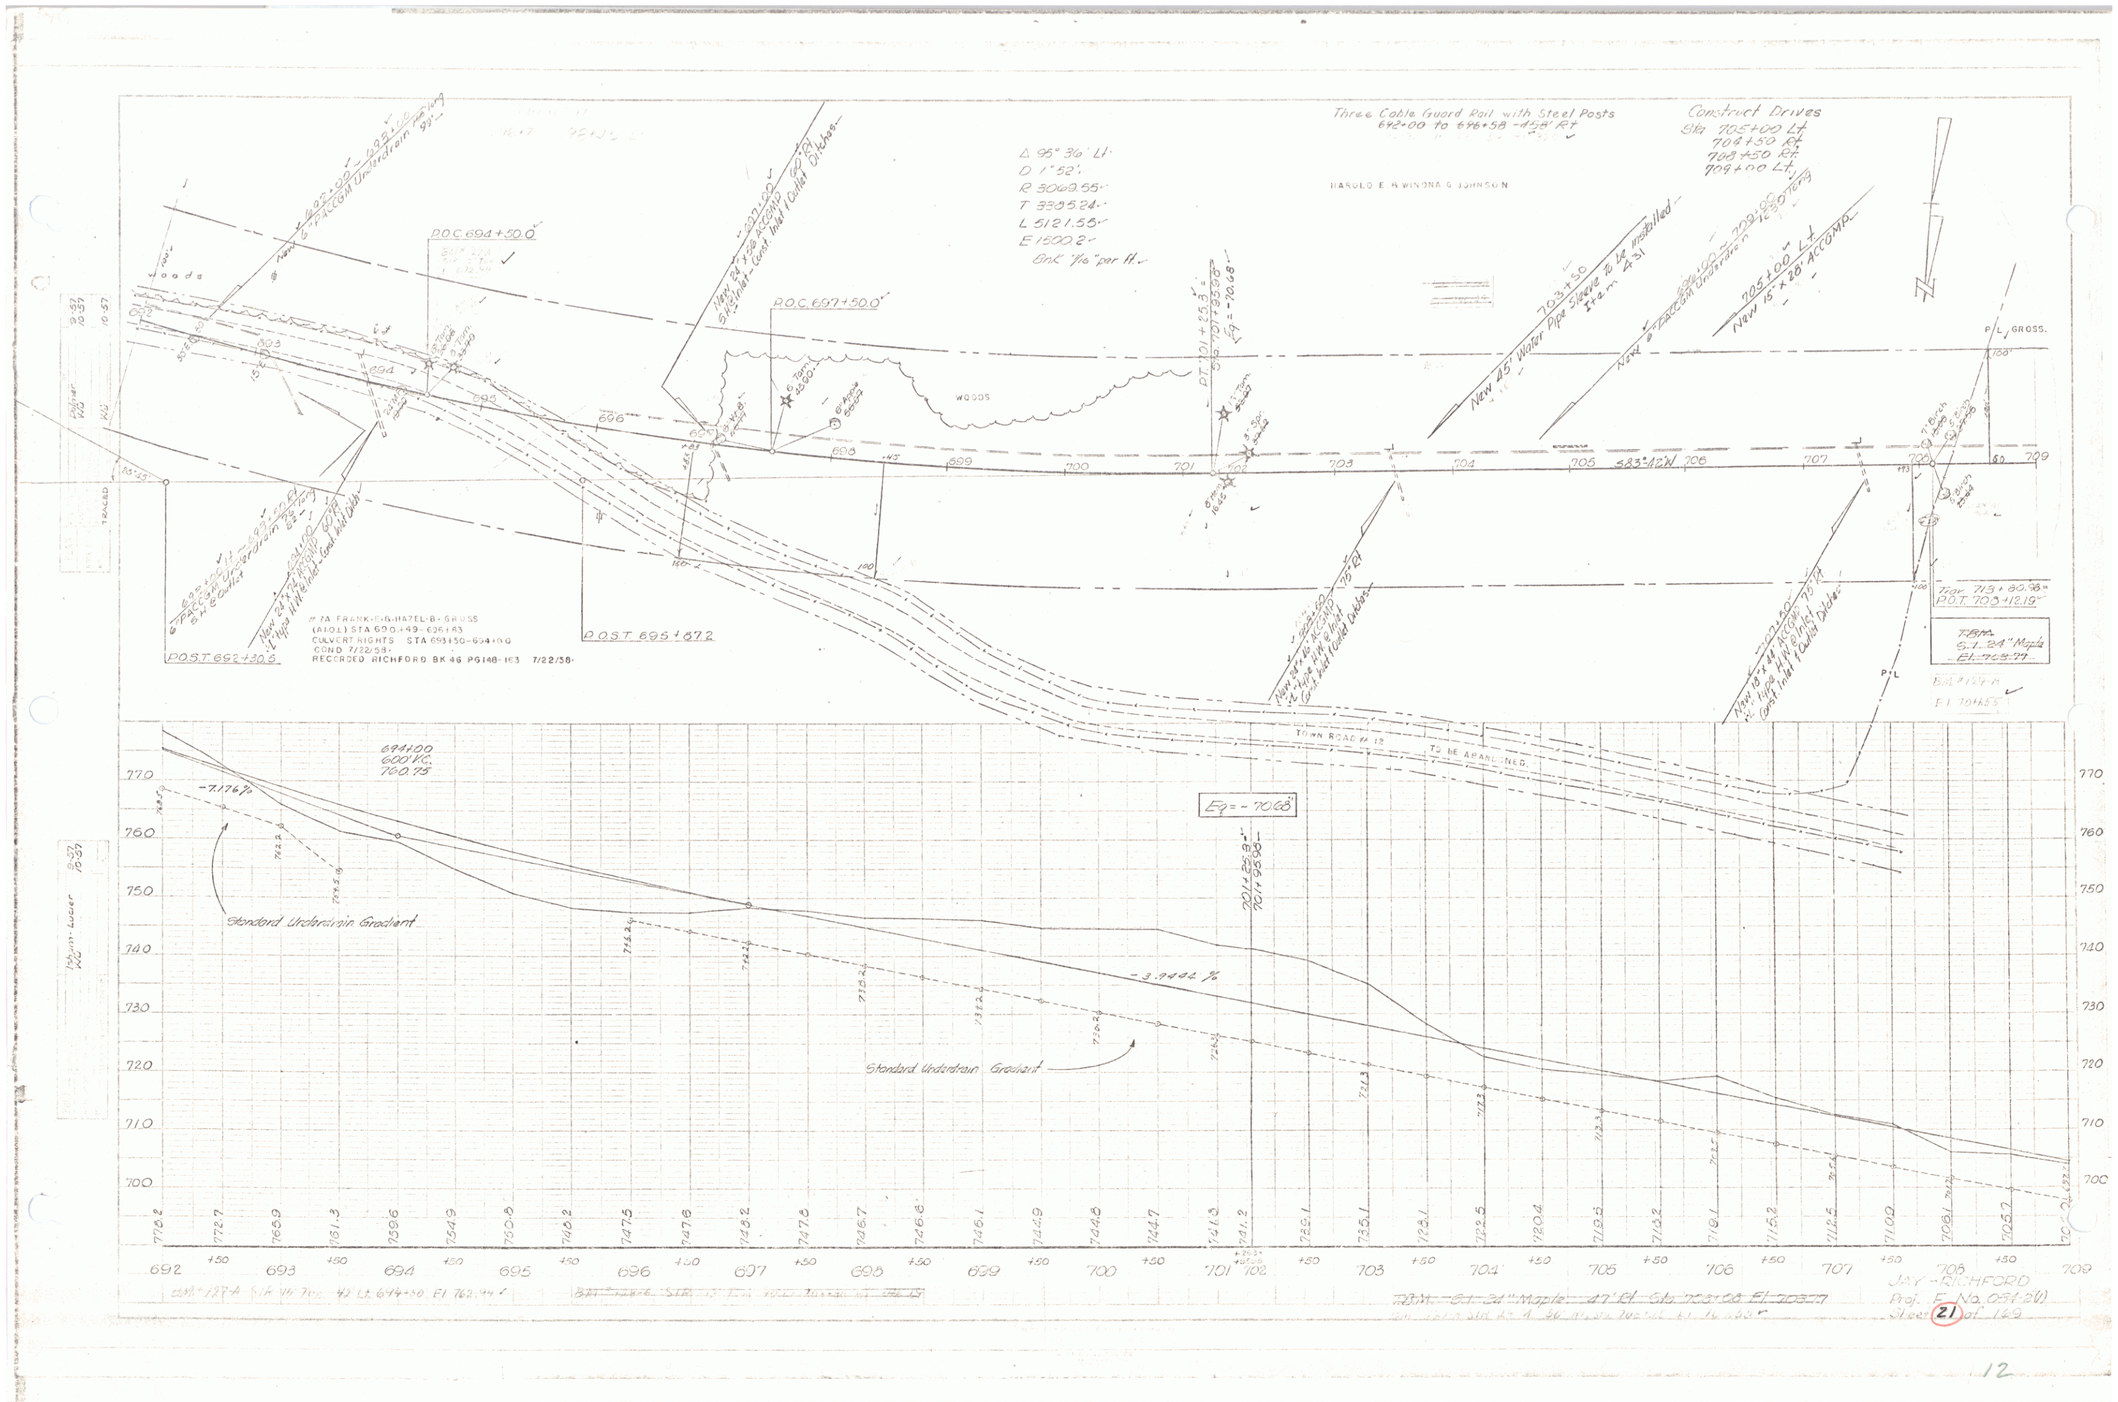
Three Cable Guard Rail with Steel Posts
Construct Drives
Sta 705+00 Lt
706+50 Rt
708+50 Rt
709+00 Lt
Δ 95° 36' Lt
D 1° 52'
R 3069.55'
Brk 1/16" per ft.
HAROLD E. & WINONA G. JOHNSON
P.O.C. 694+50.0'
P.O.C. 697+50.0'
P.O.S.T. 692+30.5
P.O.S.T. 695+87.2
P.O.S.T. 703+12.19'
New 45" Water Pipe Sleeve to be installed
New 15" x 20' ACCOMD.
New 24" x 20' ACCOMD.
S83°42'W
WOODS
P/L GROSS.
TOWN ROAD #13
TO BE ABANDONED
Eq = -70.68'
Standard Underdrain Gradient
-7.1764%
-3.9442%
694+00
600' V.C.
760.75
#7A FRANK-E.&-HAZEL-B.-GROSS
(A101.) STA 690+49-696+83
CULVERT RIGHTS STA 693+50-694+00
COND 7/22/58.
RECORDED RICHFORD BK 46 PG148-163 7/22/58.
JAY - RICHFORD
Proj. F No. 051-2(1)
Sheet 21 of 149
12