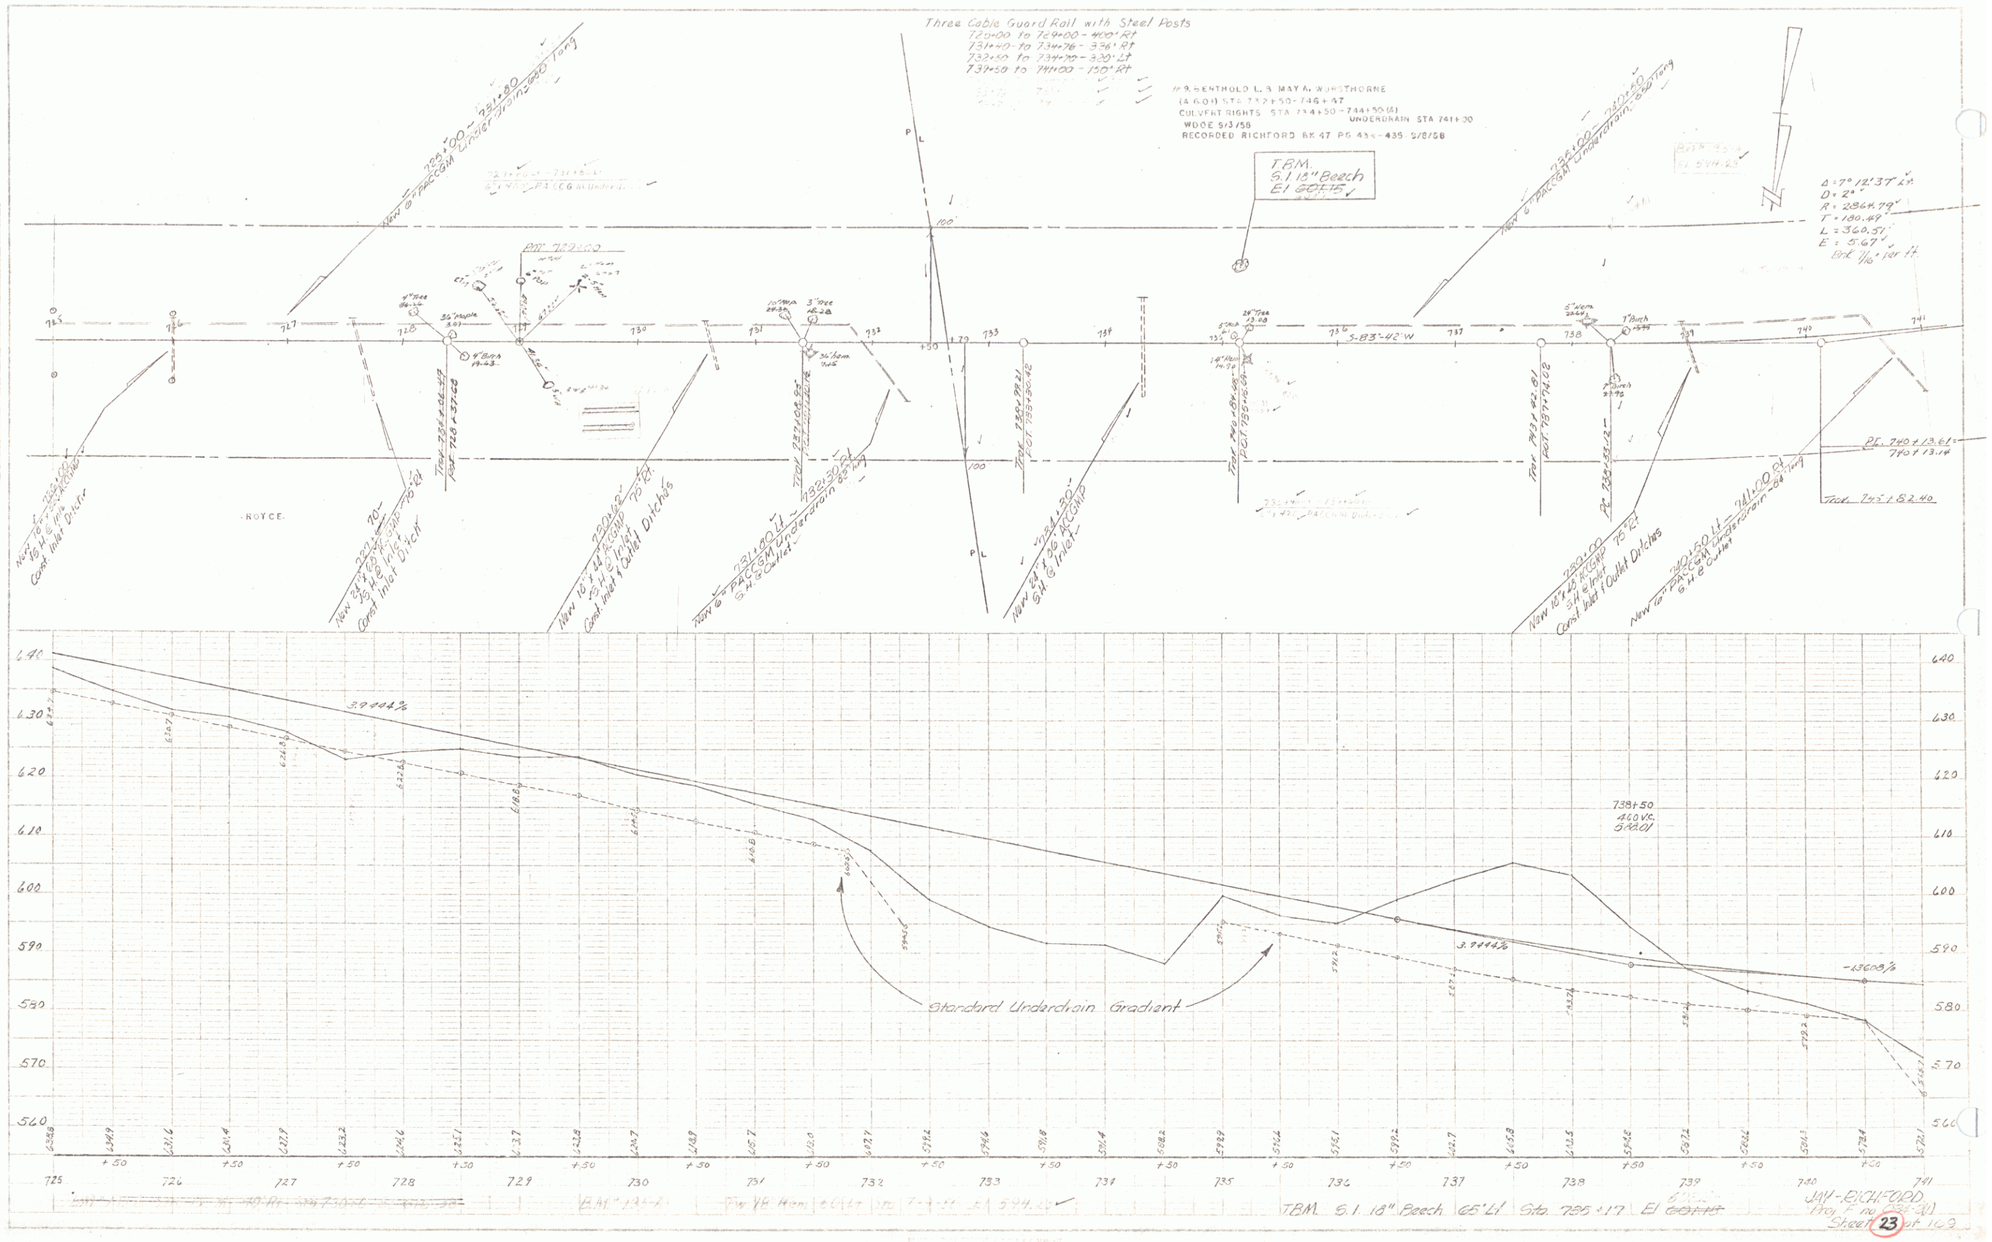
Three Cable Guard Rail with Steel Posts
729+00 to 729+00 - 400' Rt
731+40 to 734+76 - 336' Rt
732+50 to 734+70 - 320' Lt
737+50 to 741+00 - 150' Rt
Δ = 7° 12' 37" Lt
D = 2°
R = 2864.79'
T = 180.49'
L = 360.51'
E = 5.67'
Vert 1/16" = 1 ft
T.B.M.
5.1 18" Beech
El 60.15
S-83°-42'-W
PT. 740+13.61
740+13.14
Top. 745+82.40
Standard Underdrain Gradient
738+50
460 V.C.
5.92.01
3.944%
-1.3608%
TBM 5.1 18" Beech 65' Lt Sta 735+17 El 60.15
JAY-BICH-FORD
Sheet 23 of 109