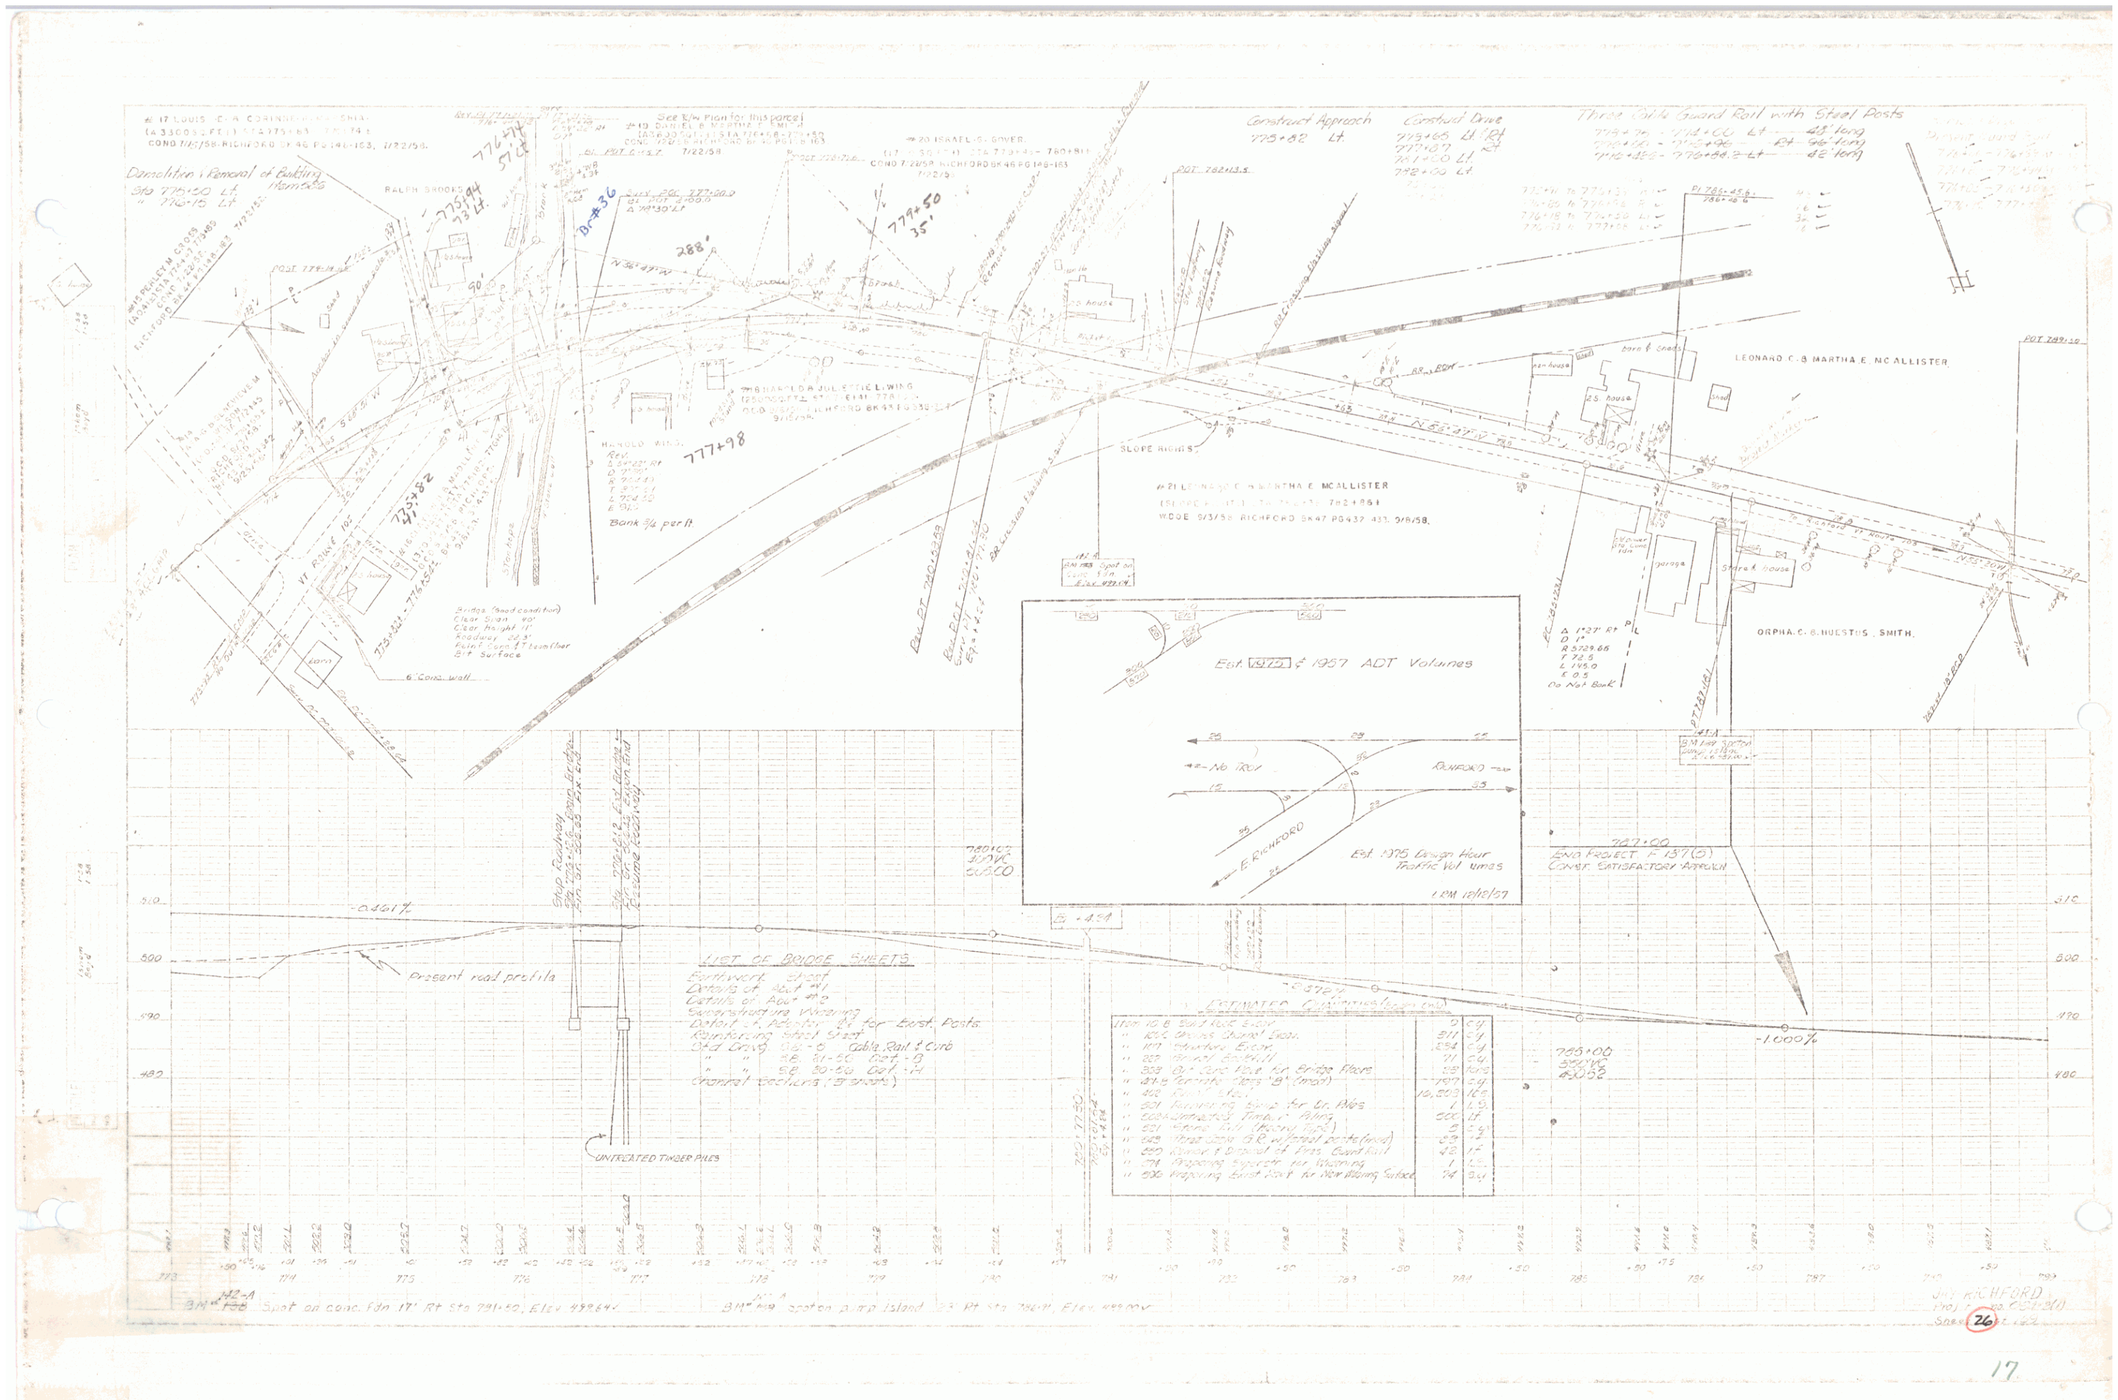
Construct Approach
Construct Drive
Three Cable Guard Rail with Steel Posts
Demolition & Removal of Building
LEONARD C. & MARTHA E. McALLISTER
ORPHA C. & HUESTIS SMITH
SLOPE RIGHTS
Est. 1957 ADT Volumes
Est. 1975 Design Hour Traffic Volumes
END PROJECT F 137(3)
CONST. SATISFACTORY APPROVED
Present road profile
LIST OF BRIDGE SHEETS
ESTIMATED QUANTITIES
UNTREATED TIMBER PILES
JAY RICHFORD