| FED. ROAD DIST. NO. | STATE | PROJ. NO. | FISCAL YEAR | SHEET NO. | TOTAL SHEETS |
|---|---|---|---|---|---|
| 9 | VT. | | | | |

| Parcel | Instrument | Date | Grantor | Grantee | Recorded | Book | Page | Date | Remarks |
|---|---|---|---|---|---|---|---|---|---|
| # 3 | W.D.O.E. | 8-30-41 | Blair Veneer Co | St. of Vt. | Jay | 13 | 257-8 | 10-24-41 | See NS-FAP 137 C(1) 1942 |
| # 2B | W.D.O.E. | 8-25-41 | Arthur A. Lahar | St. of Vt. | Jay | 13 | 258-9 | 10-24-41 | " " " " |

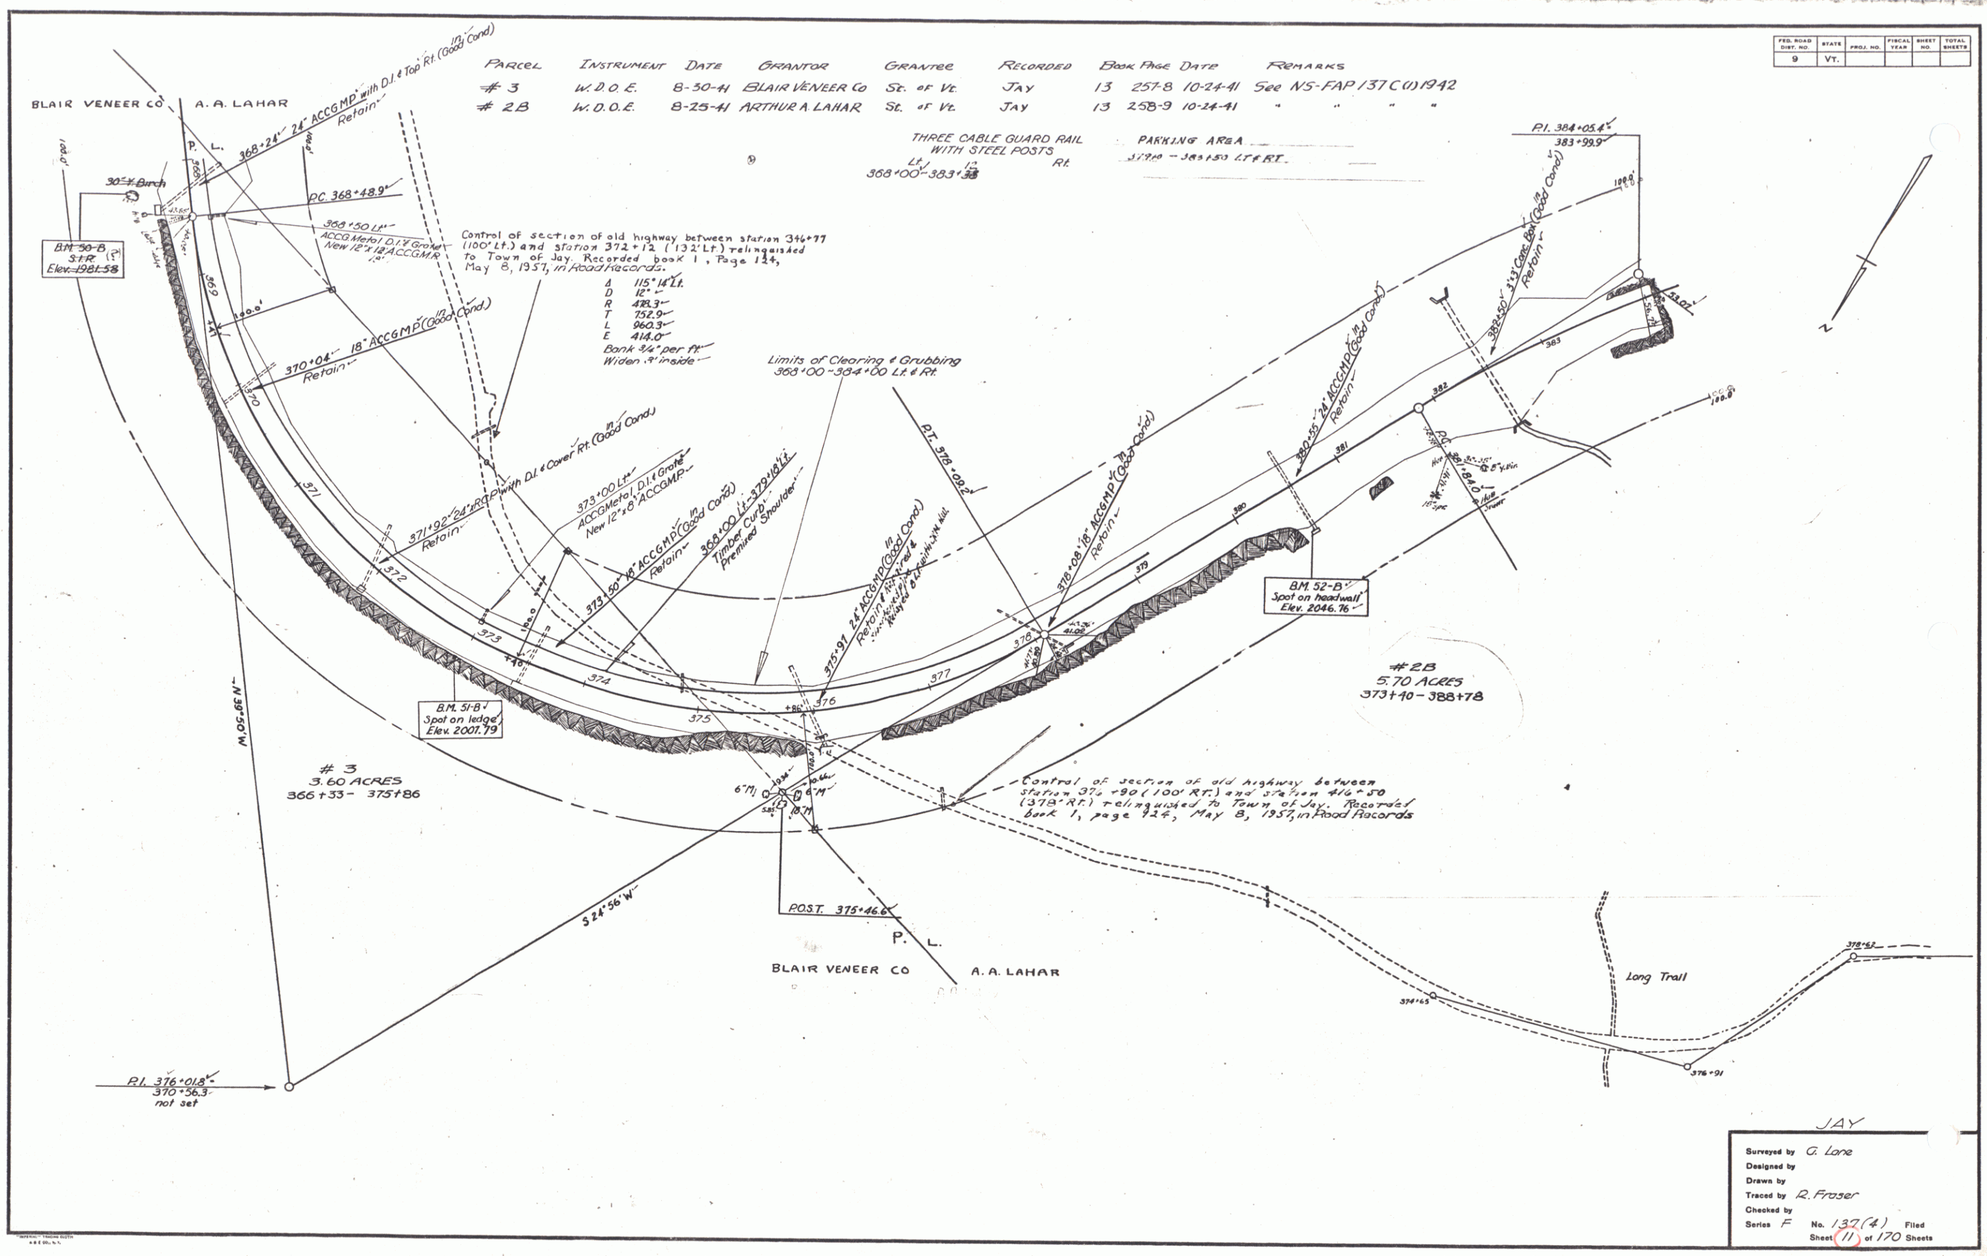


4