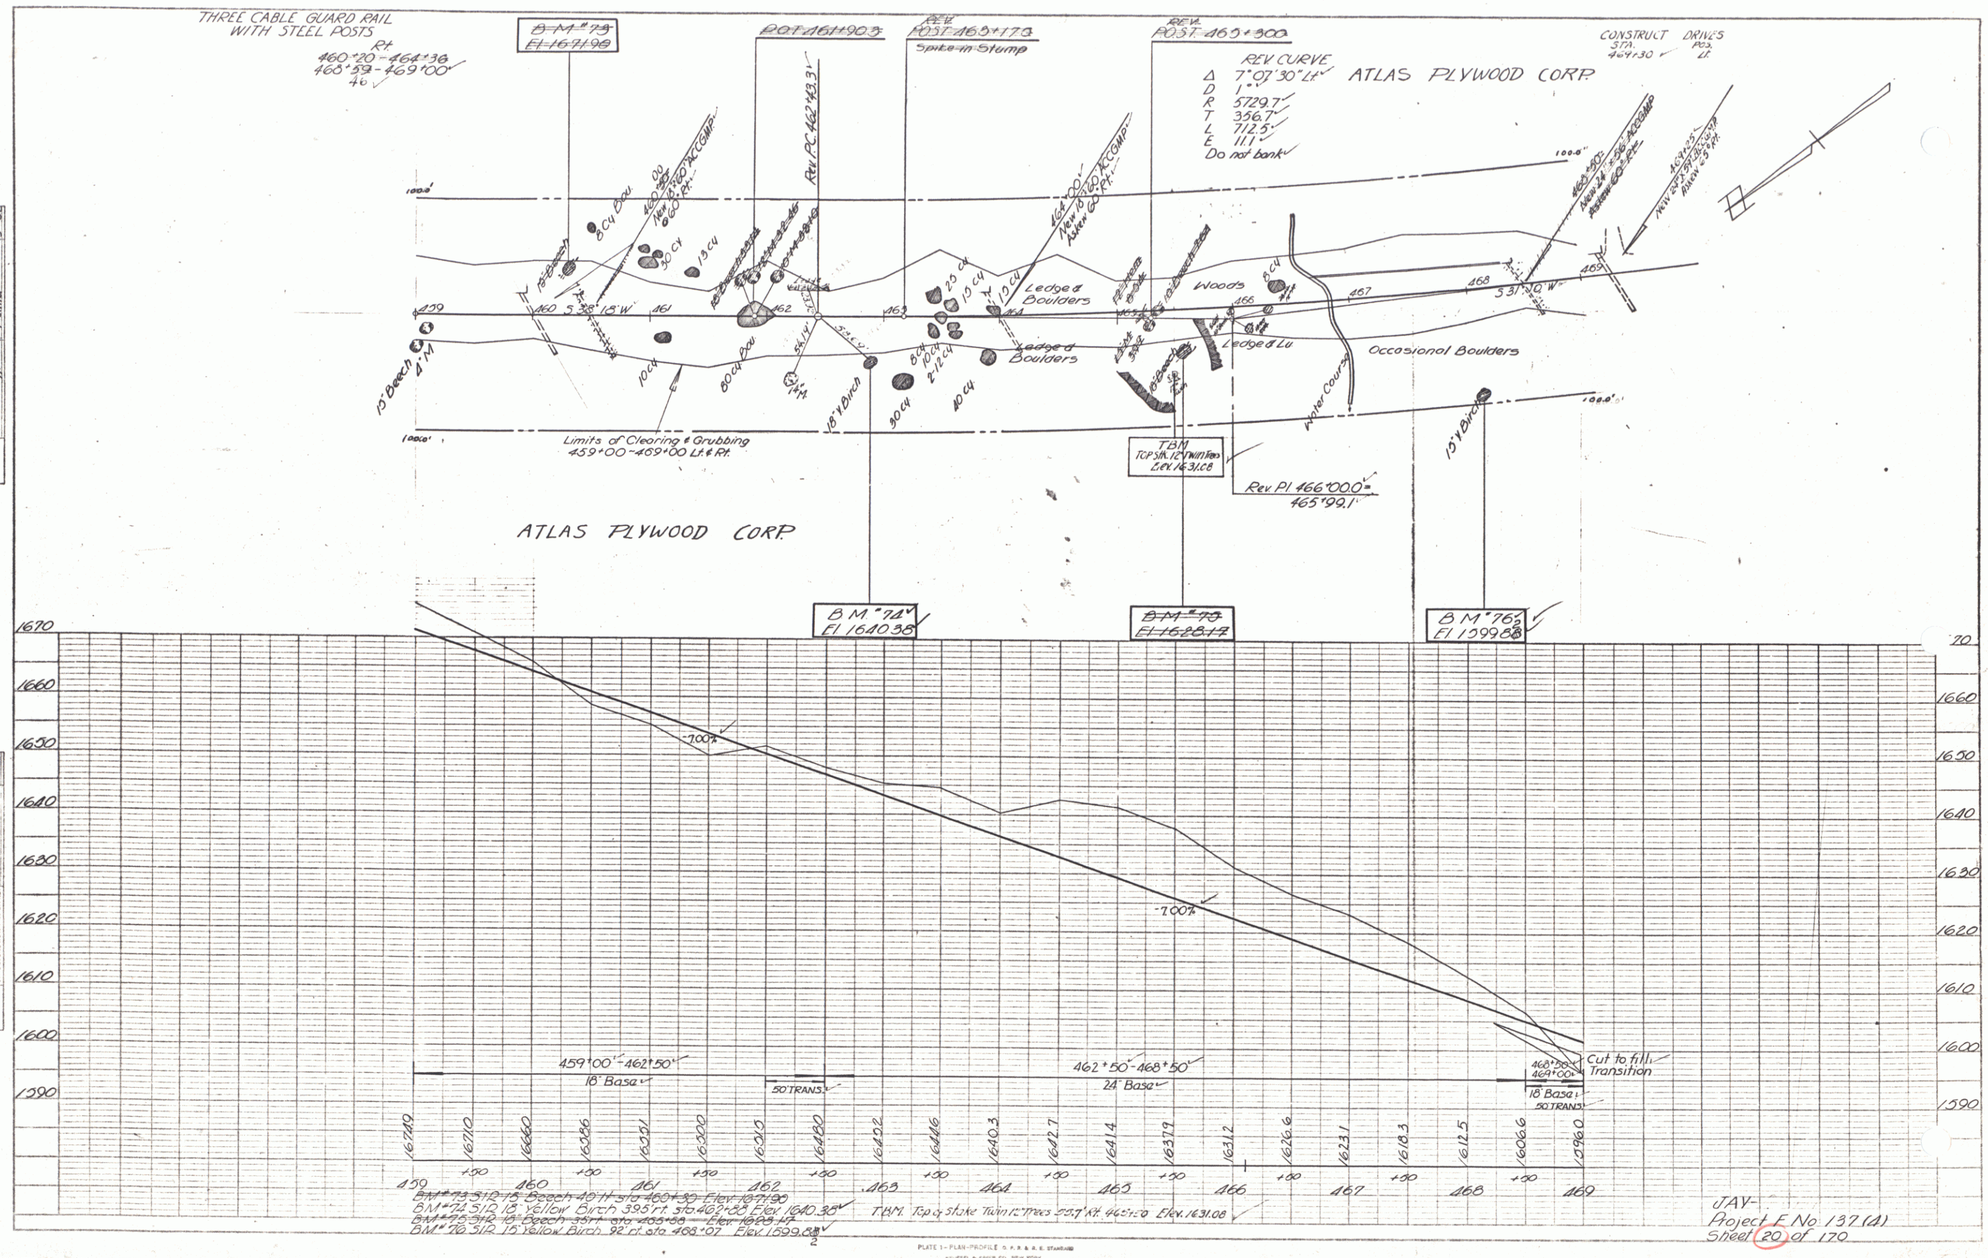

JAY-
Project E No 137 (A)
Sheet 20 of 170

10