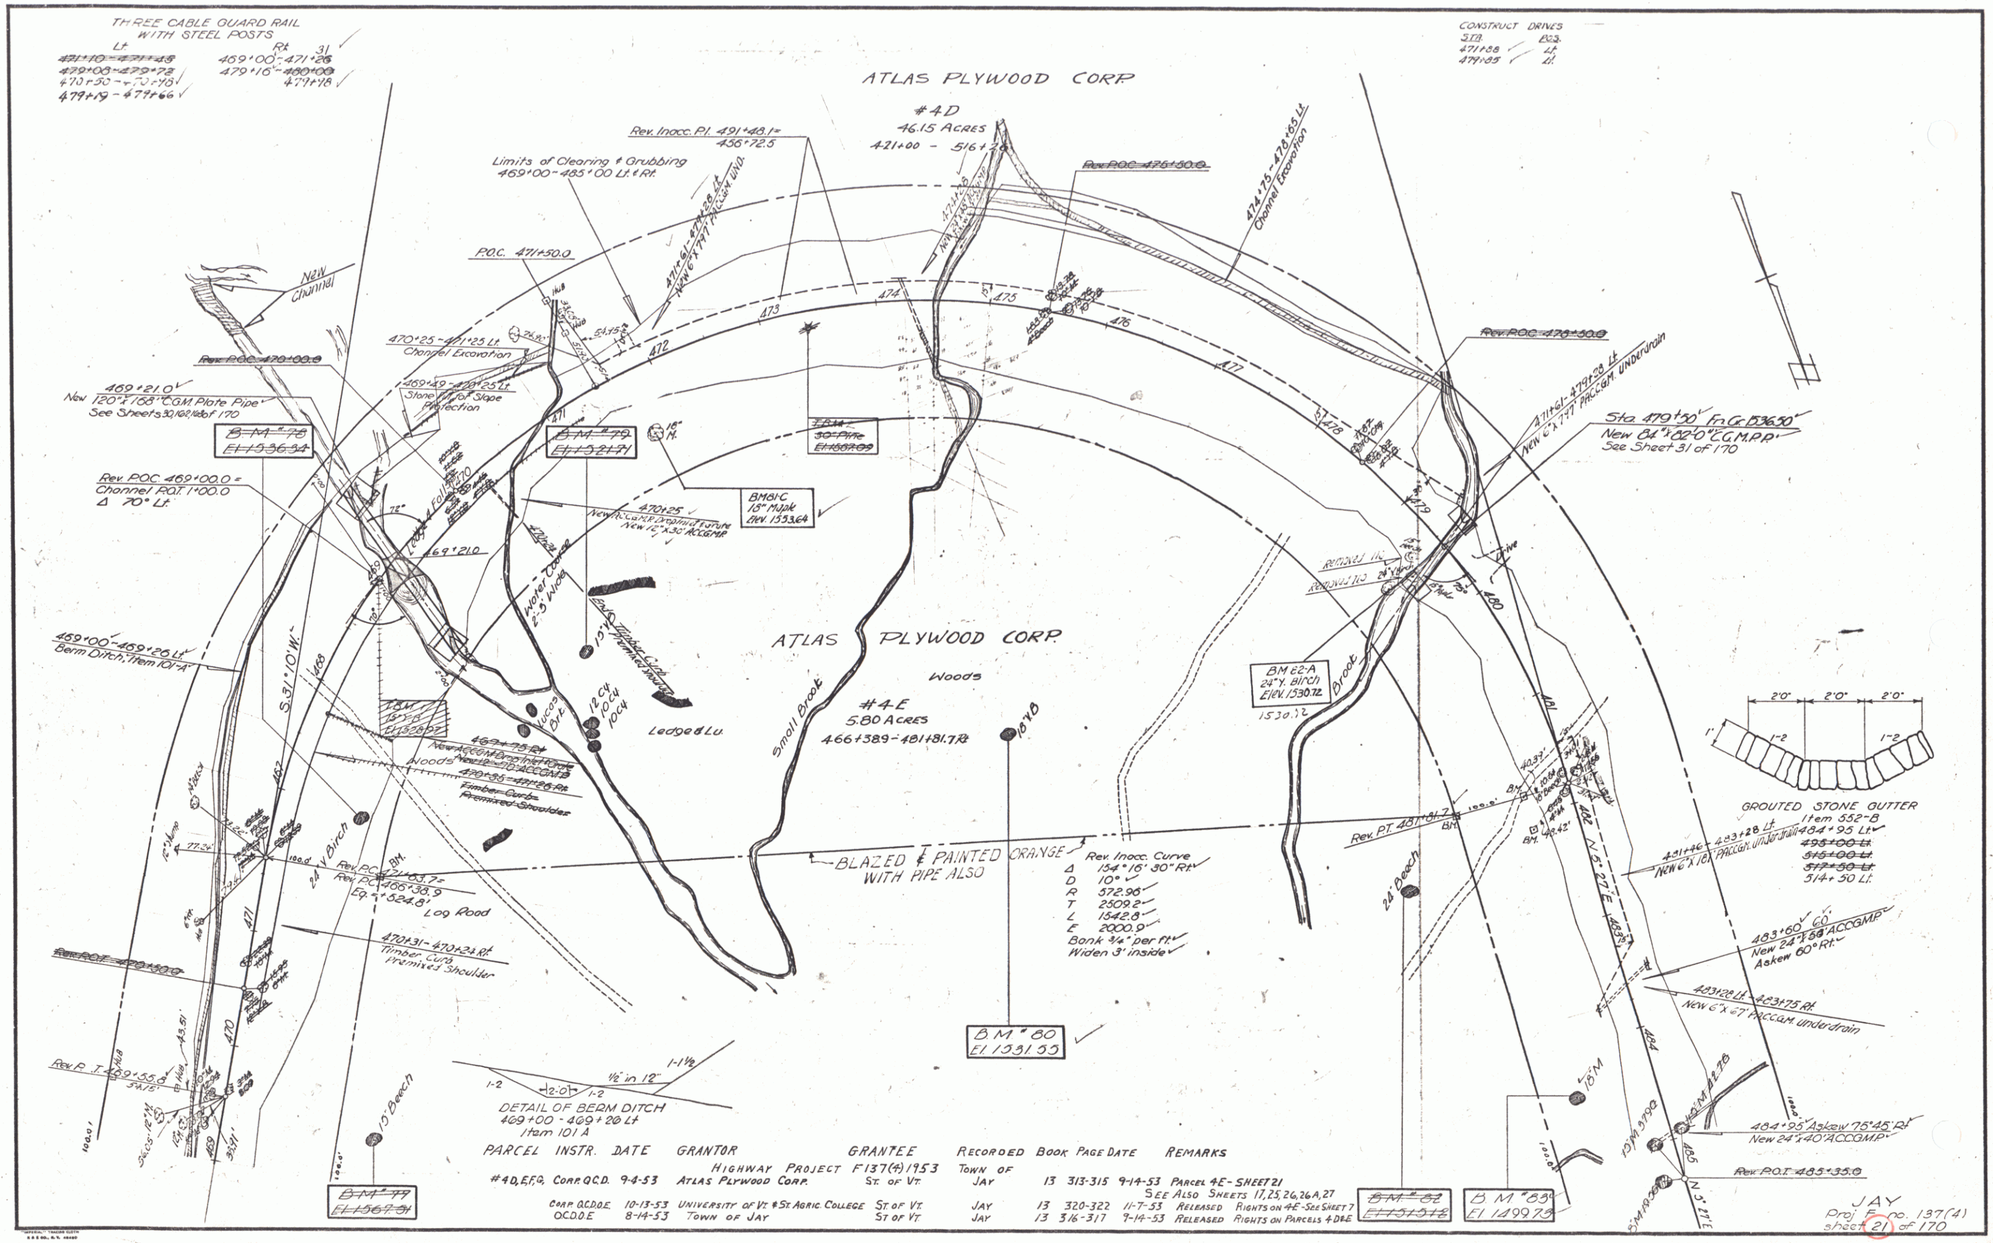
THREE CABLE GUARD RAIL WITH STEEL POSTS
Lt. Rt.
31
469+00-471+26
479+16-480+08
477+18
CONSTRUCT DRIVES
STA. BOS.
471+88 Lt.
479+85 Lt.
ATLAS PLYWOOD CORP.
#4D
46.15 ACRES
421+00 - 516+
Rev. Inacc. Pl. 491+48.1=
456+72.5
Limits of Clearing & Grubbing
469+00-485+00 Lt. & Rt.
P.O.C. 471+50.0
New Channel
470+25-471+25 Lt.
Channel Excavation
469+49-470+25 Lt.
Stone Riprap Slope Protection
469+21.0
New 120" x 168" CGM Plate Pipe
See Sheets 30/168 & of 170
Rev. POC 469+00.0 =
Channel R.O.T. 1+00.0
Δ 70° Lt.
469+21.0
469+00-469+20 Lt.
Berm Ditch, Item 101-A
Log Road
Small Brook
Ledge & Lu
Woods
#4E
5.80 ACRES
466+38.9-481+81.7 Rt.
BLAZED & PAINTED ORANGE
WITH PIPE ALSO
Rev. Inacc. Curve
Δ 154° 16' 30" Rt.
D 10°
R 572.96'
T 250.92'
L 1542.8'
E 2000.9'
Bank 3/4" per ft.
Widen 3' inside
BM 80
El 1391.93
BM 22-A
24" Y. Birch
Elev. 1530.72
1530.72
Rev. PT 481+81.7
N 61° 27' E
474+15-476+85 Lt.
Channel Excavation
Rev. POC 476+50.0
Rev. POC 478+50.0
Sta. 479+50 Fr. Gr. 1536.50
New 84" x 80'-0" CGMPP
See Sheet 31 of 170
GROUTED STONE GUTTER
Item 552-B
484+95 Lt.
483+60 60'
New 24" x 59' ACCGMP
Askew 60° Rt.
484+95 Askew 75°45' Rt.
New 24" x 40' ACCGMP
Rev. P.O.T. 485+35.0
N 3° 27' E
DETAIL OF BERM DITCH
469+00 - 469+20 Lt.
Item 101 A
PARCEL INSTR. DATE GRANTOR GRANTEE RECORDED BOOK PAGE DATE REMARKS
HIGHWAY PROJECT F137(4)1953 TOWN OF JAY
#4D, E, F, G. Corp. Q.C.D. 9-4-53 ATLAS PLYWOOD CORP. ST. OF VT. JAY 13 313-315 9-14-53 PARCEL 4E-SHEET 21
SEE ALSO SHEETS 17, 25, 26, 26A, 27
Corp. Q.C.D.E. 10-13-53 UNIVERSITY OF VT. & ST. AGRIC. COLLEGE ST. OF VT. JAY 13 320-322 11-7-53 RELEASED RIGHTS ON 4E-SEE SHEET 7
Q.C.D.E. 8-14-53 TOWN OF JAY ST. OF VT. JAY 13 316-317 9-14-53 RELEASED RIGHTS ON PARCELS 4D&E
BM 89
El 1499.73
JAY
Proj. F no. 137(4)
sheet 21 of 170