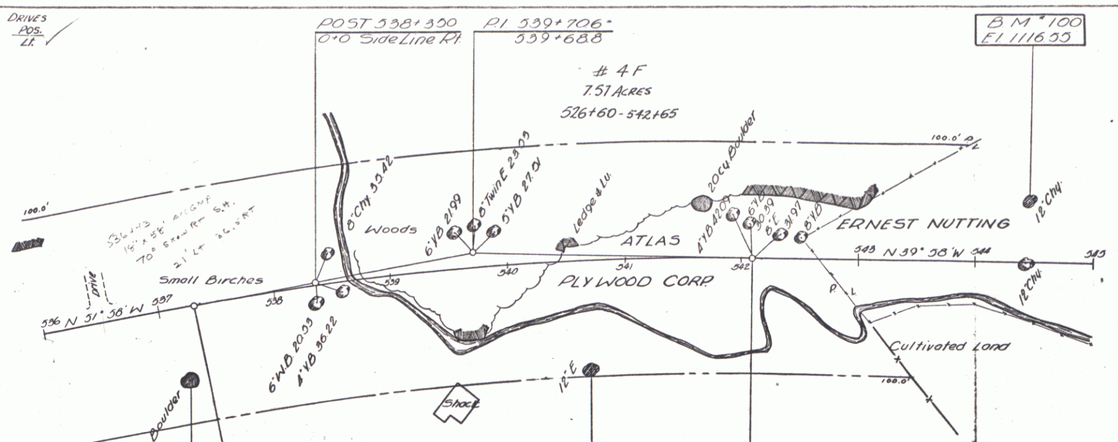

Parcel	Instr.	Date	Grantor	Grantee	Recorded	Book	Page	Date	Remarks
			Highway	Project	F-137(4) 1953				
#4I of A,D,E,F,G	Corp. Q.C.D.	9-3-53	Atlas Plywood Corp.	St. of Vt.	Jay	13	313-315	9-14-53	Parcel 4F Sheets 26
									See also Sheets 17,21,25
#5A of 5A,B	Q.C.D.O.E.	8-26-53	Edward Nutting	St. of Vt.	Jay	13	318-319	9-14-53	Parcel 5A Sheets 26
									See also Sheets 26A,2
	Corp. Q.C.D.O.E	10-13-53	University of Vt. & St. Agric. College	St. of Vt.	Jay	13	320-322	11-7-53	Released Rights on Parts of #D, #4E
									See Sheets 7 & 21

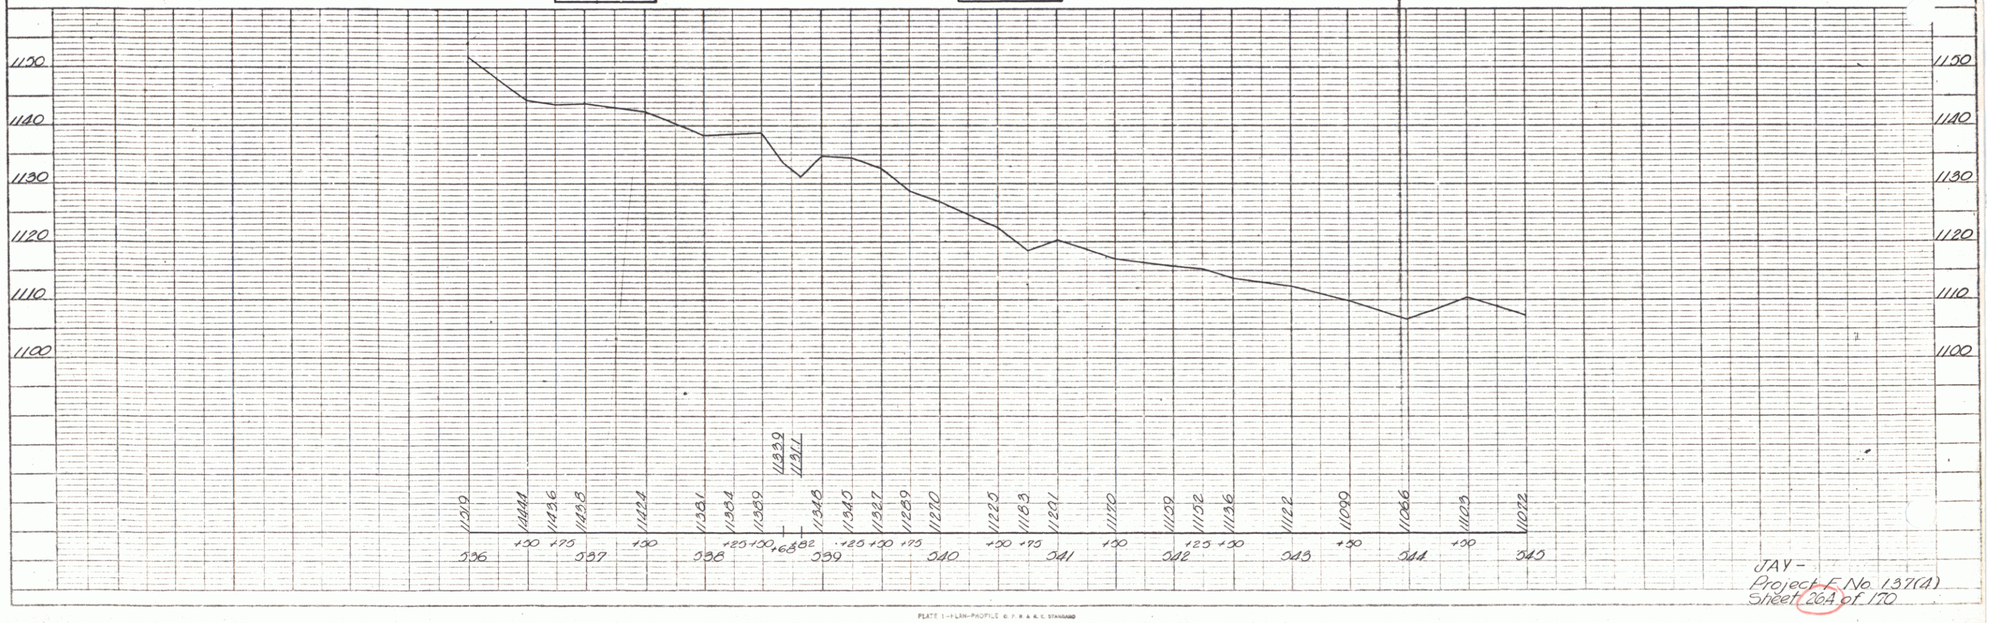

JAY -
Project F No. 137(4)
Sheet 26A of 170

PLATE 1 - PLAN-PROFILE C. P. R. & R. C. STANDARD
REQ. FEL & ESSEX CO., NEW YORK
R.E.E. Co. No. 3486-1E

16