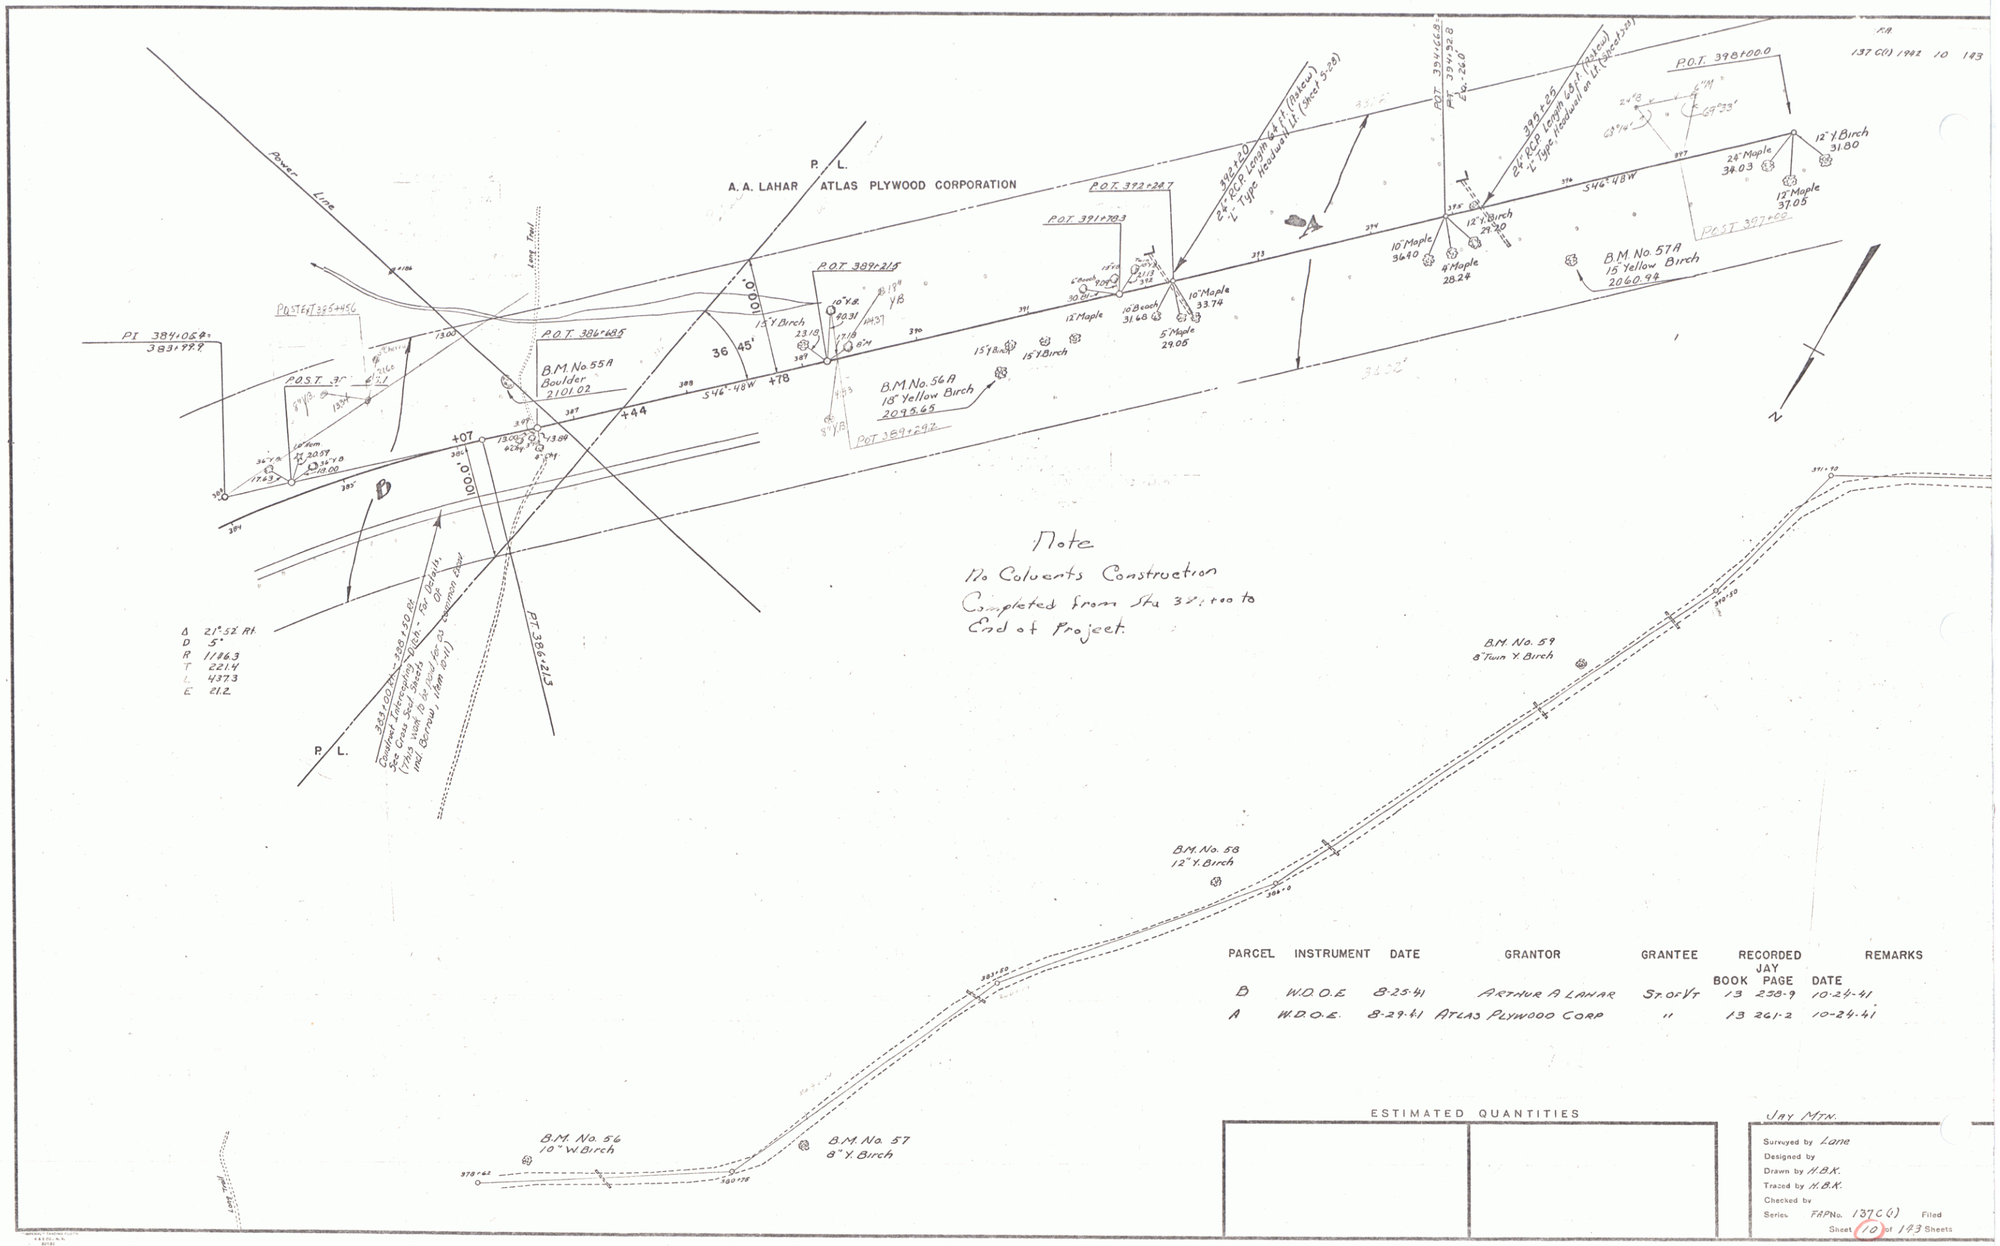

PARCEL	INSTRUMENT	DATE	GRANTOR	GRANTEE	RECORDED JAY BOOK	PAGE	DATE	REMARKS
B	W.D.O.E	8-25-41	Arthur A Lahar	St. of Vt	13	258-9	10-24-41	
A	W.D.O.E.	8-29-41	Atlas Plywood Corp	"	13	261-2	10-24-41	

ESTIMATED QUANTITIES

Jay Mtn.

Surveyed by Lane
Designed by
Drawn by H.B.K.
Traced by H.B.K.
Checked by
Series FAPNo. 137 (1) Filed
Sheet 10 of 183 Sheets

6