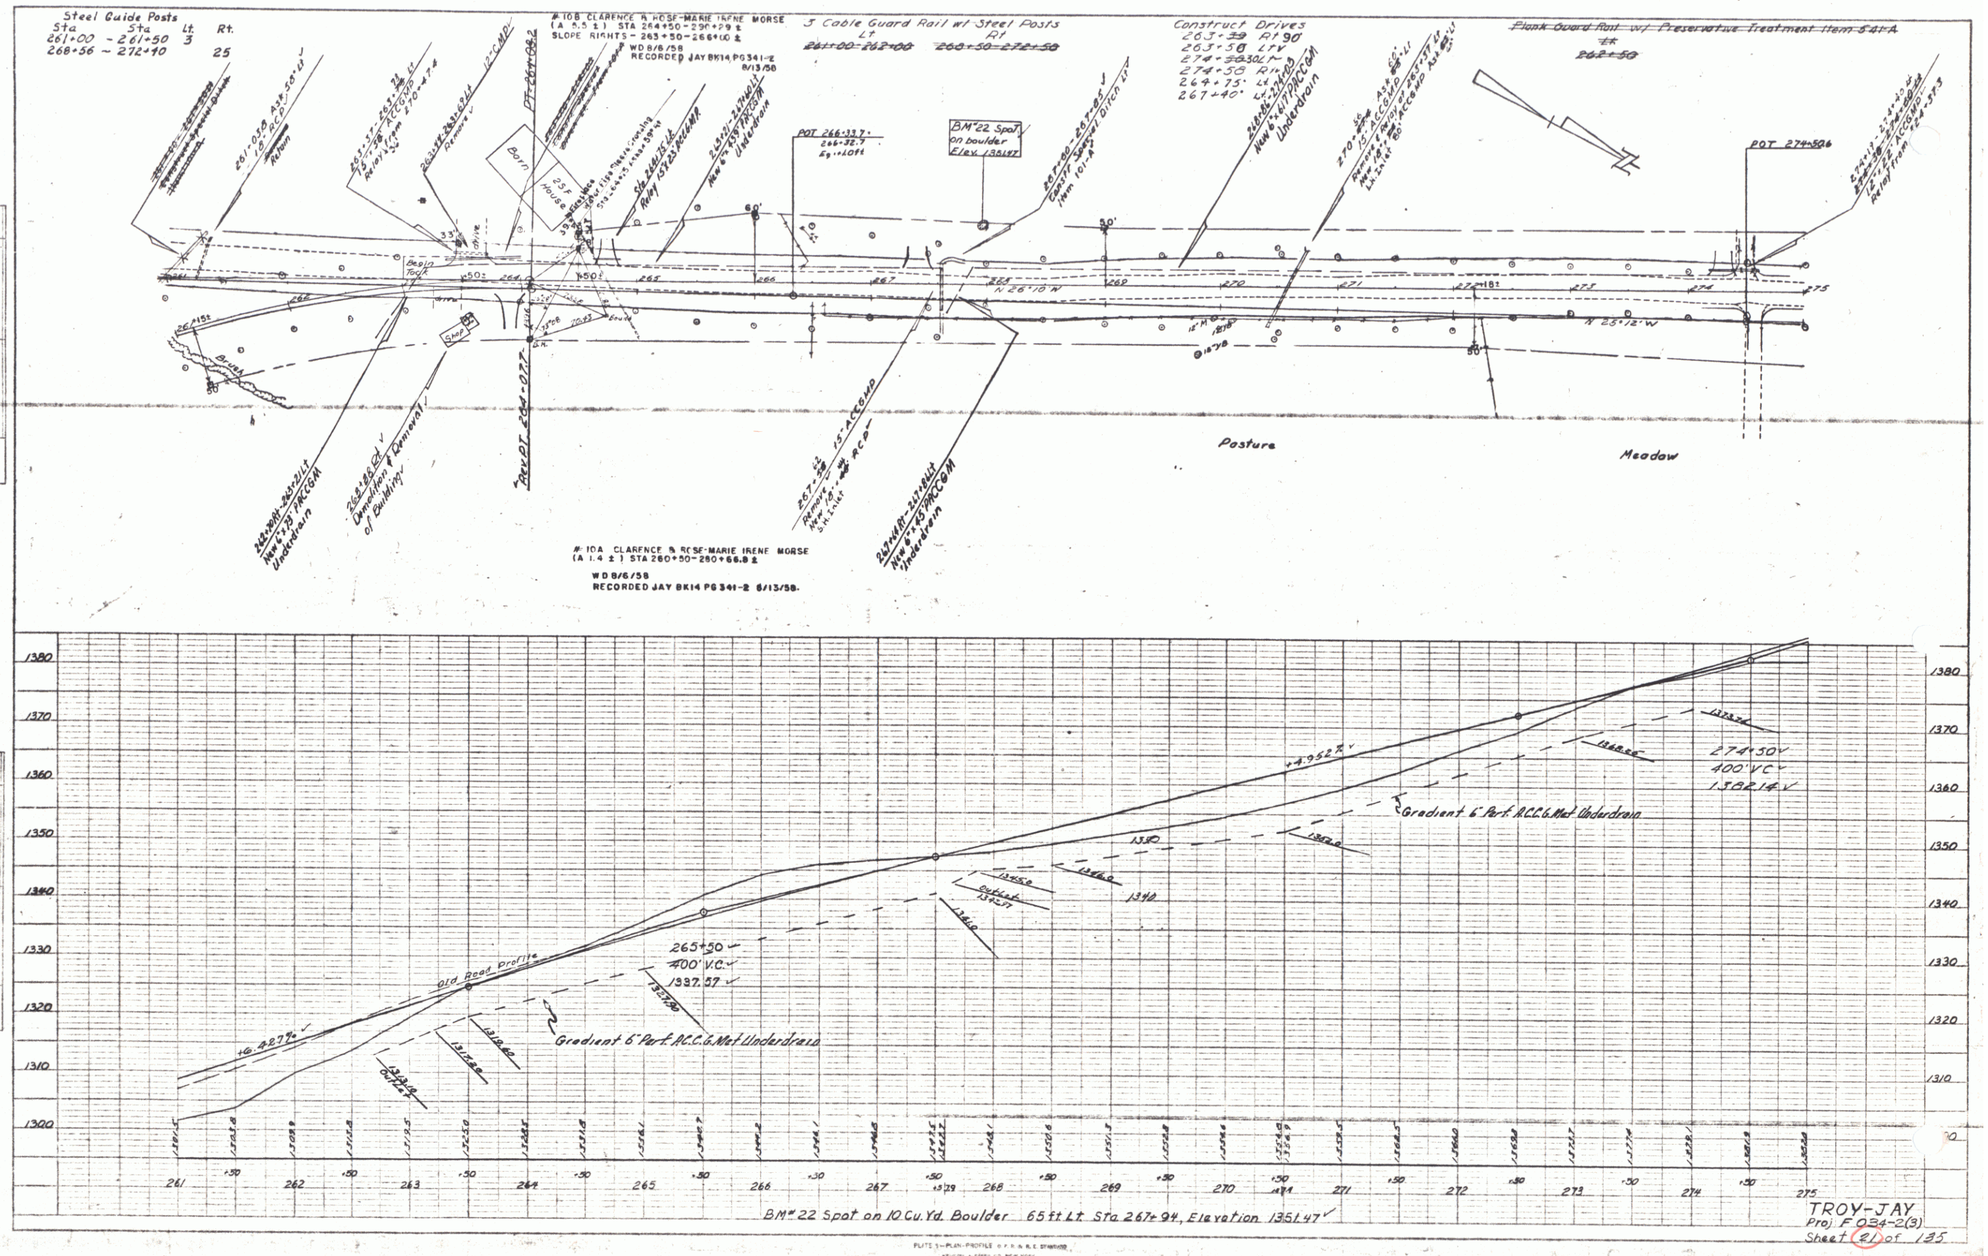

TROY-JAY
Proj F 024-2(3)
Sheet 21 of 135

13