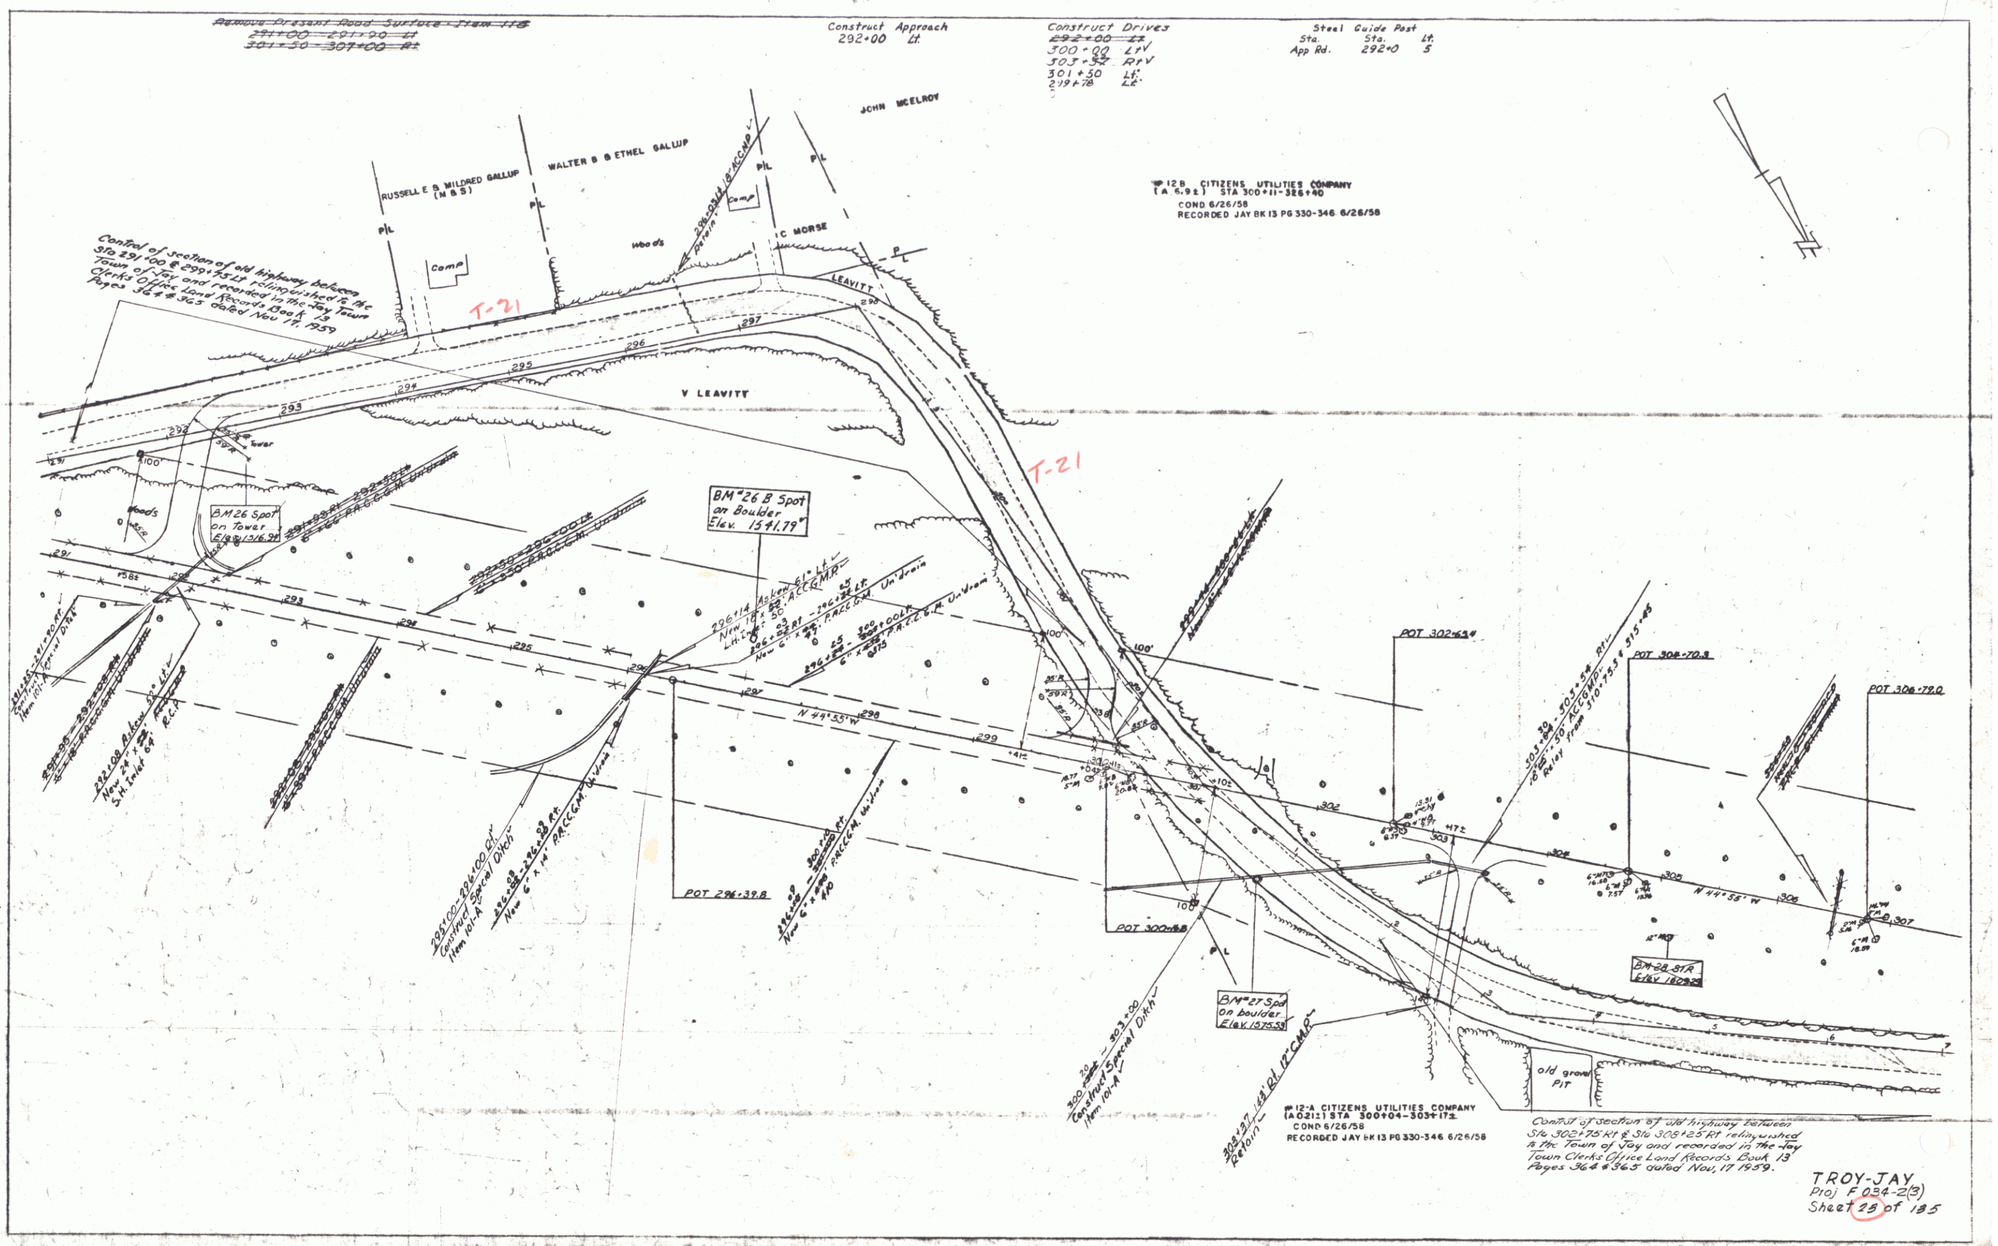
Construct Approach
292+00 Lt.
Construct Drives
300+00 Lt V
303+52 Rt V
301+50 Lt.
299+78 Lt.
Steel Guide Post
Sta. App Rd.
Sta. 292+0
Lt. 5
JOHN MCELROY
RUSSELL E & MILDRED GALLUP (M & S)
WALTER B & ETHEL GALLUP
P/L
Camp
Woods
IC MORSE
LEAVITT
V LEAVITT
T-21
#12 B CITIZENS UTILITIES COMPANY
(A 6.9±) STA 300+11-326+40
COND 6/26/58
RECORDED JAY BK 13 PG 330-346 6/26/58
Control of section of old highway between Sta 291+00 & 299+75 Lt relinquished to the Town of Jay and recorded in the Jay Town Clerk's Office Land Records Book 13 Pages 364 & 365 dated Nov 17, 1959
BM "26 B Spot on Boulder Elev. 1541.79"
BM 26 Spot on Tower Elev 1316.94
POT 296+39.8
POT 300+68
POT 302+63.4
POT 304+70.3
POT 306+79.0
BM 28 STA Elev 1820.25
BM "27 Spot on boulder Elev 1575.55"
old gravel Pit
#12-A CITIZENS UTILITIES COMPANY
(A 0.212) STA 300+04-303+17±
COND 6/26/58
RECORDED JAY BK 13 PG 330-346 6/26/58
Control of section of old highway between Sta 302+75 Rt & Sta 305+25 Rt relinquished to the Town of Jay and recorded in the Jay Town Clerk's Office Land Records Book 13 Pages 364 & 365 dated Nov. 17 1959.
TROY-JAY
Proj F 034-2(3)
Sheet 25 of 185

15