



 NOTE: BOOK DOWNS CHECKED
 11/15/12 JAY

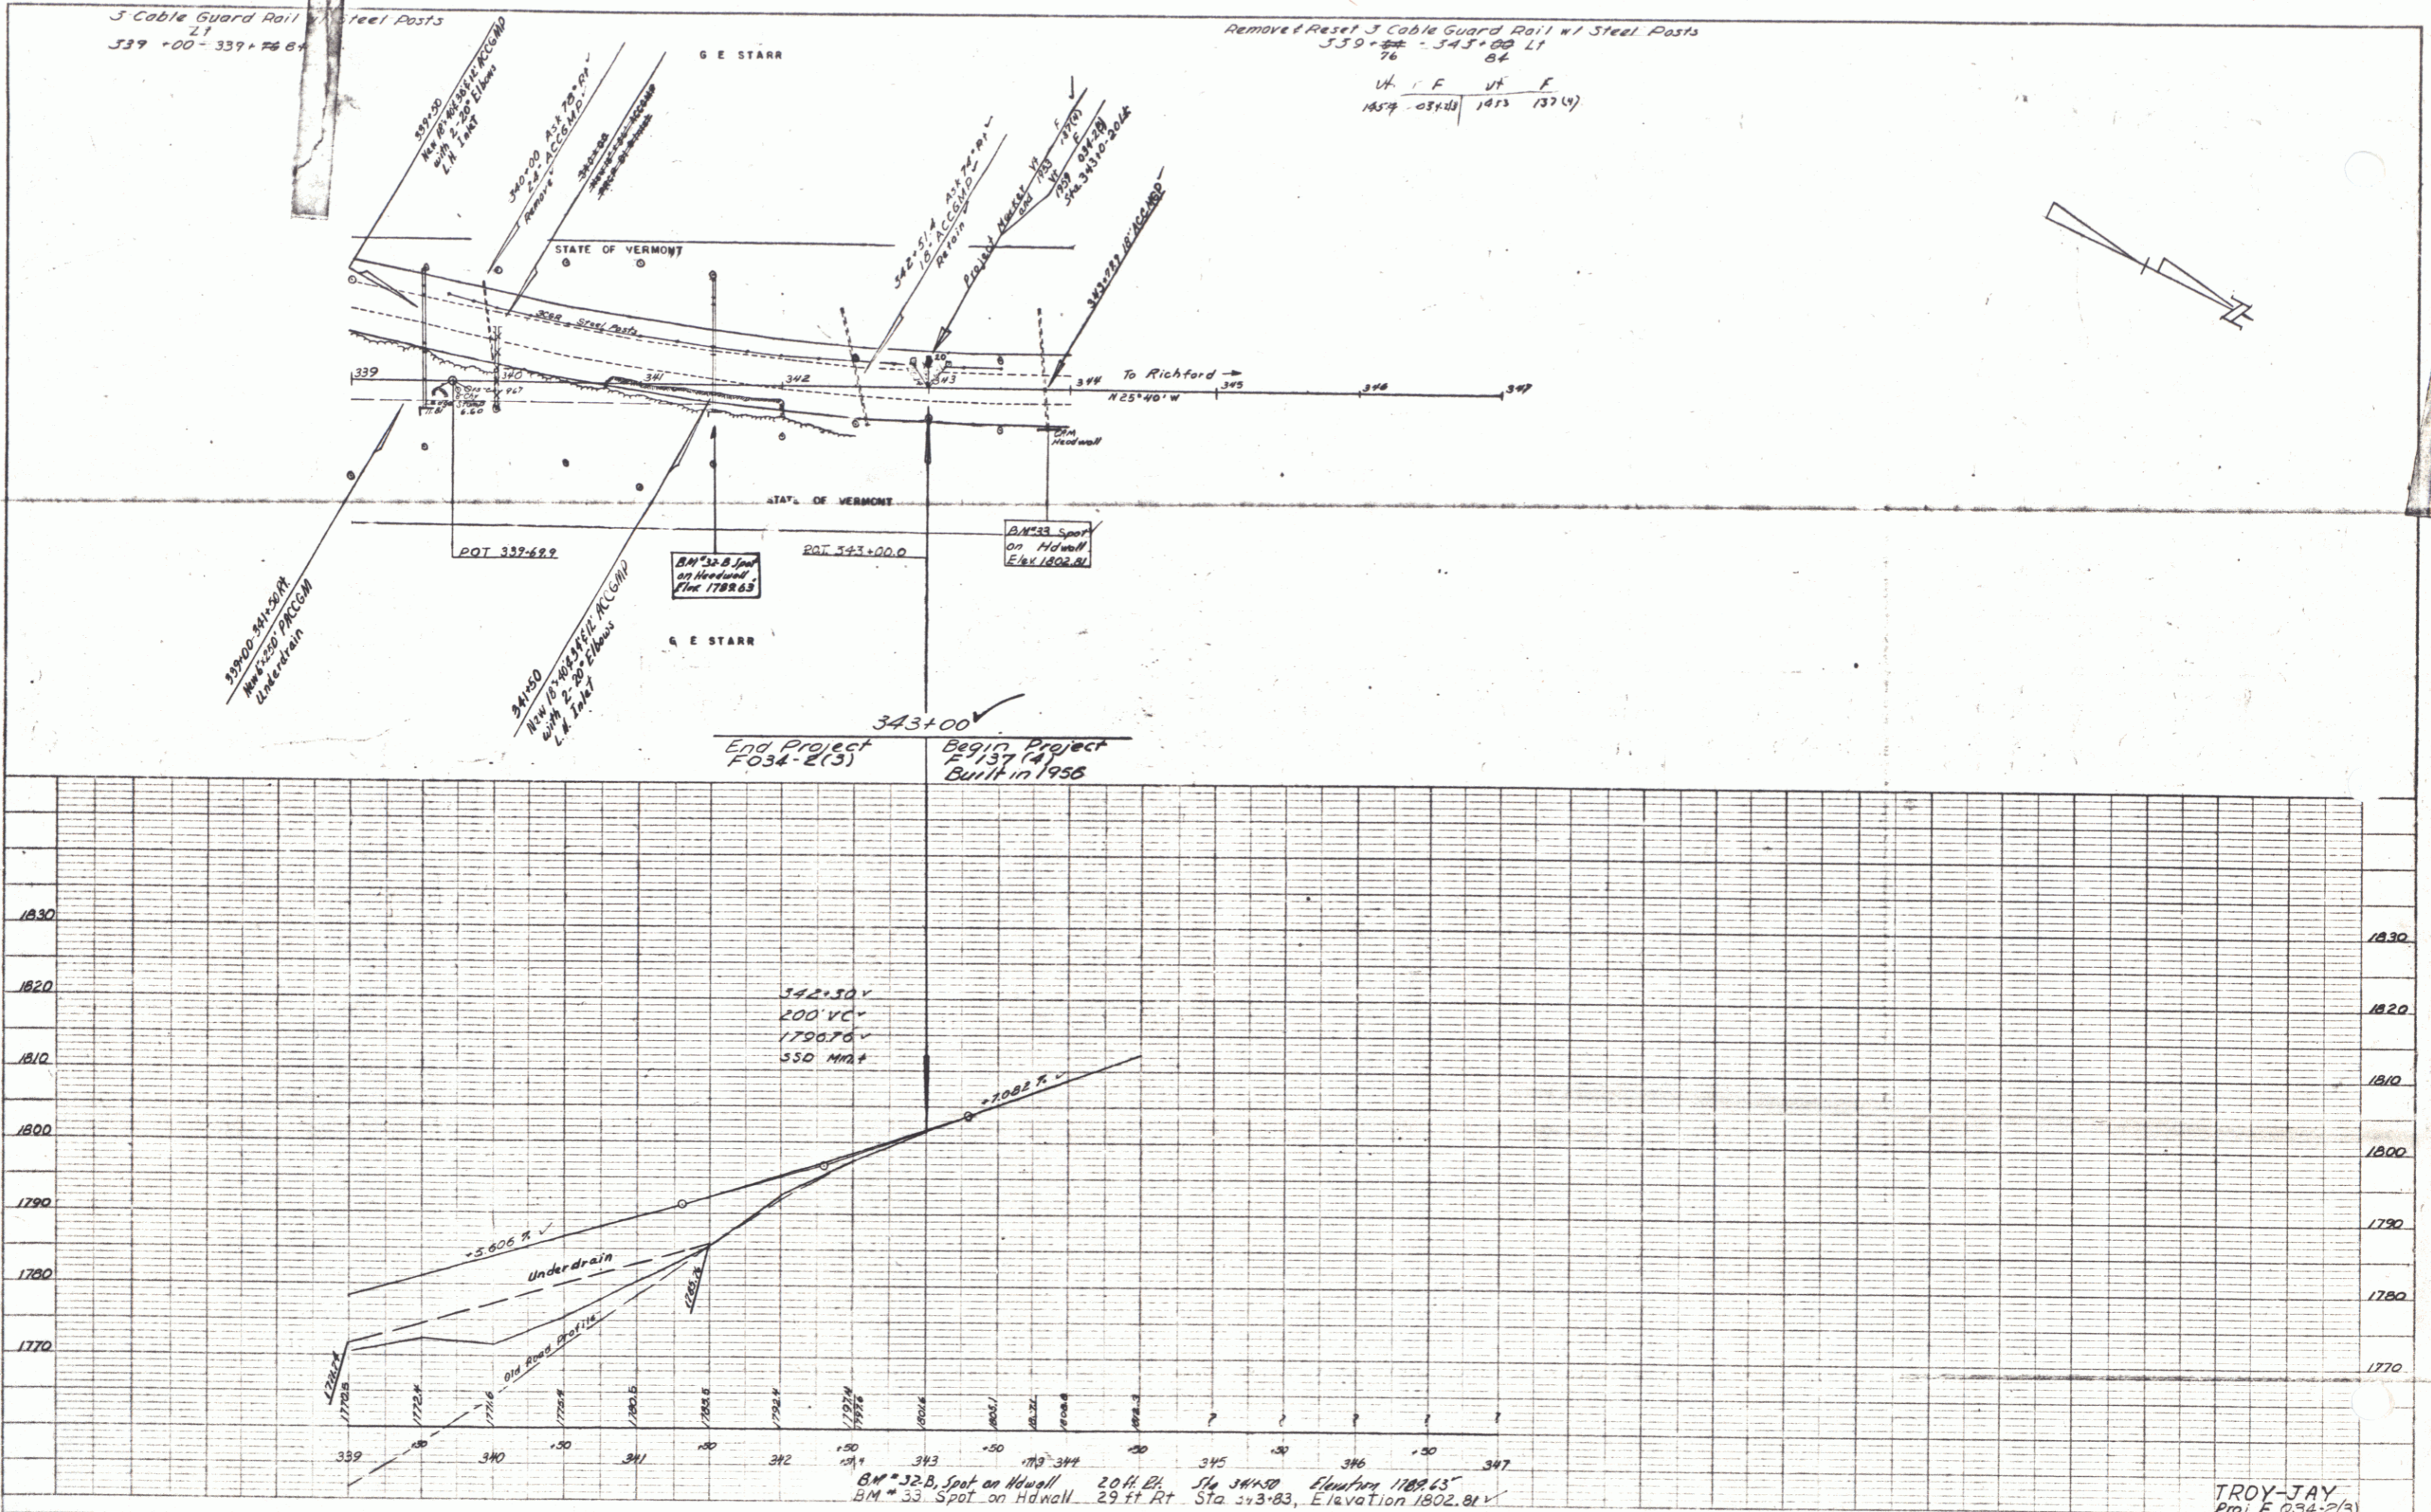

TROY-JAY
 Proj F 034-2(3)
 Sheet 18 of 135

18