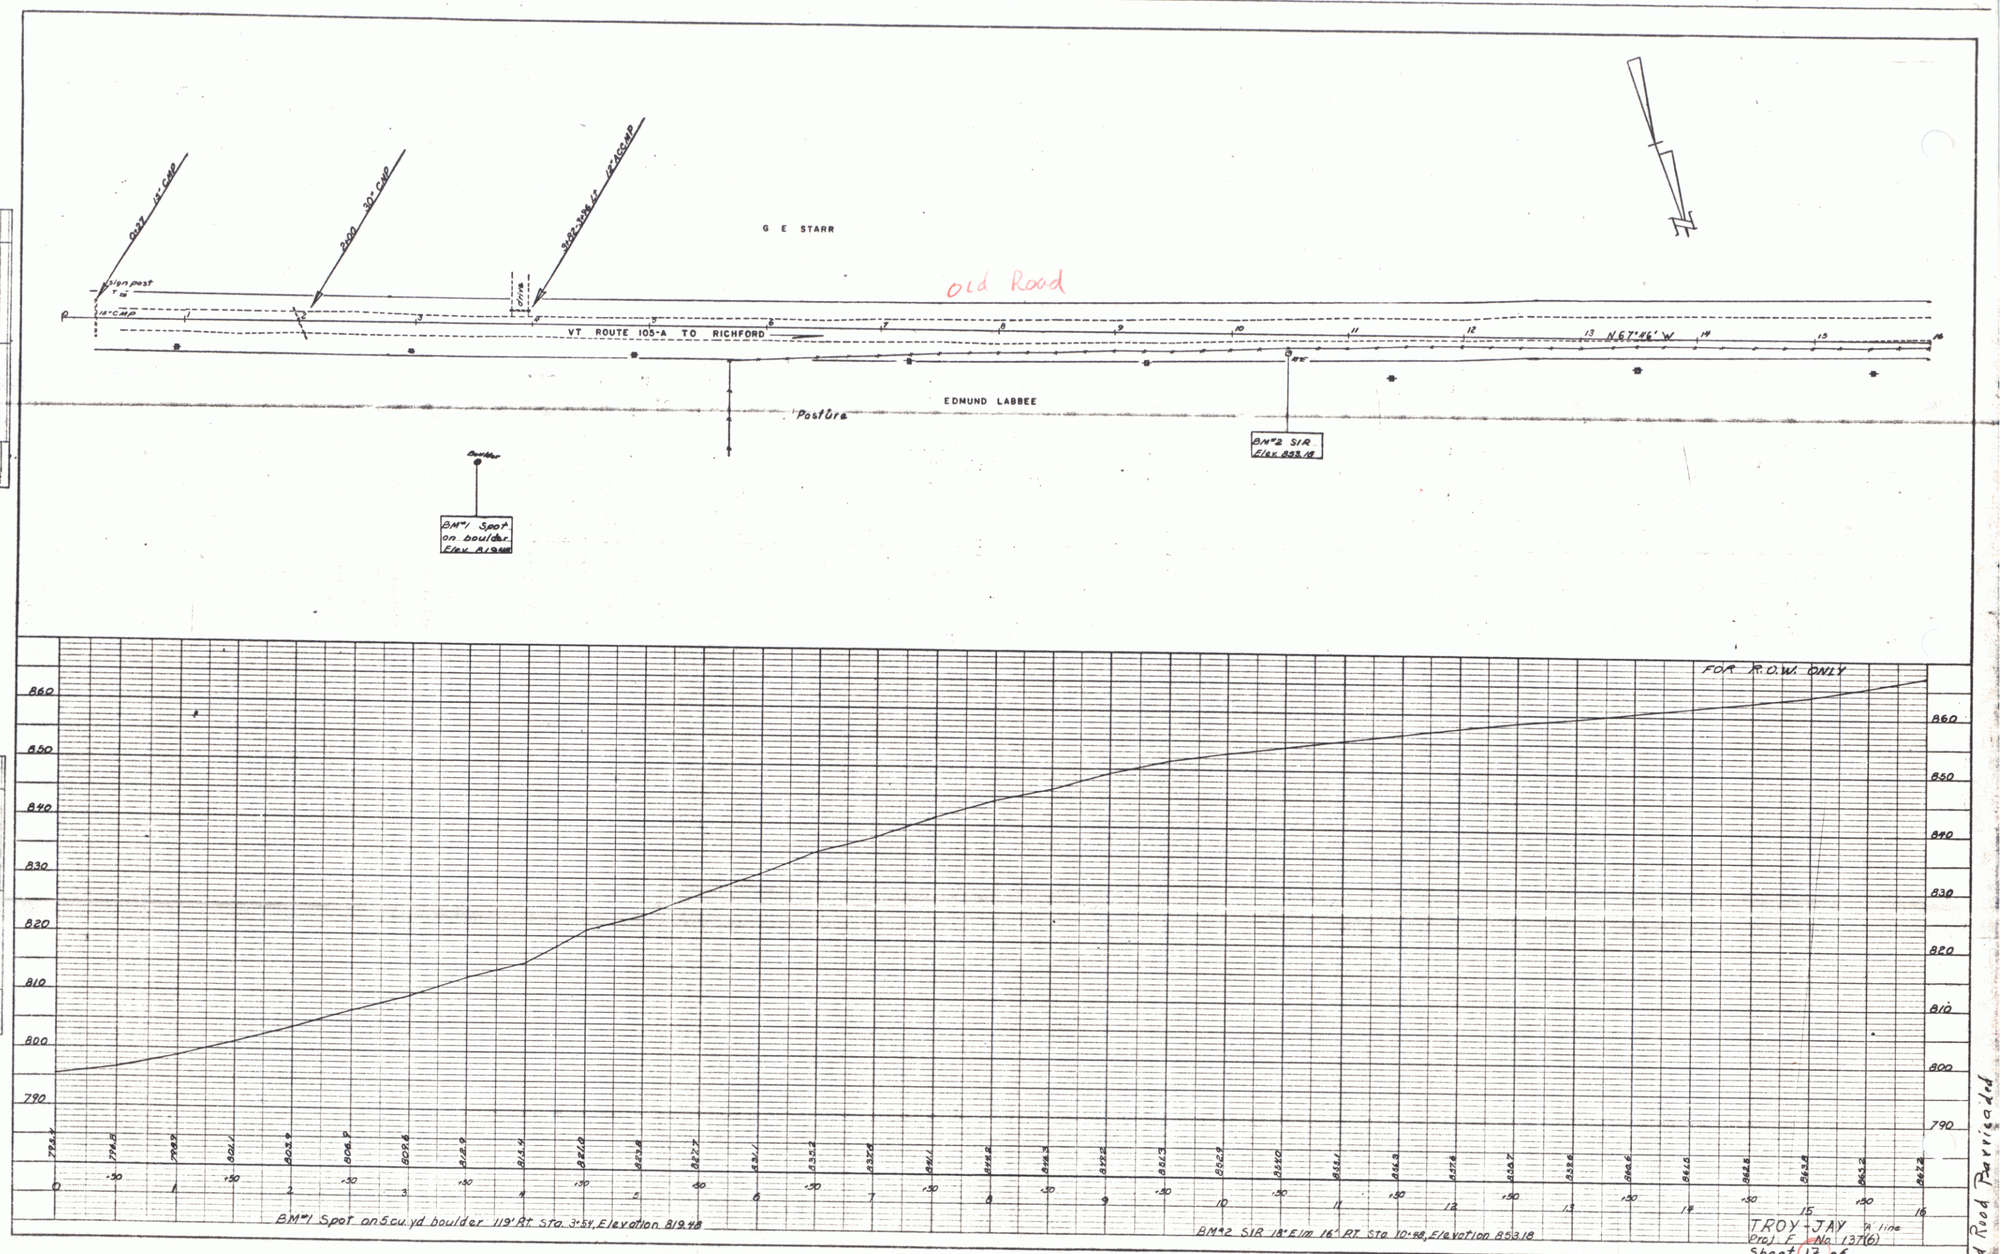

PLAN — SURVEYED; PLOTTED; NOTE BOOK; ALIGNMENT CHECKED; BK. OF MAPS CHECKED; NO. — BY Delano Boyd — DATE 8-37, 8-37

PROFILE — SURVEYED; PLOTTED; NOTE BOOK; PROFILE CHECKED; IN M & NOTED; NO. — BY Boyd Boyd — DATE 8-37, 8-37

PLATE 1—PLAN-PROFILE O. P. R. & R. E. STANDARD
KEUFFEL & ESSER CO., NEW YORK.
R & E Co. No. 348-108

Old Road Parrisadd

20