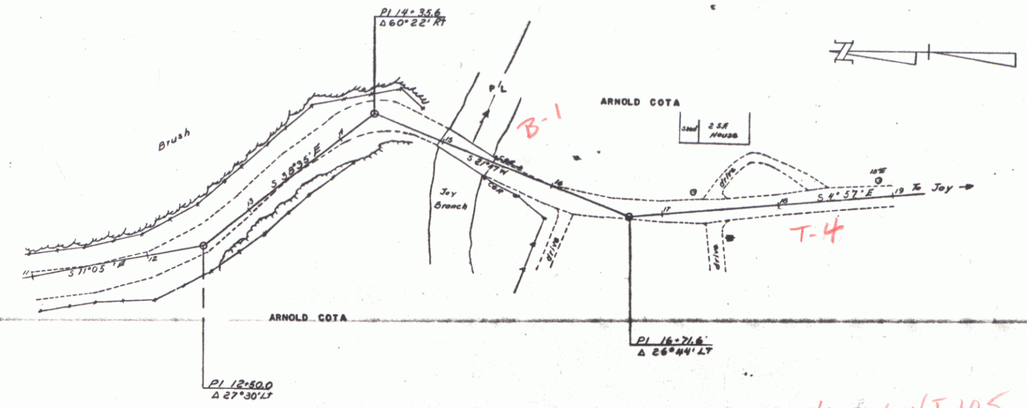

PLAN
SURVEYED
PLOTTED
NOTE BOOK ALL CHECKS UNCHECKED
NO. RT OF WAY CHECKED
DATE 8-27-62
BY Boyd

PROFILE
SURVEYED
PLOTTED
NOTE BOOK WHOLE CHECKED
NO. BY PARTIES
STRUCTURE INTERFERENCE CHECKED
DATE 8-27-62
BY Boyd

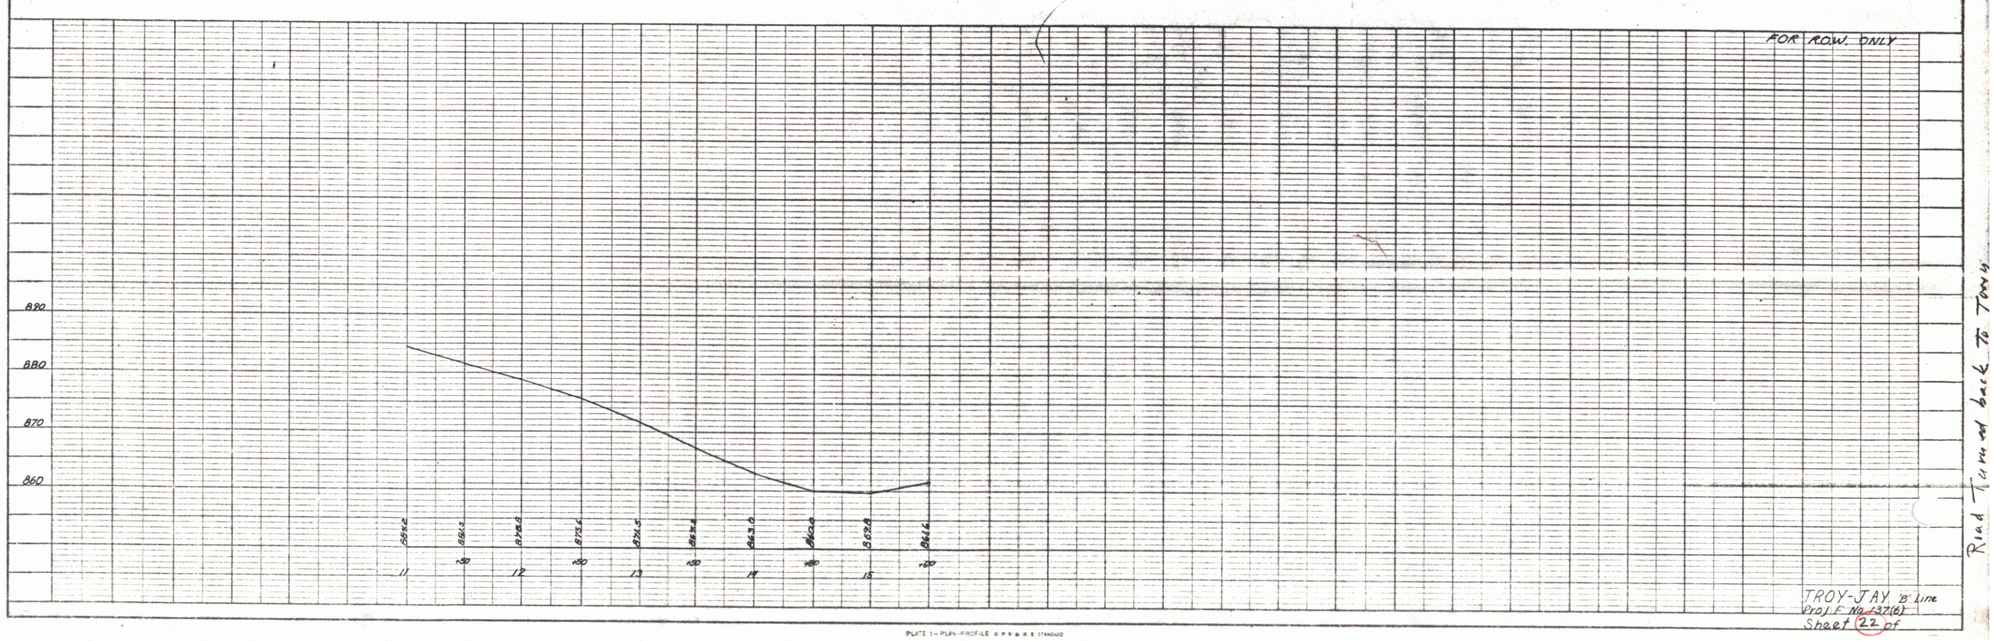

TROY-JAY 18 Line
Proj F No 137(6)
Sheet 22 of

PLATE 1 - PLAN-PROFILE © P.R.R. & R.E. STANDARD
KRUPPEL & LOSER CO., NEW YORK
R & E CO. No. 949-108

24