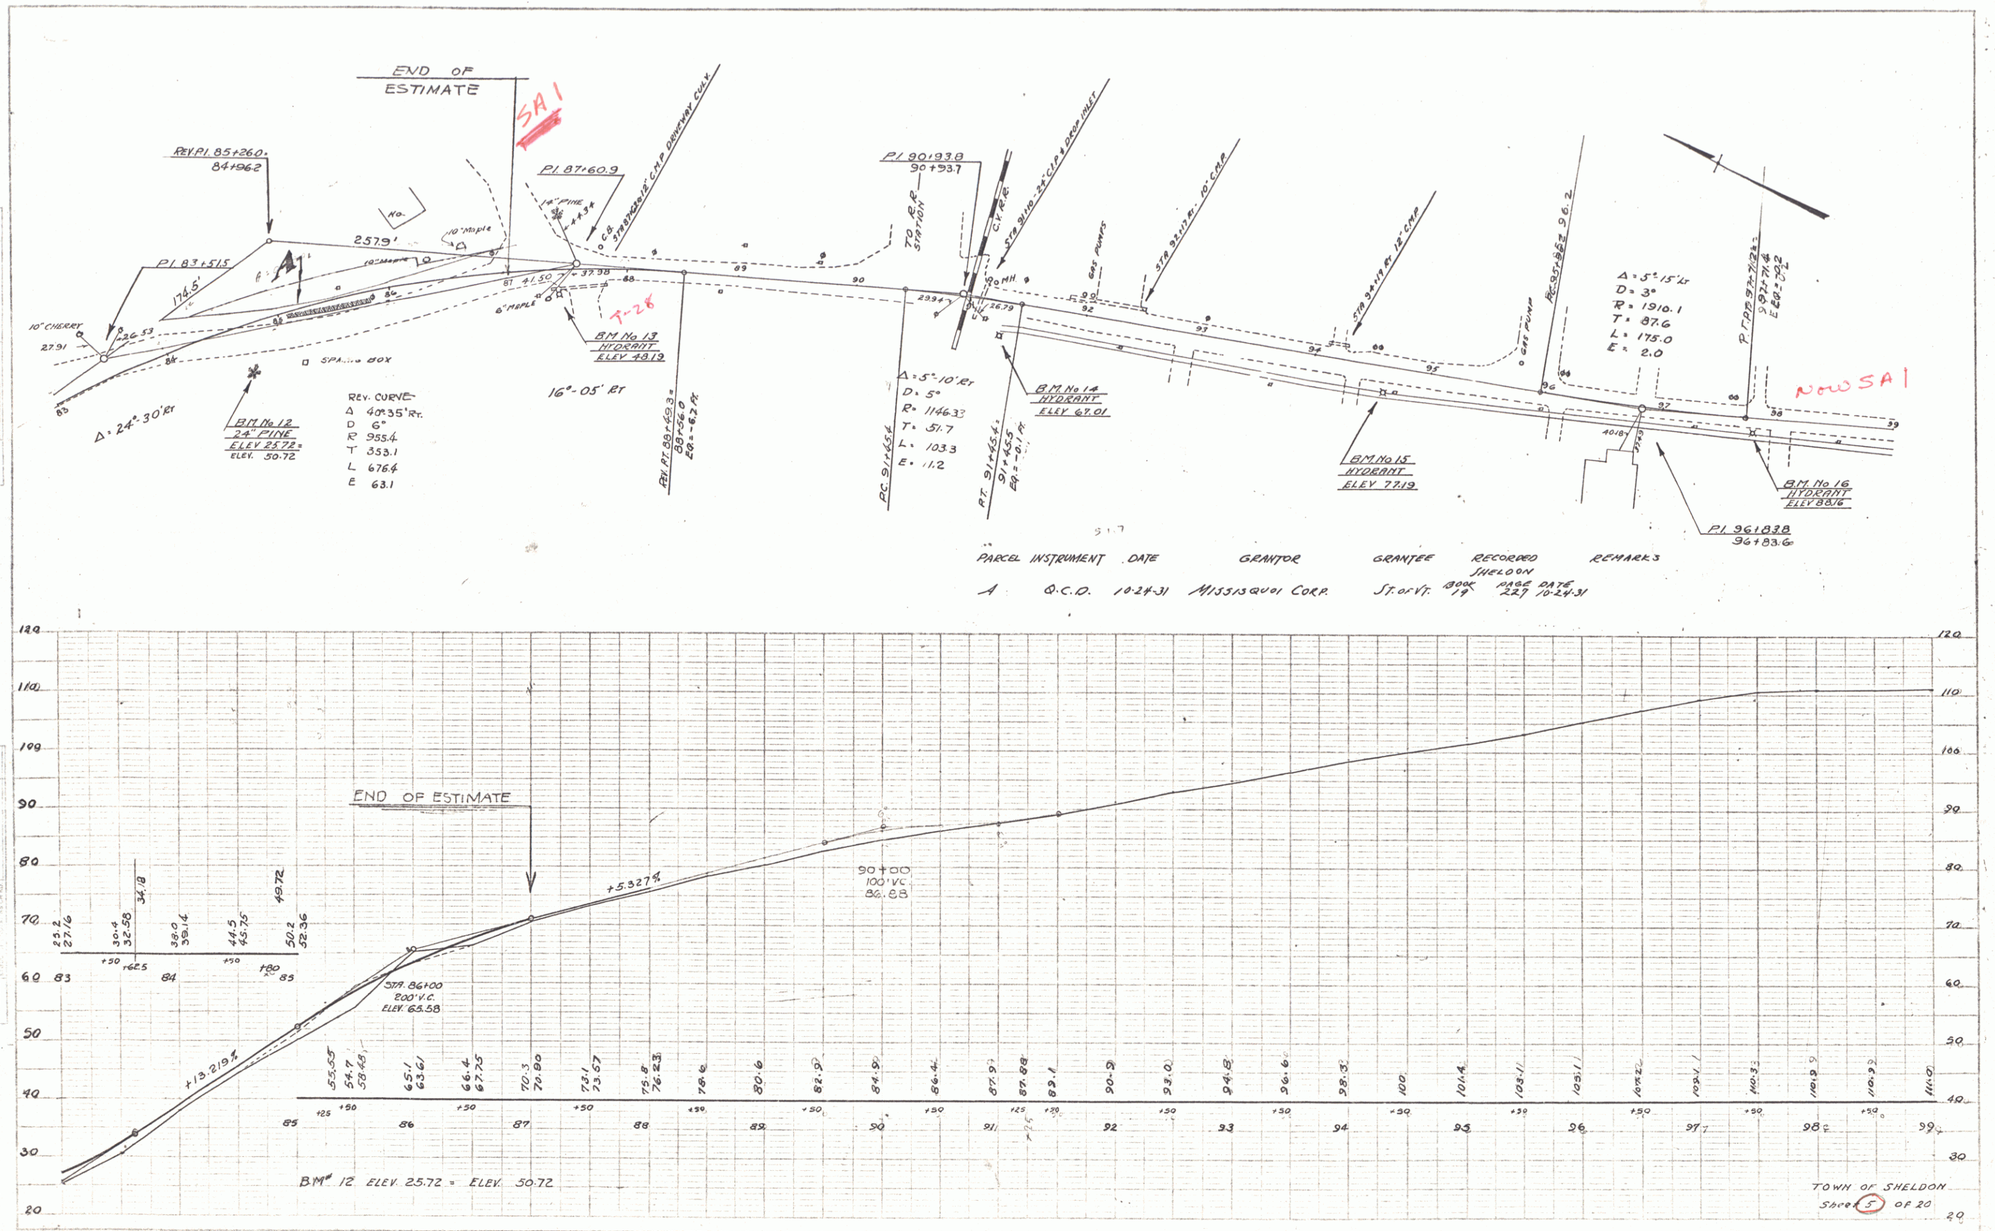

PARCEL	INSTRUMENT	DATE	GRANTOR	GRANTEE	RECORDED		REMARKS
					SHELDON		
A	Q.C.D.	10-24-31	Missisquoi Corp.	St. of Vt.	BOOK 19	PAGE DATE 227 10-24-31	

5