NEW REINF. CONC. DRIVEWAY PIPES REQUIRED

Station	Diam	Leng	Cem. Rub Mas
6+17 Rt.	15"	24'	2.7
7+25 Lt.	15"	24'	2.7
7+25 Sta. Rt.	18"	52'	3.8
8+00 Lt.	15"	24'	2.7

SUMMARY OF QUANTITIES

10-11	Common Excavation Including Borrow	1038	c.y.
12 A.	Sub-base of Field or Quarry Stone	300	c.y.
16	Broken Stone Base Course	100	c.y.
22A.	Bituminous Macadam Surface Course	120	c.y.
22C	Oil Asphalt	3960	gal.
43	Cement Rubble Masonry	12	c.y.
49B	15" Reinforced Concrete Pipe	72	l.f.
49C	18" " "	52	l.f.
51	Relaying Pipe Culverts	24	l.f.

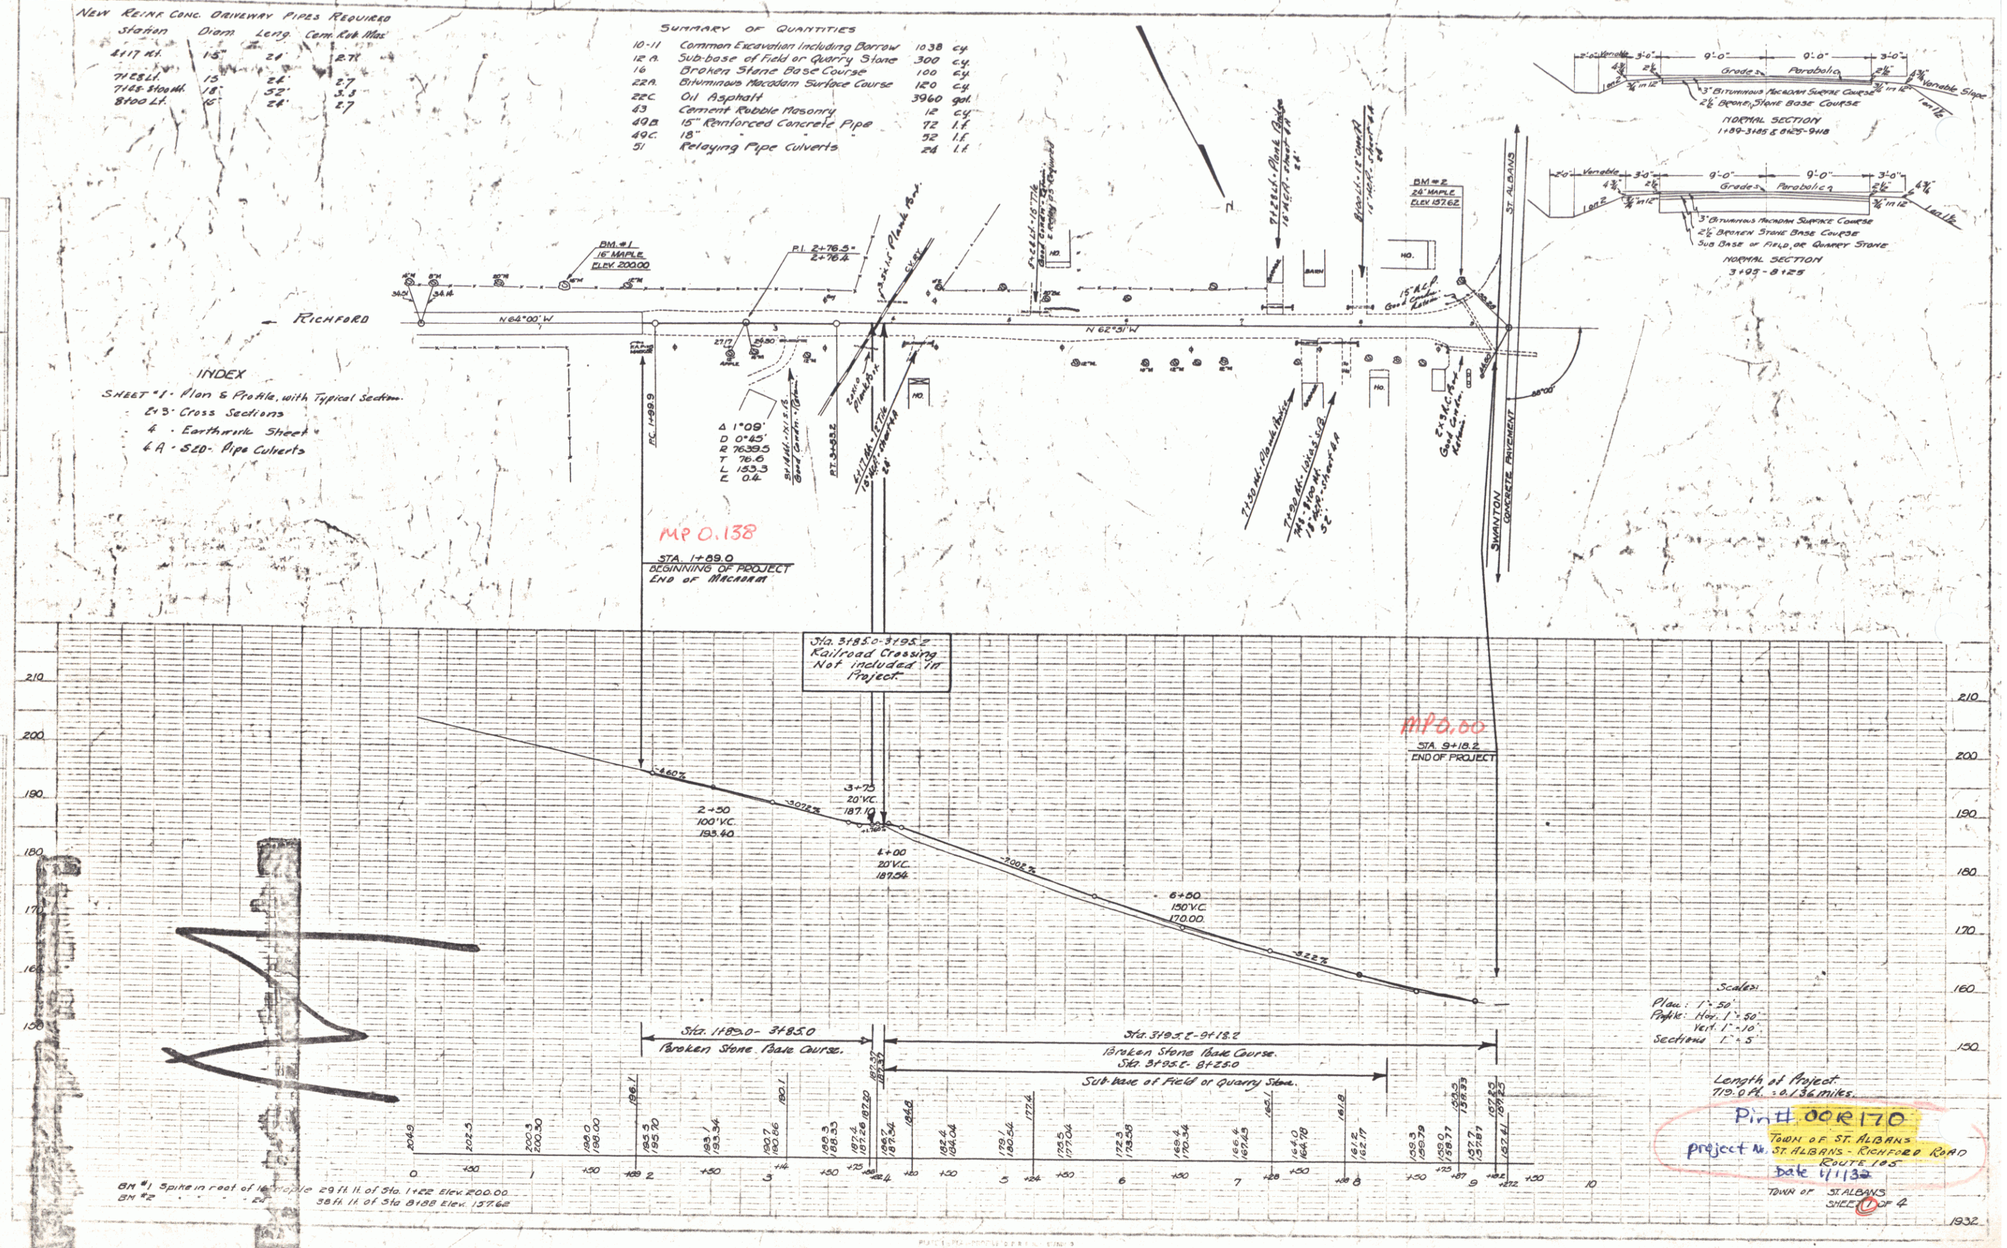

INDEX

SHEET #1 - Plan & Profile, with Typical Sections
2 & 3 - Cross Sections
4 - Earthwork Sheet
6 A - SLD - Pipe Culverts