St. Albans - Sheldon - Enosburg

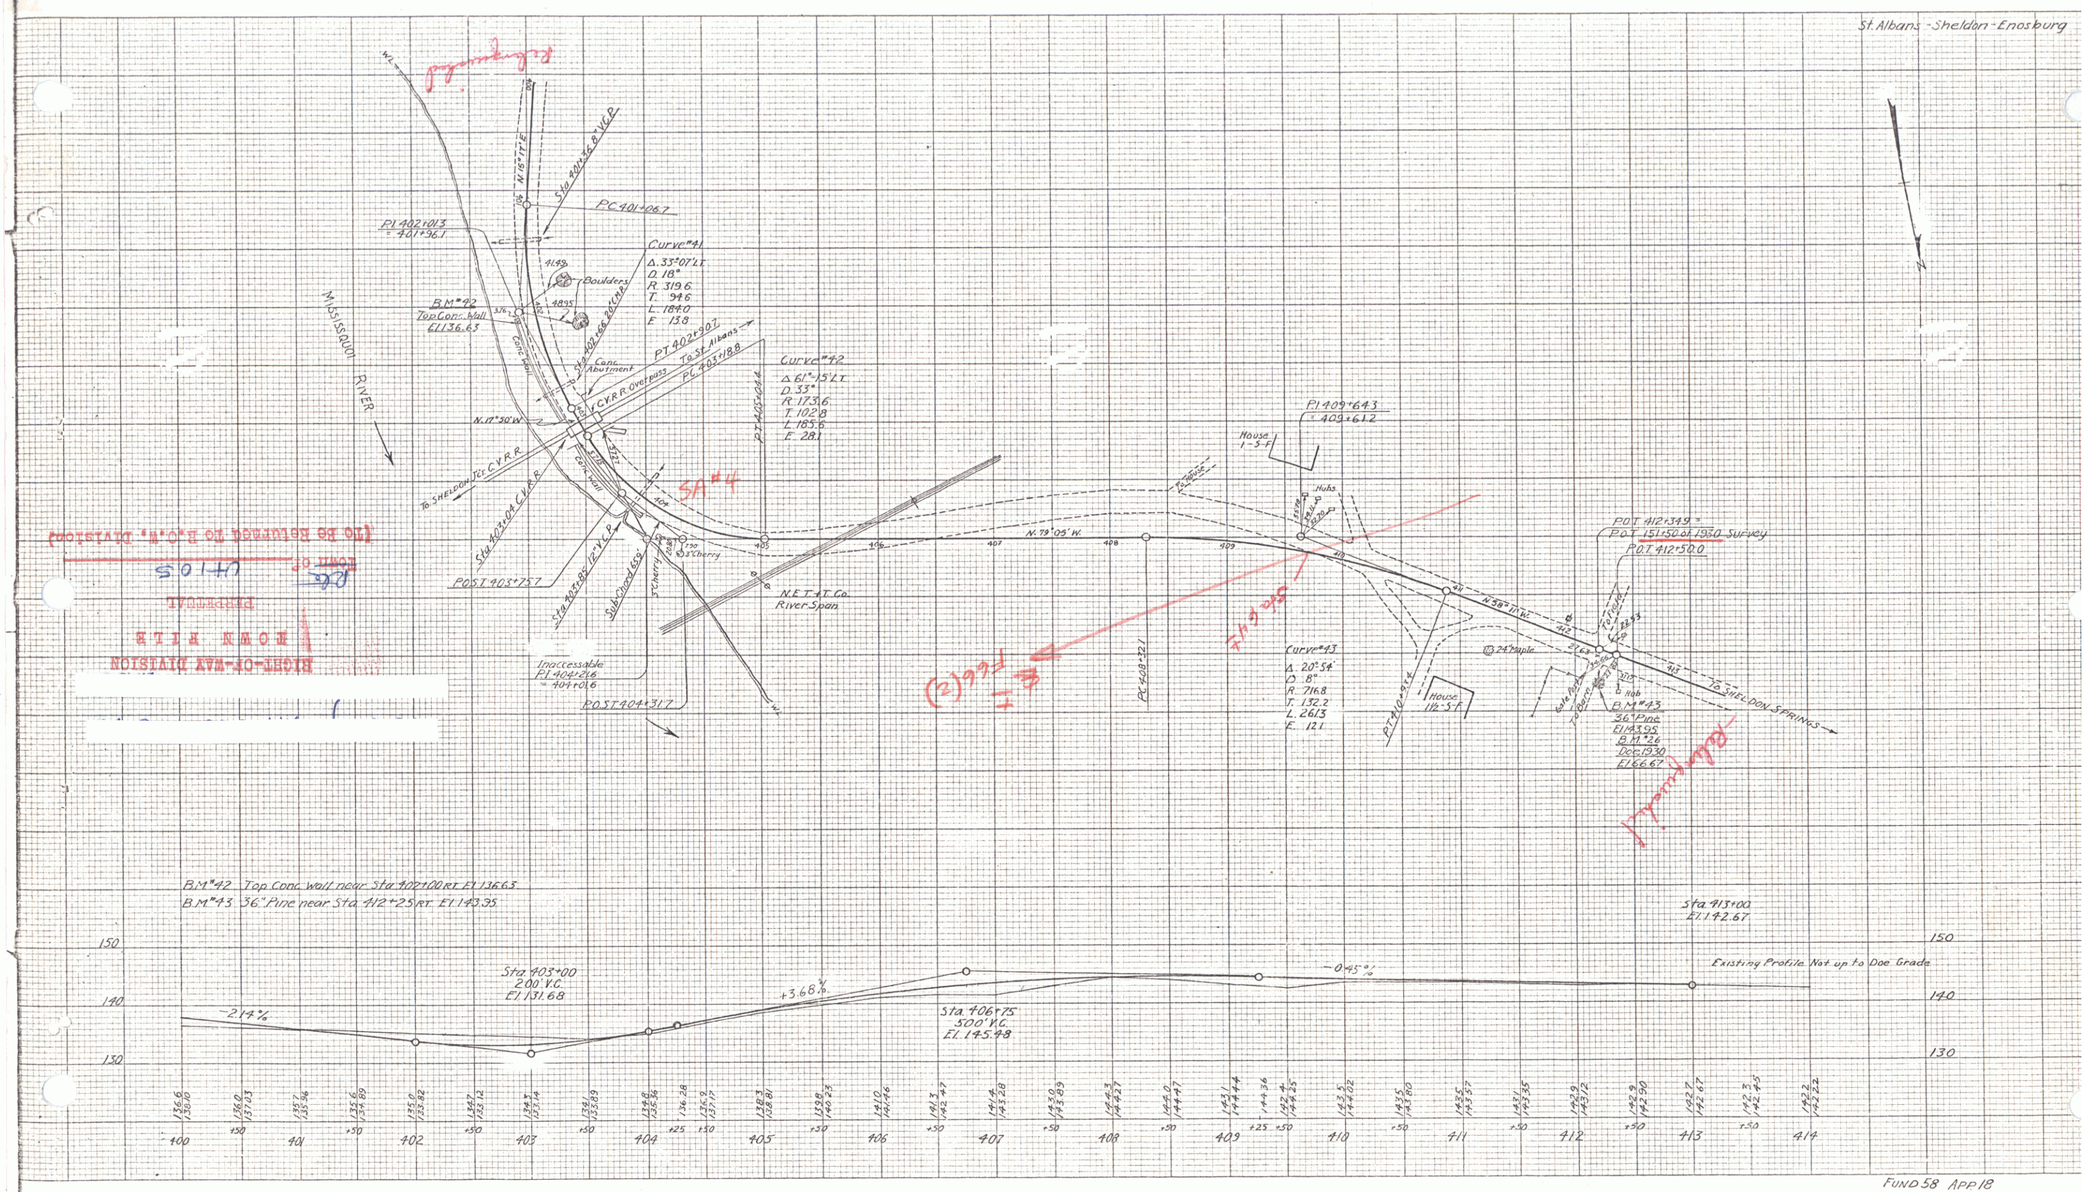


FUND 58 APP 18
1931
#23
Sheet no. 29 of 29

26