STEEL GUIDE POSTS
Sta. Lt. Rt.
209+50 1
210+50 1

EXCAVATION & REMOVAL OF ROAD SURFACE ON DISCONTINUED ROADWAYS
211+75 – ~~214+00 Rt.~~ 212+75 Rt.

CONSTRUCT DRIVES
210+00 Lt.
210+40 Rt.
211+50 Rt.

CONSTRUCT APPROACH
209+25 Rt.
204+0 Rt.

~~PLANK GUARD RAIL~~
~~211+75 Rt. – 24'~~

THREE CABLE GUARD RAIL
199+43 – 202+0 Rt 256'
199+75 – 200+87 Lt 112'

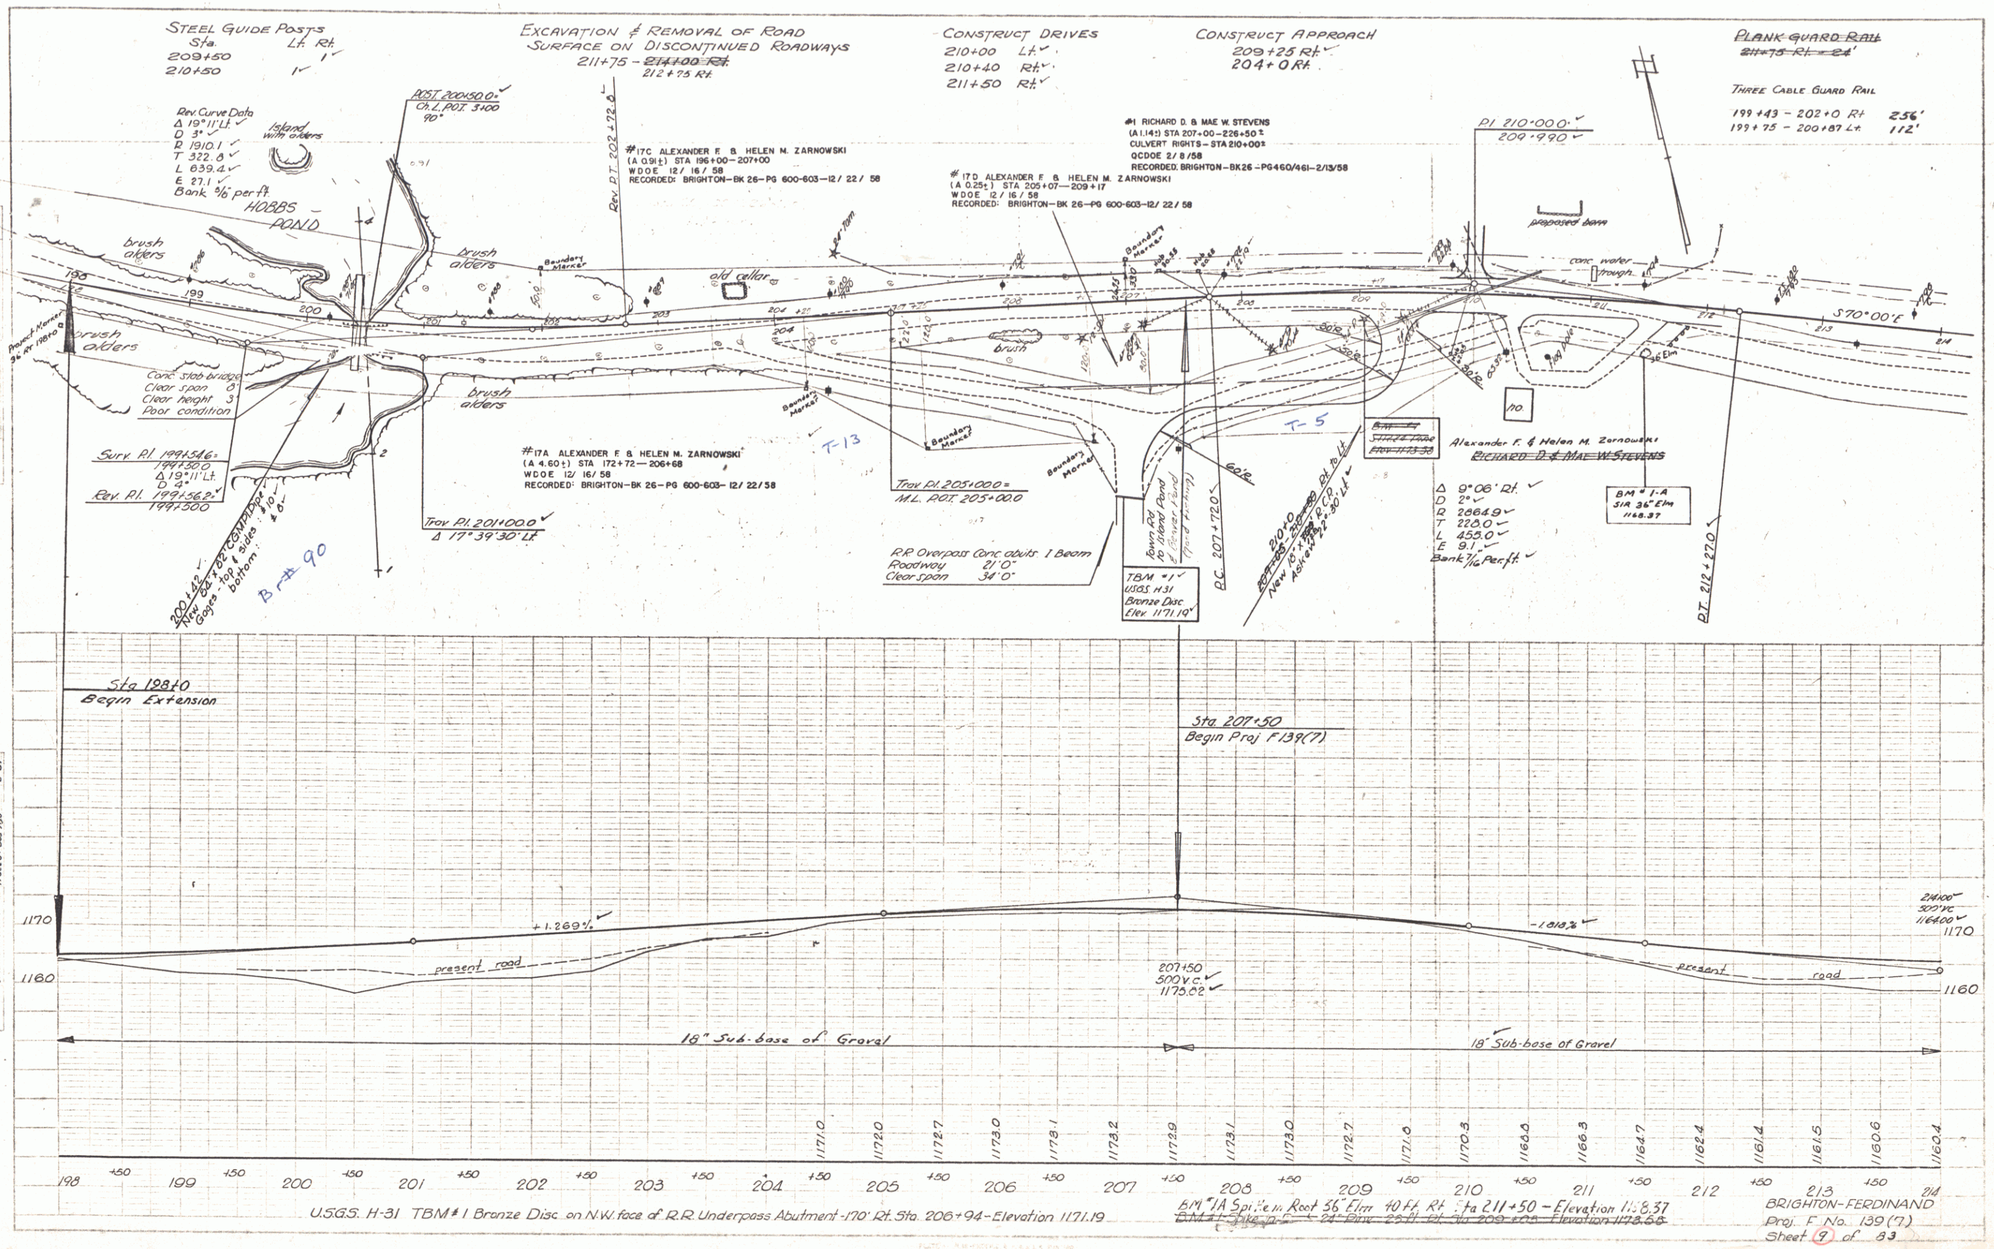

U.S.G.S. H-31 TBM #1 Bronze Disc on N.W. face of R.R. Underpass Abutment - 170' Rt. Sta. 206+94 - Elevation 1171.19

BM #1A Spike in Root 36" Elm 40 ft. Rt. Sta 211+50 – Elevation 1148.37
~~BM #1 Spike in 24" Pine 29 ft. Rt. Sta 209+00 Elevation 1178.66~~

BRIGHTON-FERDINAND
Proj. F No. 139(7)
Sheet 9 of 83

7