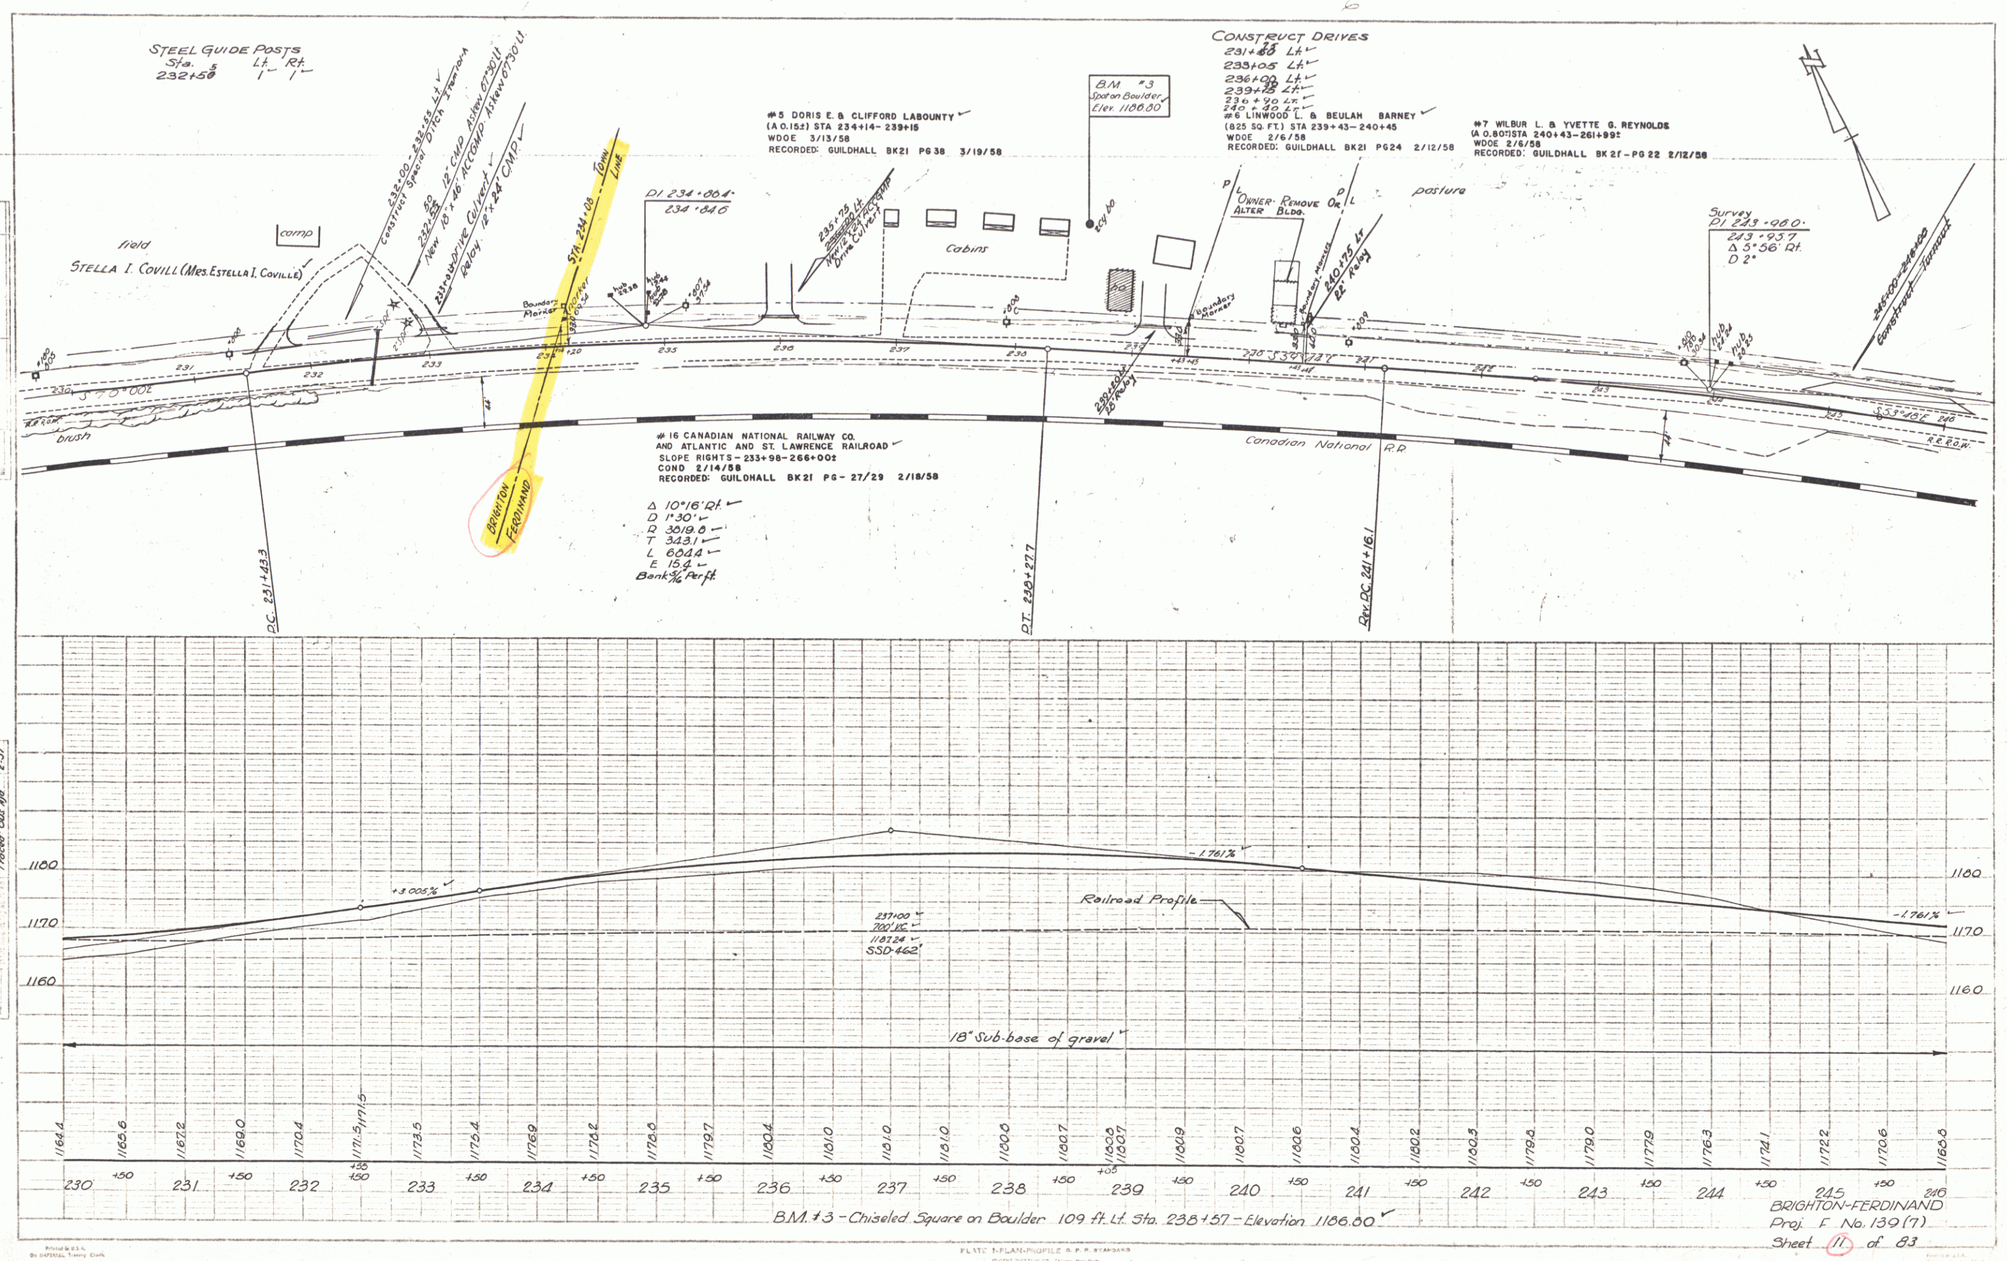


PLATE 1-PLAN-PROFILE R.P.R. STANDARD
EUGENE DIETZGEN CO. Chicago-New York

9