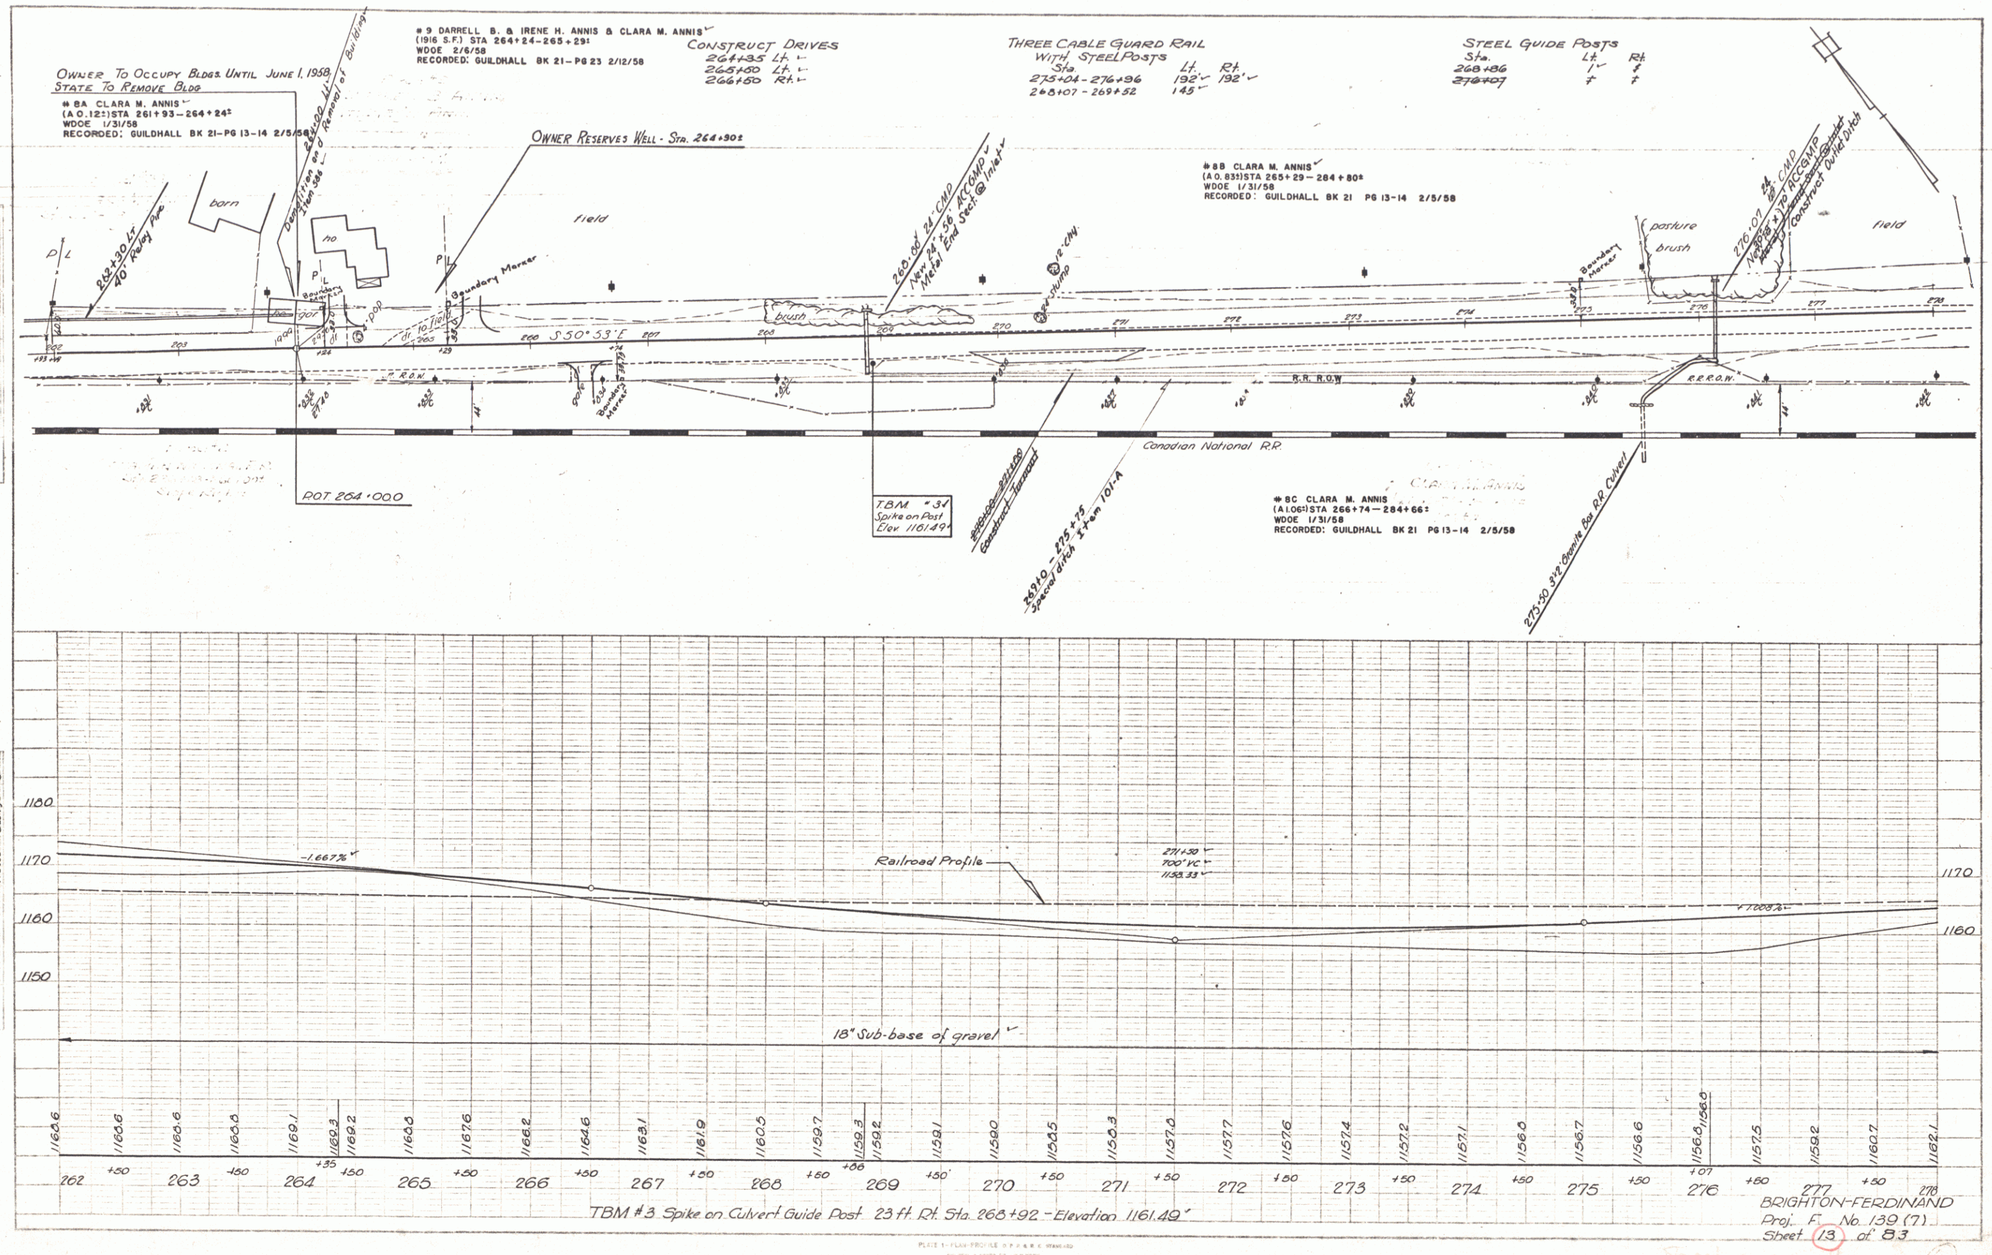
Owner To Occupy Bldg. Until June 1, 1958
State To Remove Bldg
#8A CLARA M. ANNIS
(A.O. 12±) STA 261+93 – 264+24±
WDOE 1/31/58
RECORDED: GUILDHALL BK 21–PG 13–14 2/5/58
#9 DARRELL B. & IRENE H. ANNIS & CLARA M. ANNIS
(1916 S.F.) STA 264+24–265+29±
WDOE 2/6/58
RECORDED: GUILDHALL BK 21–PG 23 2/12/58
Construct Drives
264+35 Lt.
265+50 Lt.
266+50 Rt.
Three Cable Guard Rail With Steel Posts
Sta. Lt. Rt.
275+04 – 276+96 192' 192'
268+07 – 269+52 145
Steel Guide Posts
Sta. Lt. Rt.
268+86
270+07
#8B CLARA M. ANNIS
(A.O. 831) STA 265+29 – 284+80±
WDOE 1/31/58
RECORDED: GUILDHALL BK 21 PG 13–14 2/5/58
Owner Reserves Well - Sta. 264+30±
barn
ho
field
brush
pasture
Boundary Marker
S 50° 53' E
R.R. R.O.W.
Canadian National R.R.
POT 264+000
T.B.M. #3
Spike on Post
Elev. 1161.49'
#8C CLARA M. ANNIS
(A.I.06±) STA 266+74 – 284+66±
WDOE 1/31/58
RECORDED: GUILDHALL BK 21 PG 13–14 2/5/58
Railroad Profile
-1.667%
+1.008%
18" Sub-base of gravel
TBM #3 Spike on Culvert Guide Post 23 ft. Rt. Sta. 268+92 – Elevation 1161.49'
BRIGHTON-FERDINAND
Proj. F No. 139 (7)
Sheet 13 of 83