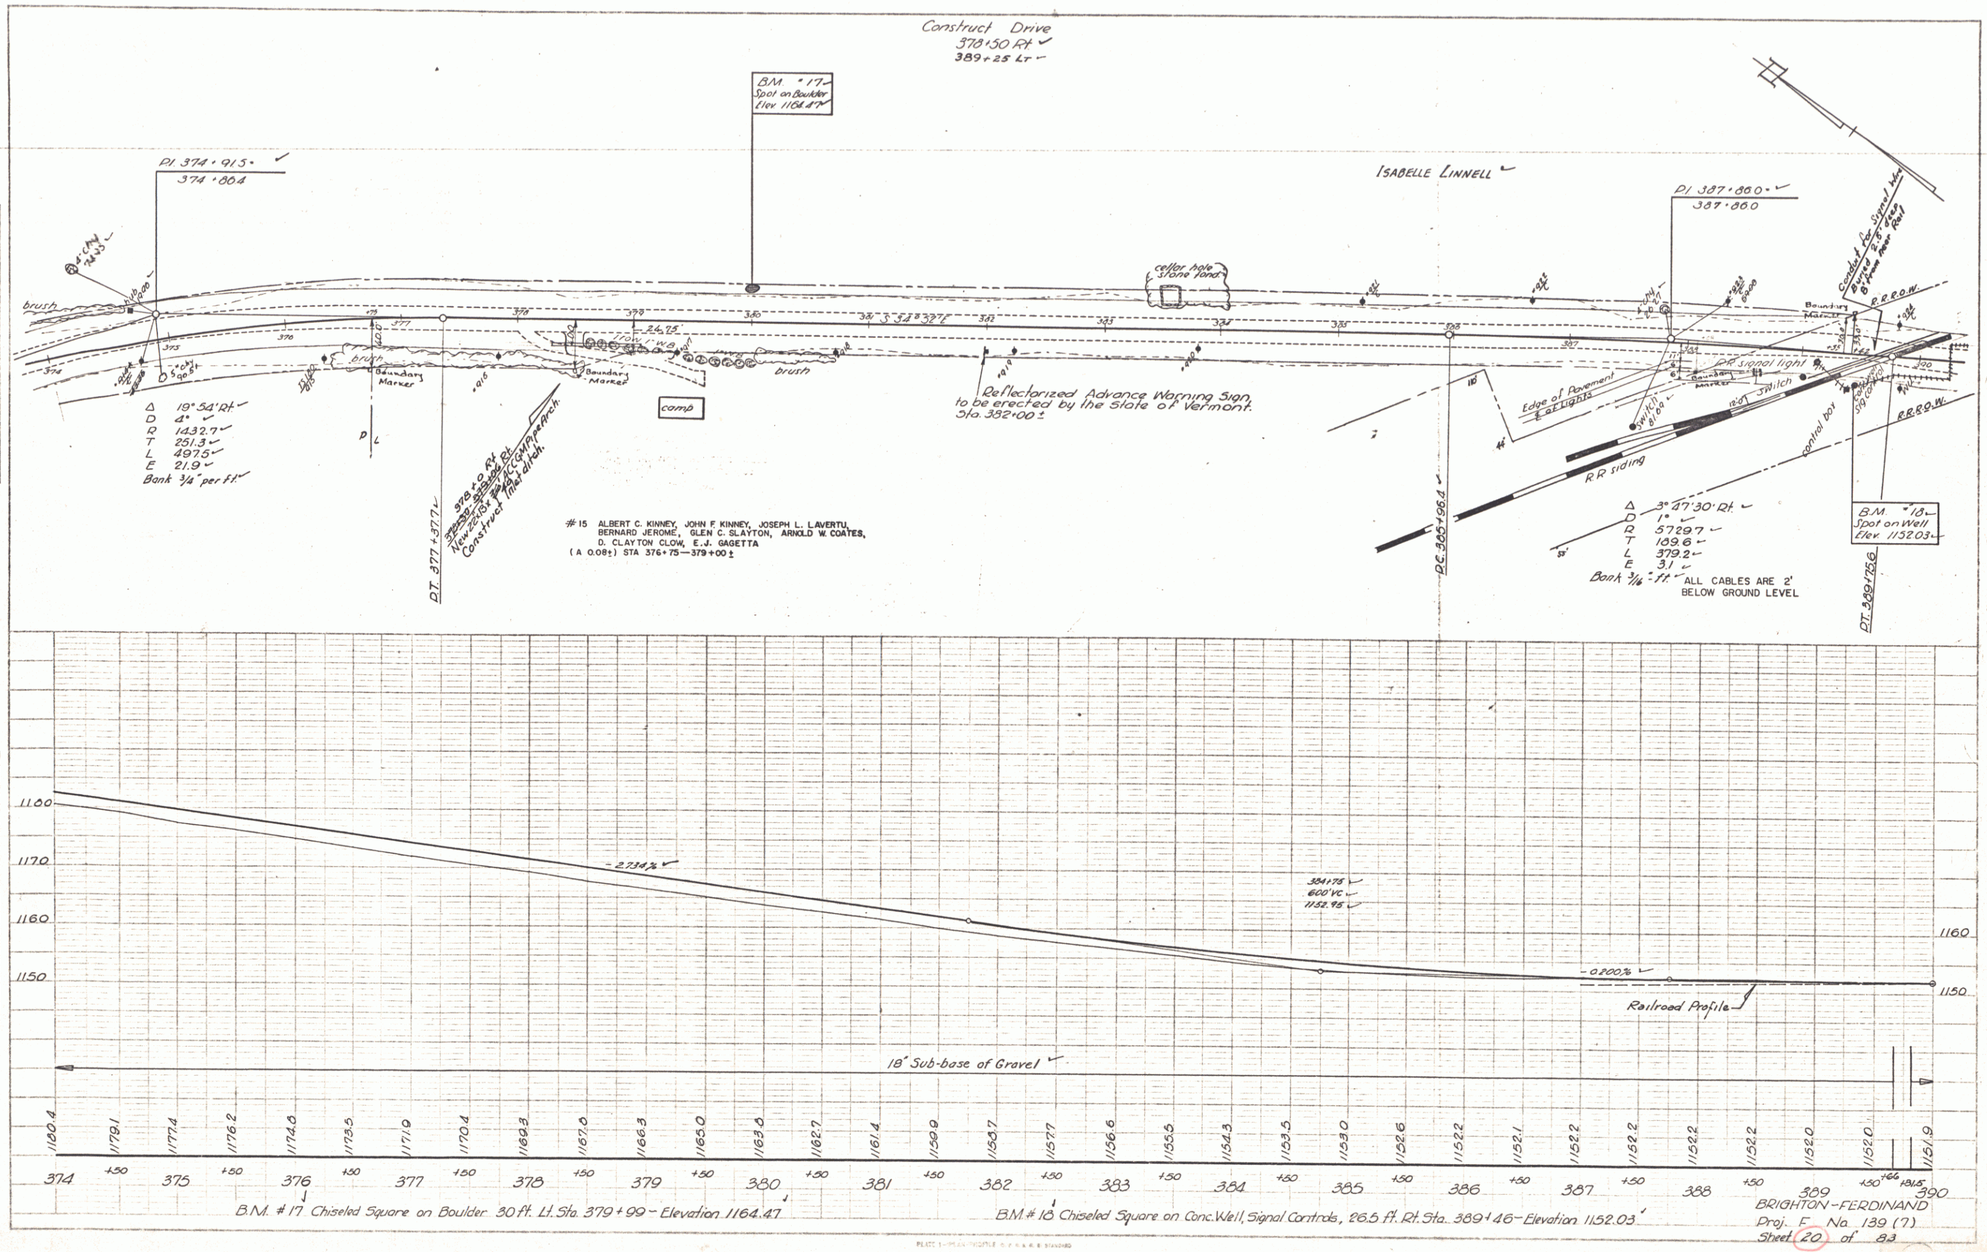
Construct Drive
378+50 Rt
389+25 Lt
B.M. #17
Spot on Boulder
Elev 1164.47
PI 374+915
374+804
ISABELLE LINNELL
PI 387+860
387+860
cellar hole
stone fence
brush
Boundary Marker
Boundary Marker
Boundary Marker
Boundary Marker
camp
Reflectorized Advance Warning Sign
to be erected by the State of Vermont.
Sta. 382+00 ±
Edge of Pavement
& at Lights
RR signal light
Switch
RR siding
Conduit for Signal box
Signal box
Sig. Control Box
B.M. #18
Spot on Well
Elev. 1152.03
Δ 19° 54' Rt
D 4°
R 1432.7
T 251.3
L 497.5
E 21.9
Bank 3/4" per ft
Δ 3° 47' 30" Rt
D 1°
R 5729.7
T 109.6
L 219.2
E 3.1
Bank 3/16" per ft
ALL CABLES ARE 2' BELOW GROUND LEVEL
#15 ALBERT C. KINNEY, JOHN F KINNEY, JOSEPH L. LAVERTU, BERNARD JEROME, GLEN C. SLAYTON, ARNOLD W. COATES, D. CLAYTON CLOW, E.J. GAGETTA
(A 0.08±) STA 376+75—379+00 ±
PT 377+377
BC 385+96.4
PT 389+75.6
-2.734%
384+75
600' VC
1152.95
-0.200%
Railroad Profile
18' Sub-base of Gravel
1160.4 1179.1 1177.4 1176.2 1174.0 1173.5 1171.0 1170.4 1169.3 1167.0 1166.3 1165.0 1163.5 1162.7 1161.4 1159.9 1158.7 1157.7 1156.6 1155.5 1154.3 1153.5 1153.0 1152.6 1152.2 1152.1 1152.2 1152.2 1152.2 1152.2 1152.0 1152.0 1151.9
374 375 376 377 378 379 380 381 382 383 384 385 386 387 388 389 390
B.M. #17 Chiseled Square on Boulder 30 ft. Lt. Sta. 379+99 – Elevation 1164.47
B.M. #18 Chiseled Square on Conc. Well, Signal Controls, 26.5 ft. Rt. Sta. 389+46 – Elevation 1152.03
BRIGHTON-FERDINAND
Proj. F No. 139 (7)
Sheet 20 of 83