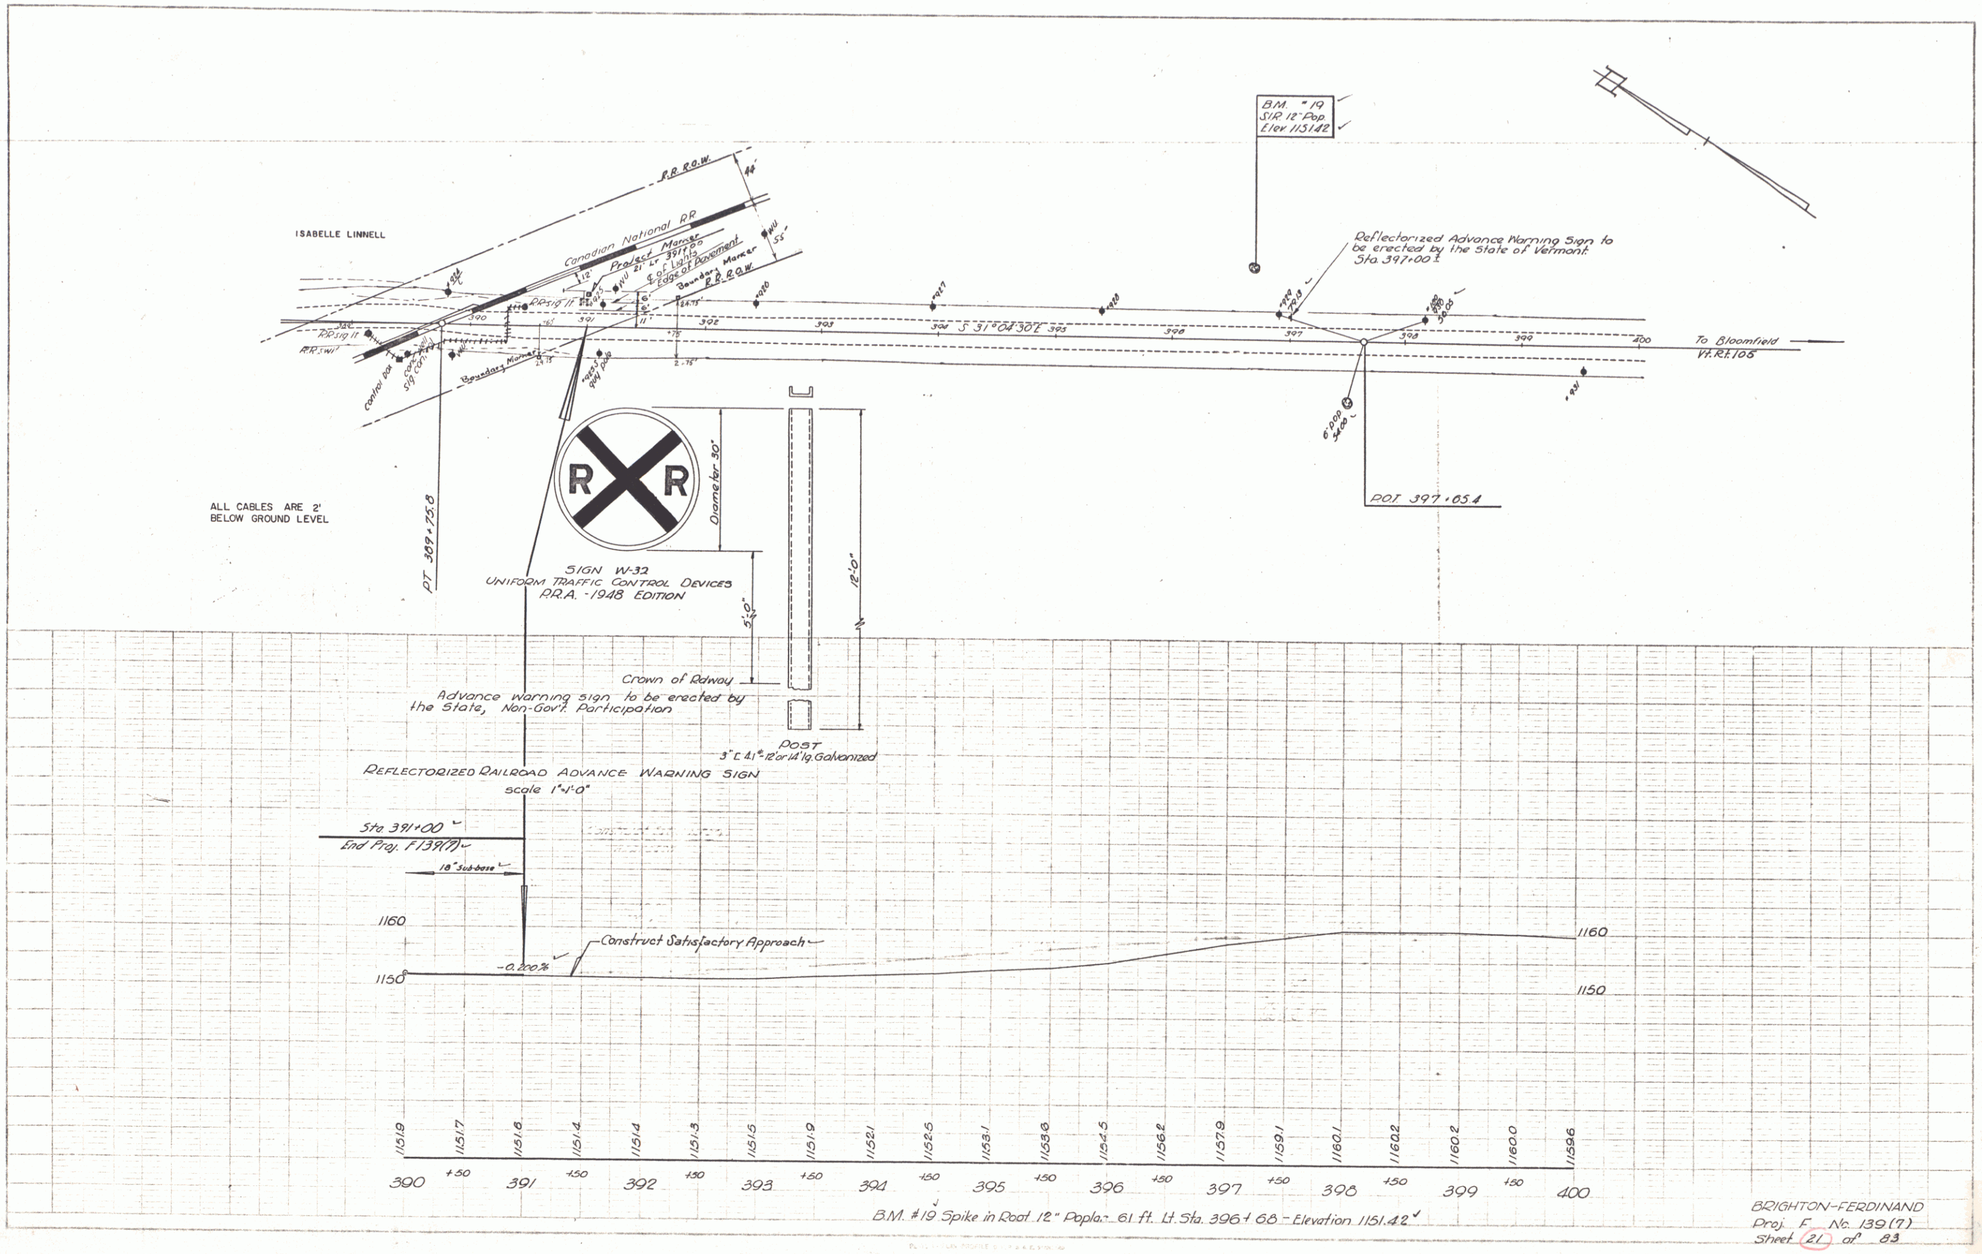

BRIGHTON-FERDINAND
Proj. F No. 139(7)
Sheet 21 of 83

19