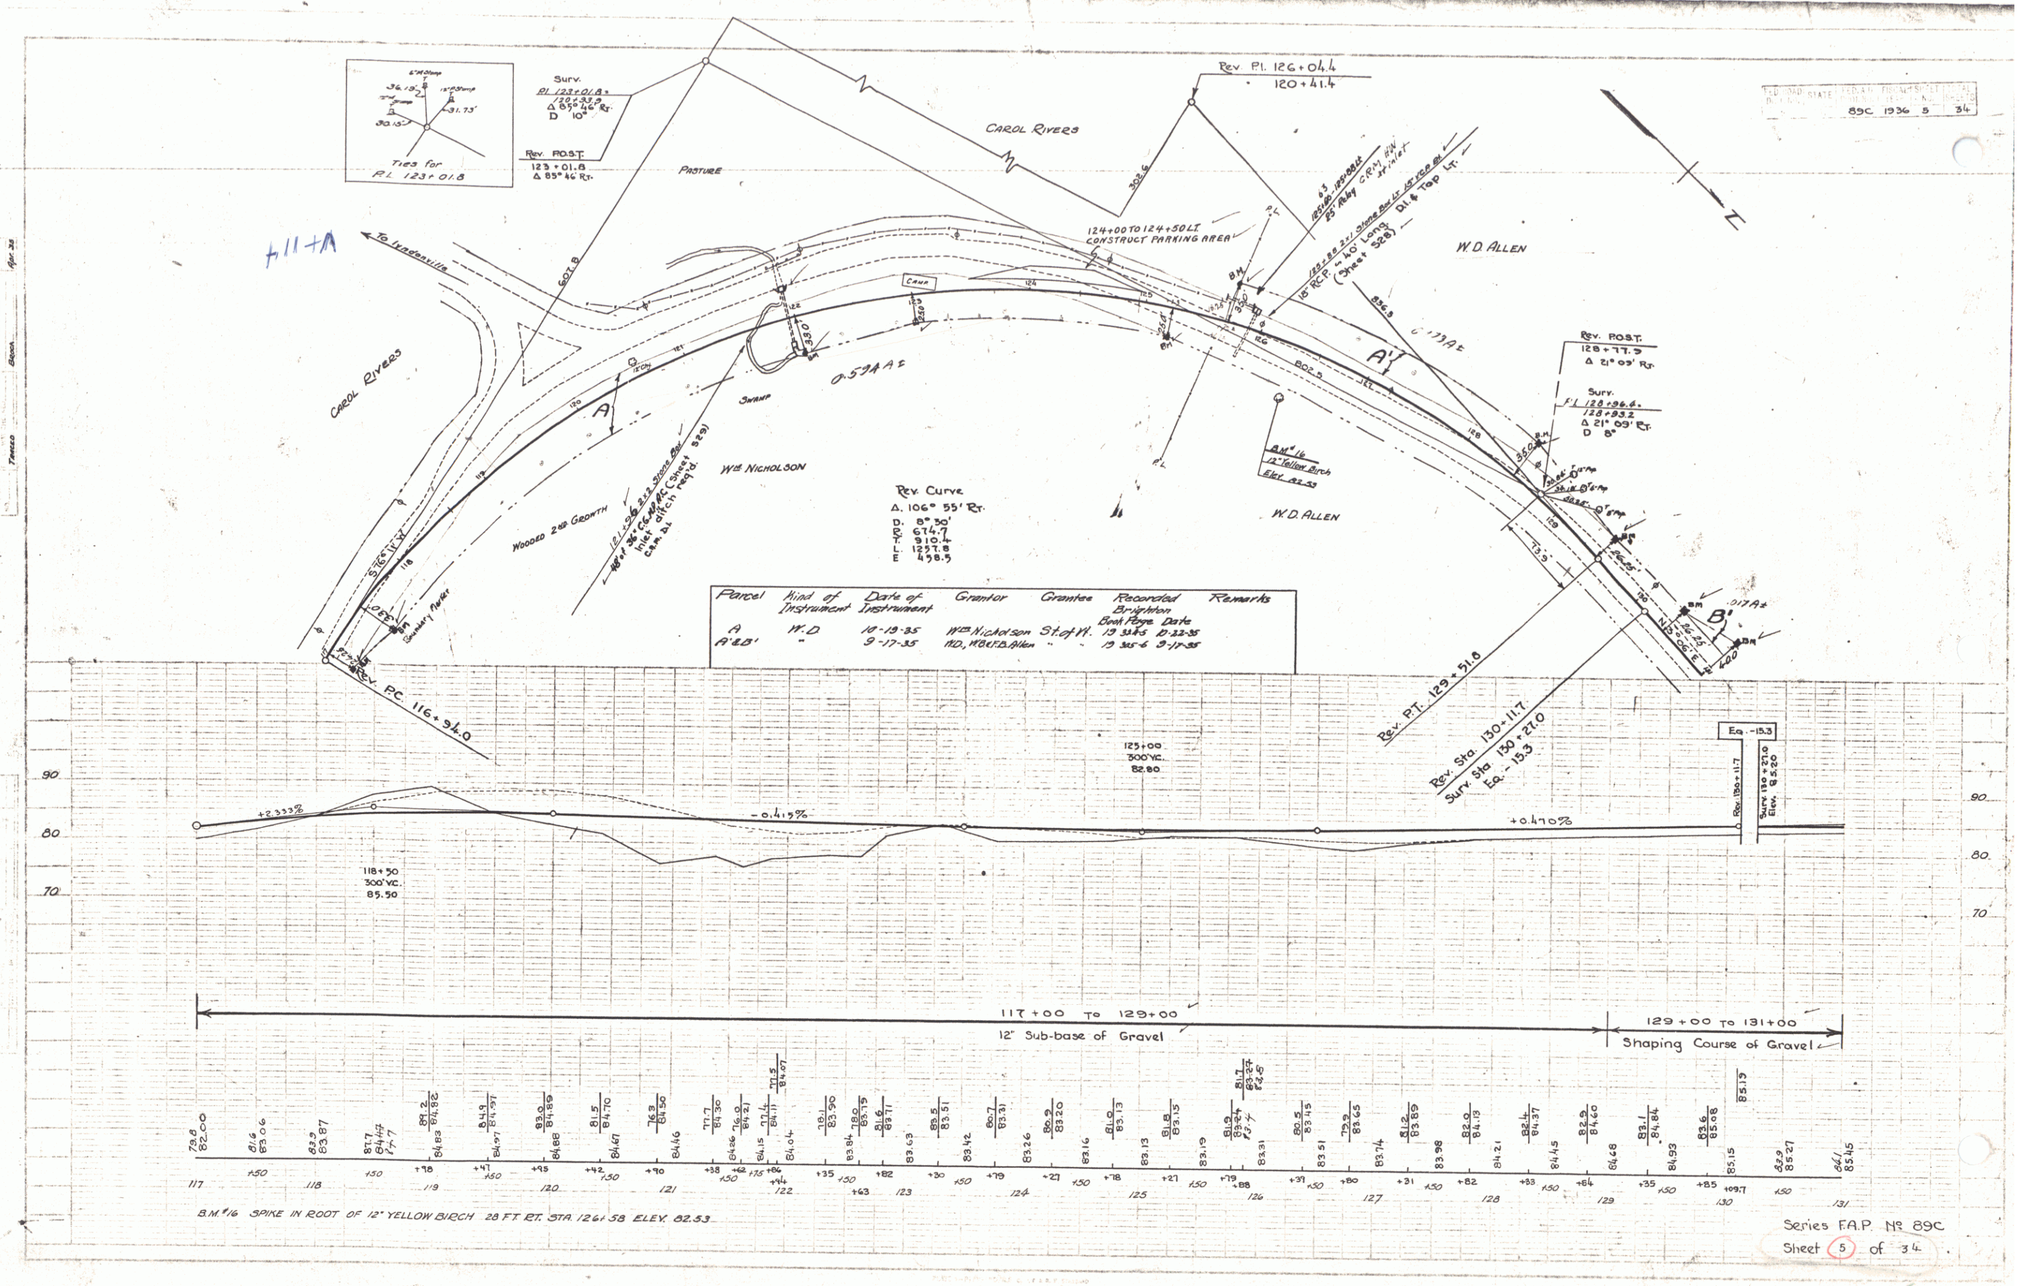

Parcel	Kind of Instrument	Date of Instrument	Grantor	Grantee	Recorded Brighton Book Page	Date	Remarks
A	W.D	10-19-35	Wm Nicholson	St. of Vt.	19 304-5	10-22-35	
A' B'	"	9-17-35	W.D. Allen	"	19 305-6	9-17-35	