FED. ROAD DIST. NO.	STATE	FEDERAL PROJECT NO.	FISCAL YEAR	SHEET NO.	TOTAL SHEETS
1	VT	NHH098	1934	6	36

(1933)

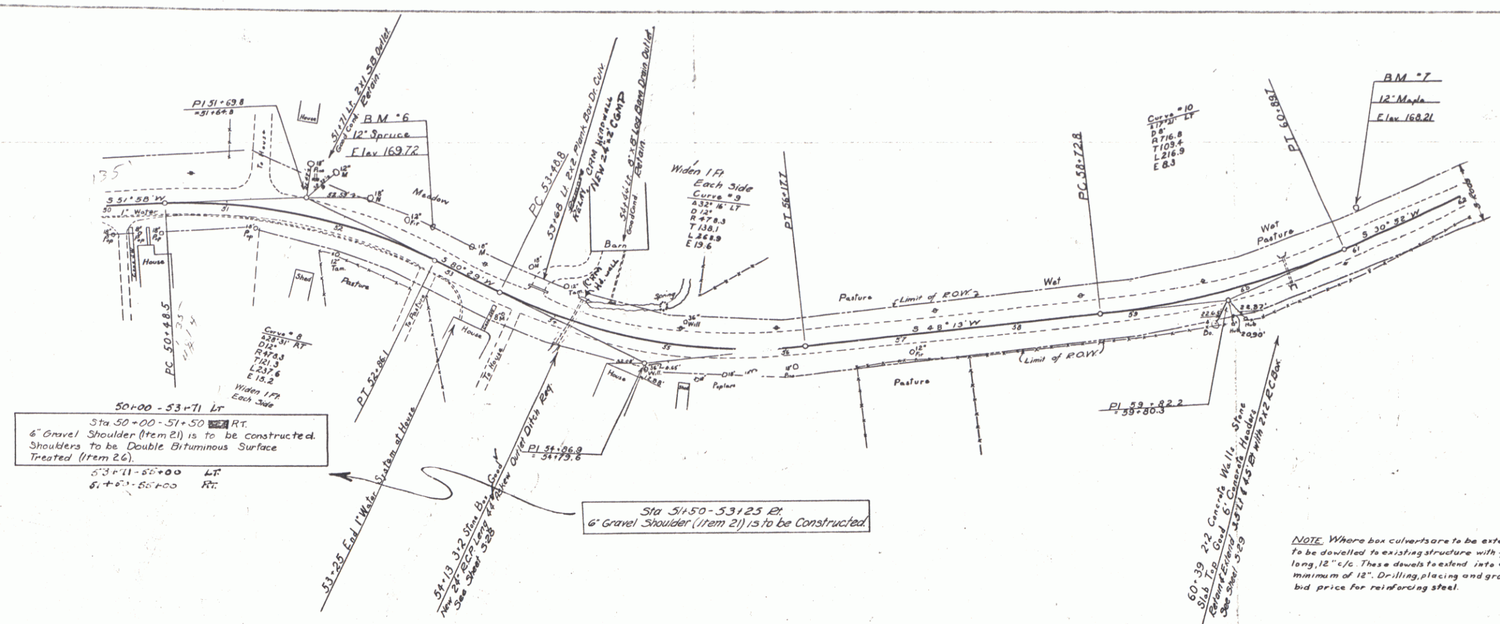

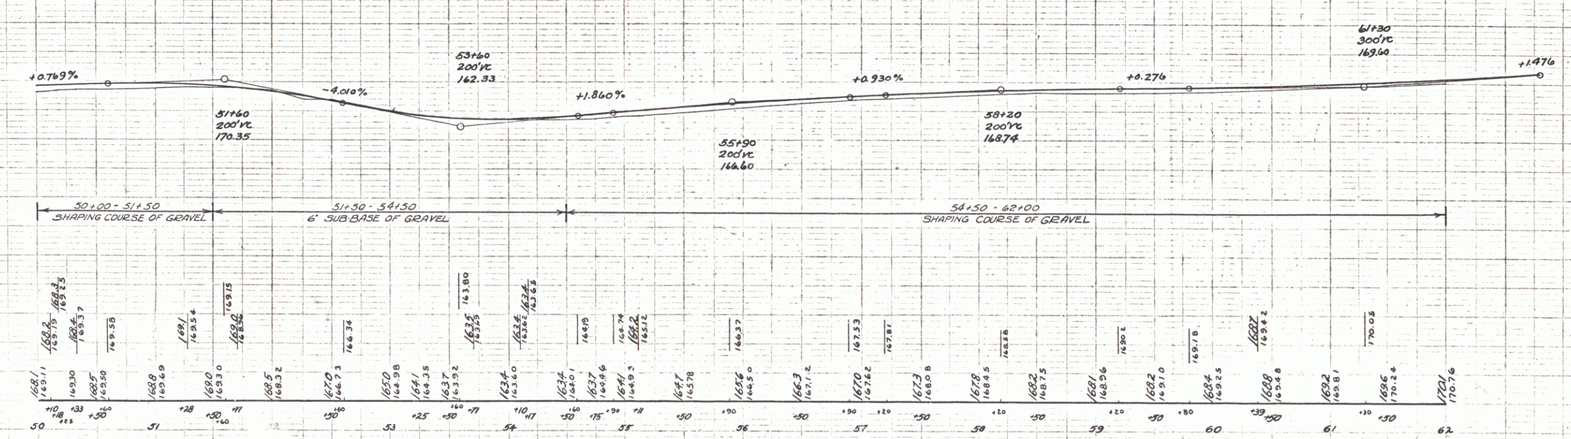

BM #6 SPIKE IN ROOT 12" SPRUCE 30' LT STA. 52+72 ELEV. 169.72
BM #7 " " " 12" MAPLE 30' LT STA 61+13 ELEV. 168.21

SERIES NEH NO 89 B (1933)
SHEET 6 OF 36

4