


Parcel	Kind of Instrument	Date of Instrument	Grantor	Grantee	Recorded	Remarks
B	QAD	11-27-34	F.P. Ufford	Shof. 12	19 278 12-11-34	Don Page Date
A	110	8-14-35	Wm Morris	19 288 8-14-35		


FEDERAL ROAD DISTRICT NO. 10
 PROJECT NO. 1934 10 34
 SHEET NO. 4 OF 34

FEDERAL ROAD DISTRICT NO. 10
 PROJECT NO. 1934 10 34
 SHEET NO. 4 OF 34

BOSTON 7/34
 D. MACCHI 7/34
 TRACED

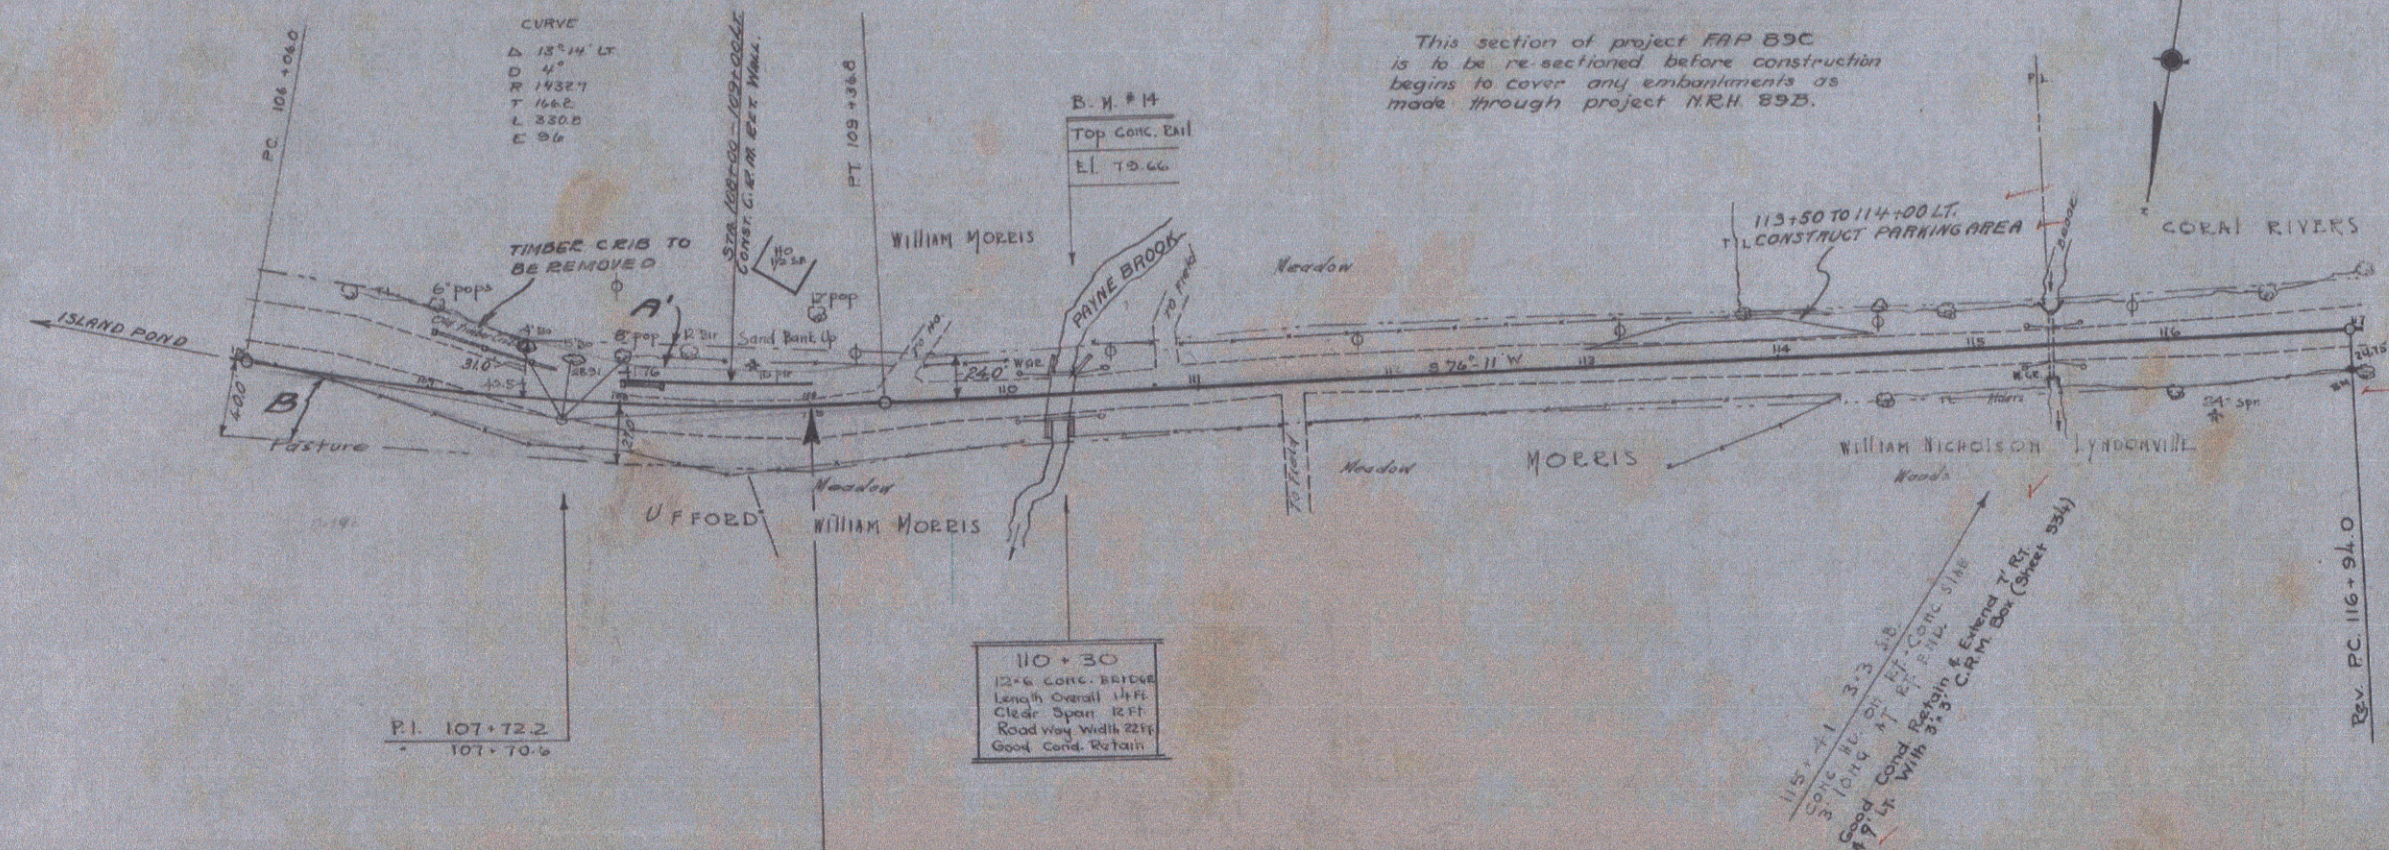

BOSTON 7/34
 D. MACCHI 7/34

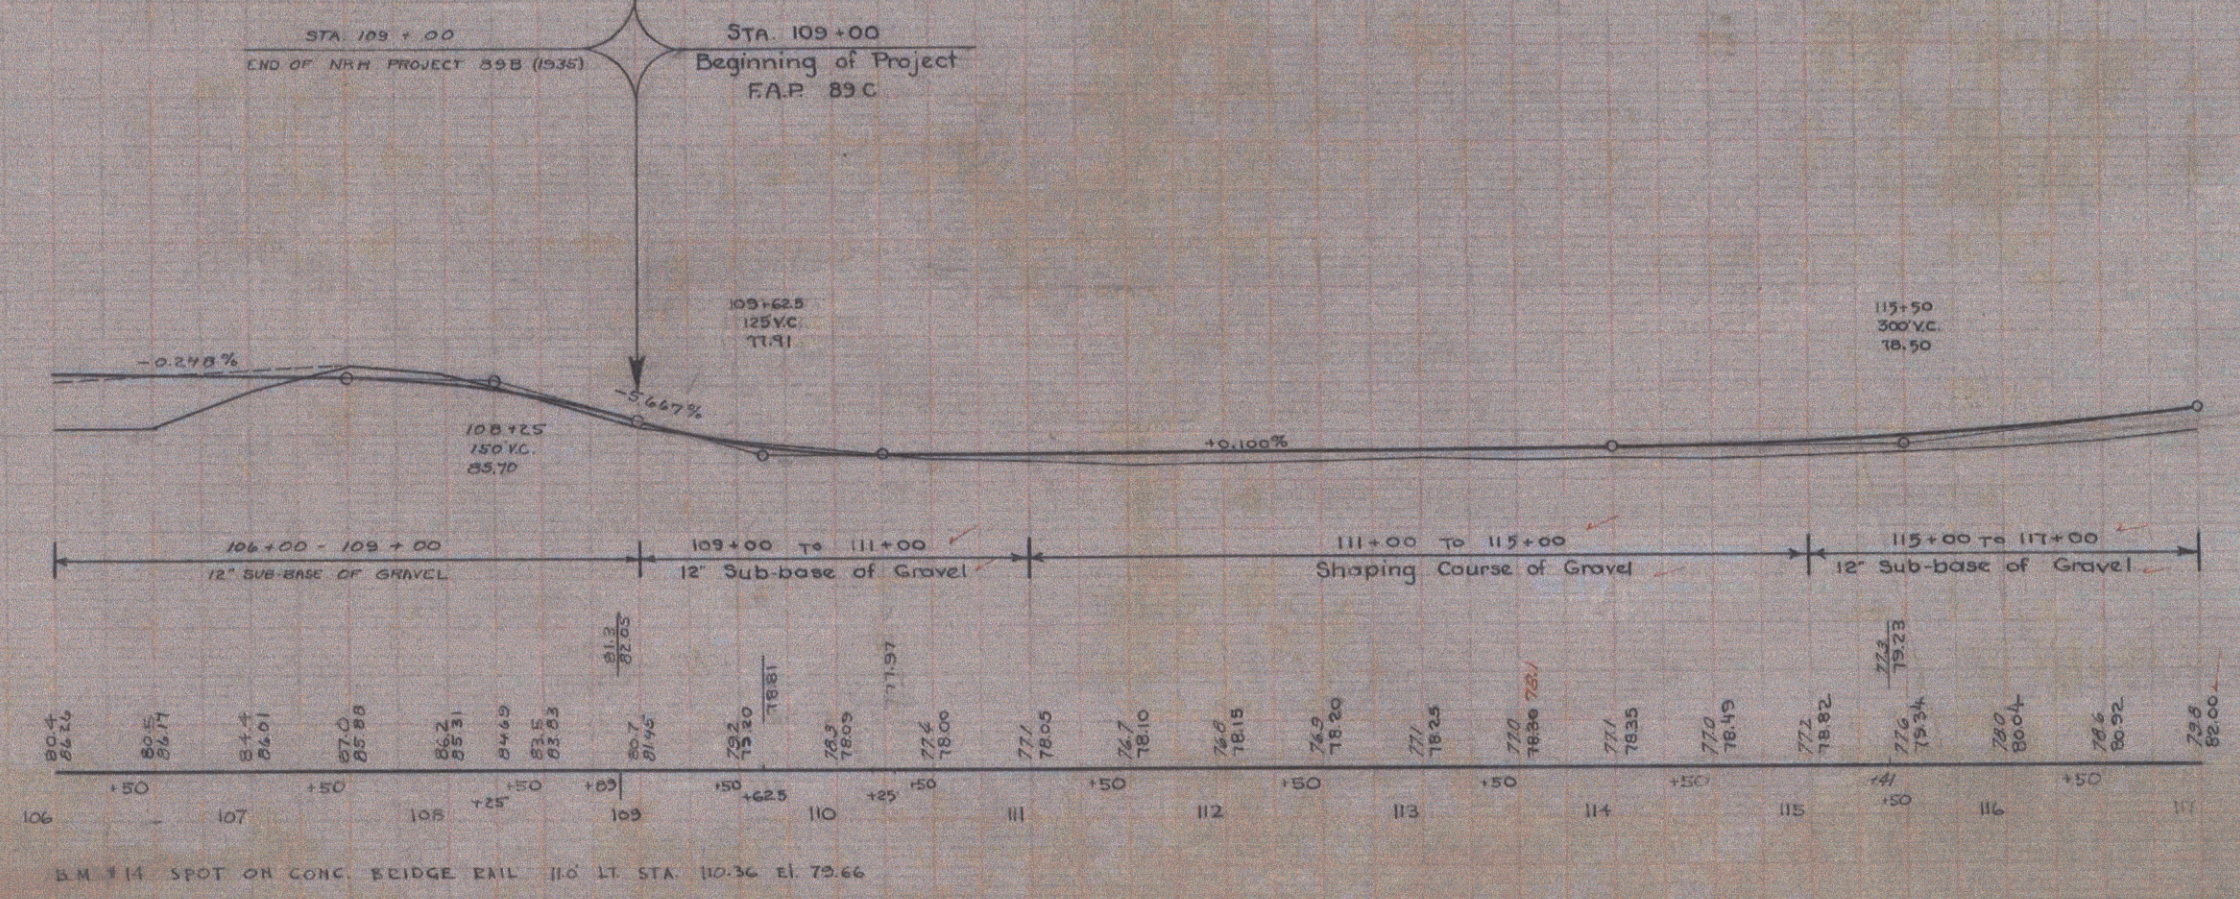

Series FAP No 89C
 Sheet 4 of 34

SERIES NRH NO 89B (1935)
 SHEET 10 OF 36