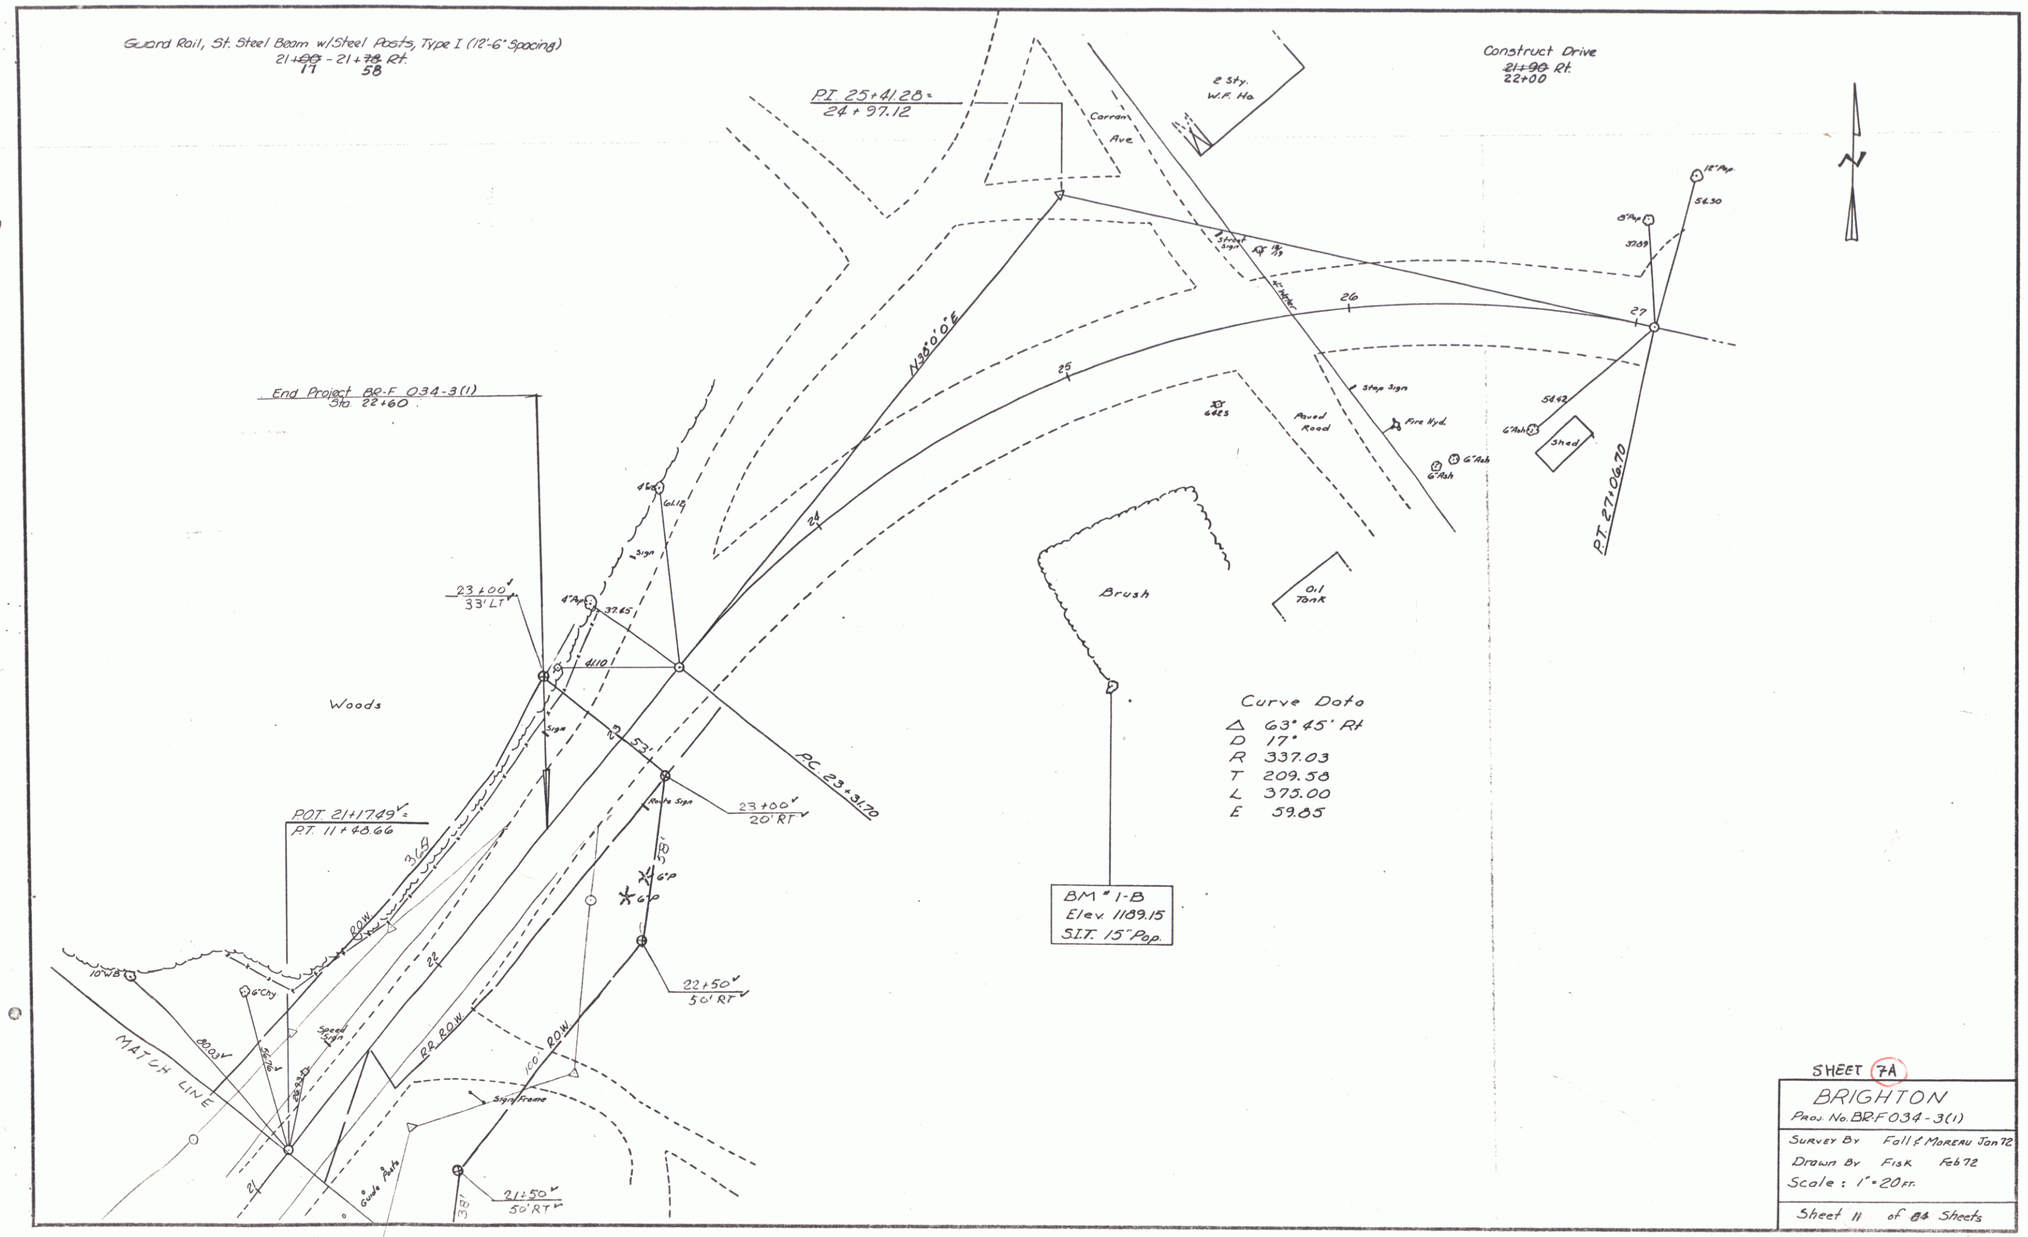

SHEET 7A

BRIGHTON

Proj. No. BR-F034-3(1)

Survey By Fall & Moreau Jan 72

Drawn By Fisk Feb 72

Scale : 1" = 20 ft.

Sheet 11 of 84 Sheets

D-8

9