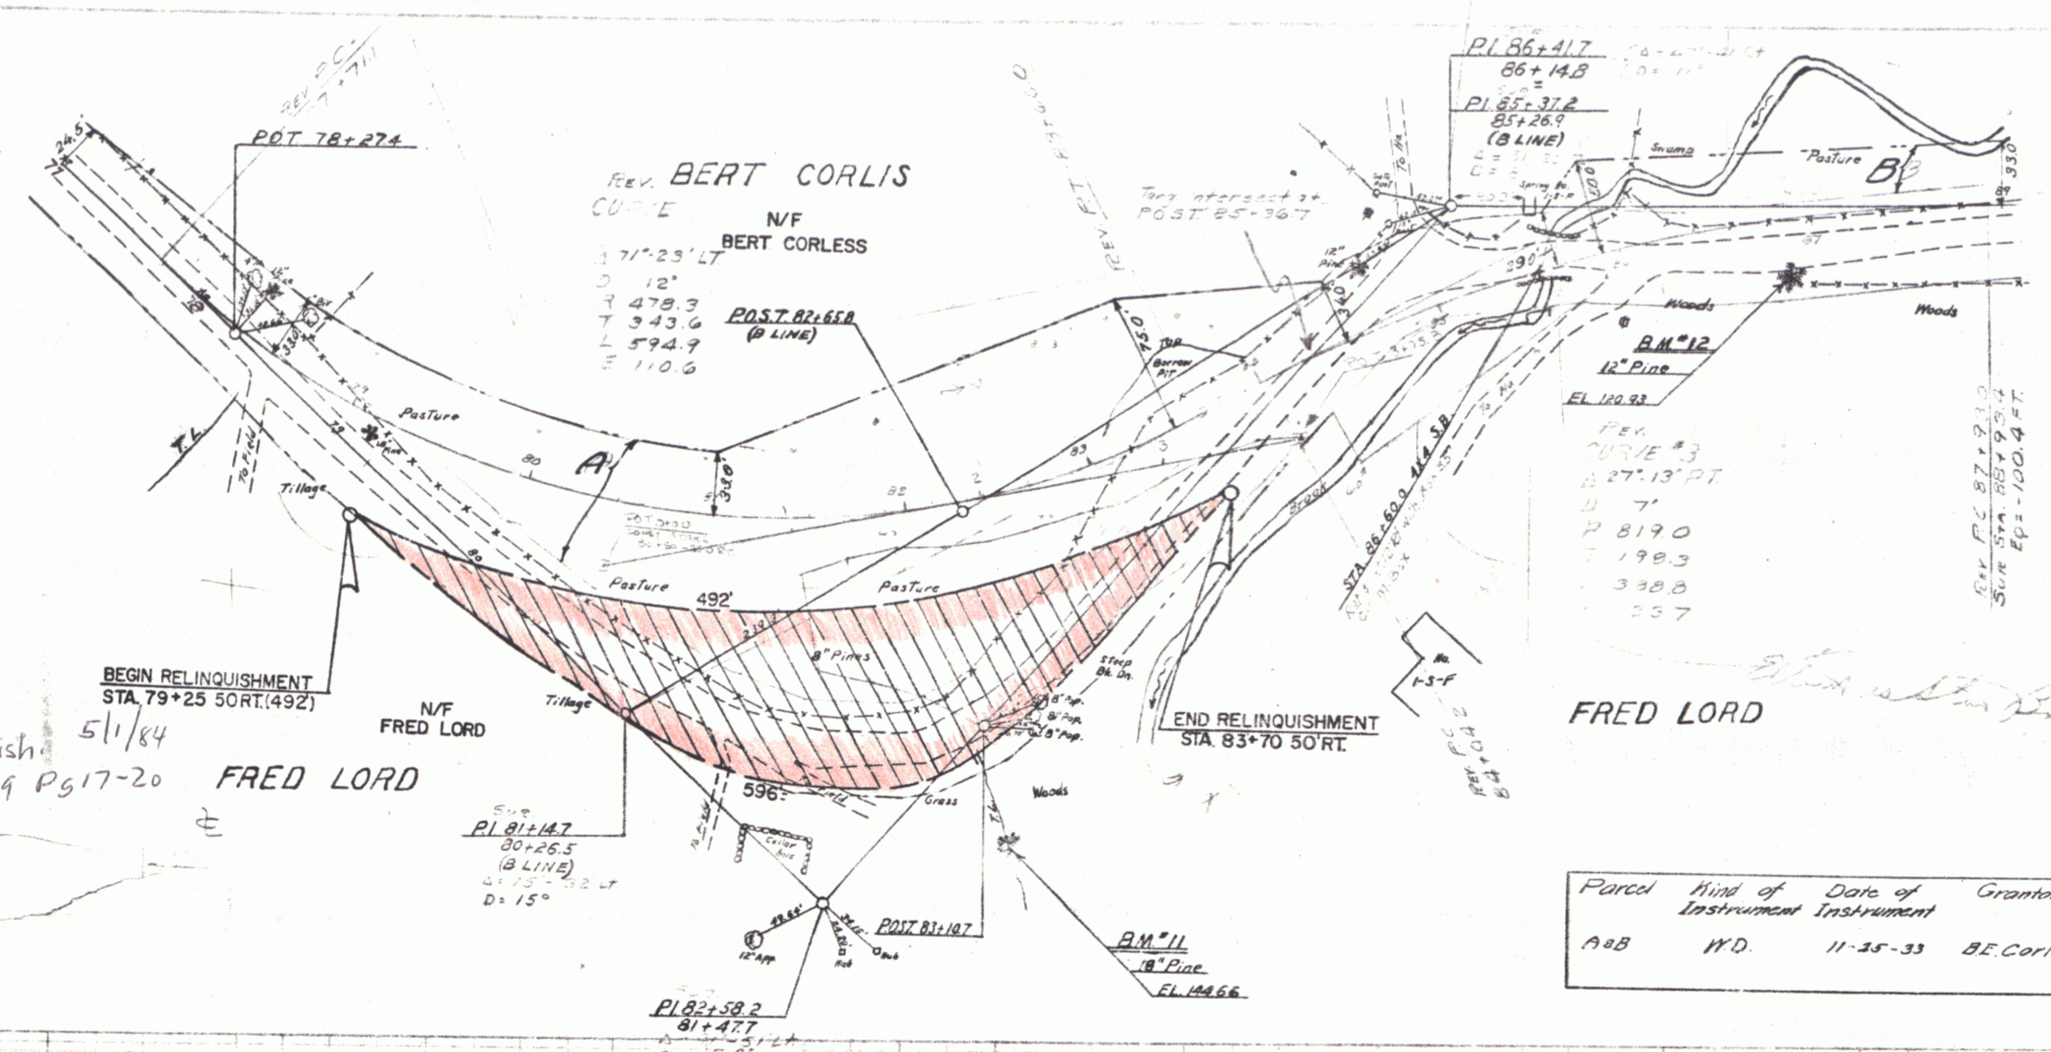

Parcel	Kind of Instrument	Date of Instrument	Grantor	Grantee	Recorded Brighton Book Page Date	Remarks
A&B	W.D.	11-25-33	B.E. Corliss	St. of Vt.	19 86-7 12-2-33	

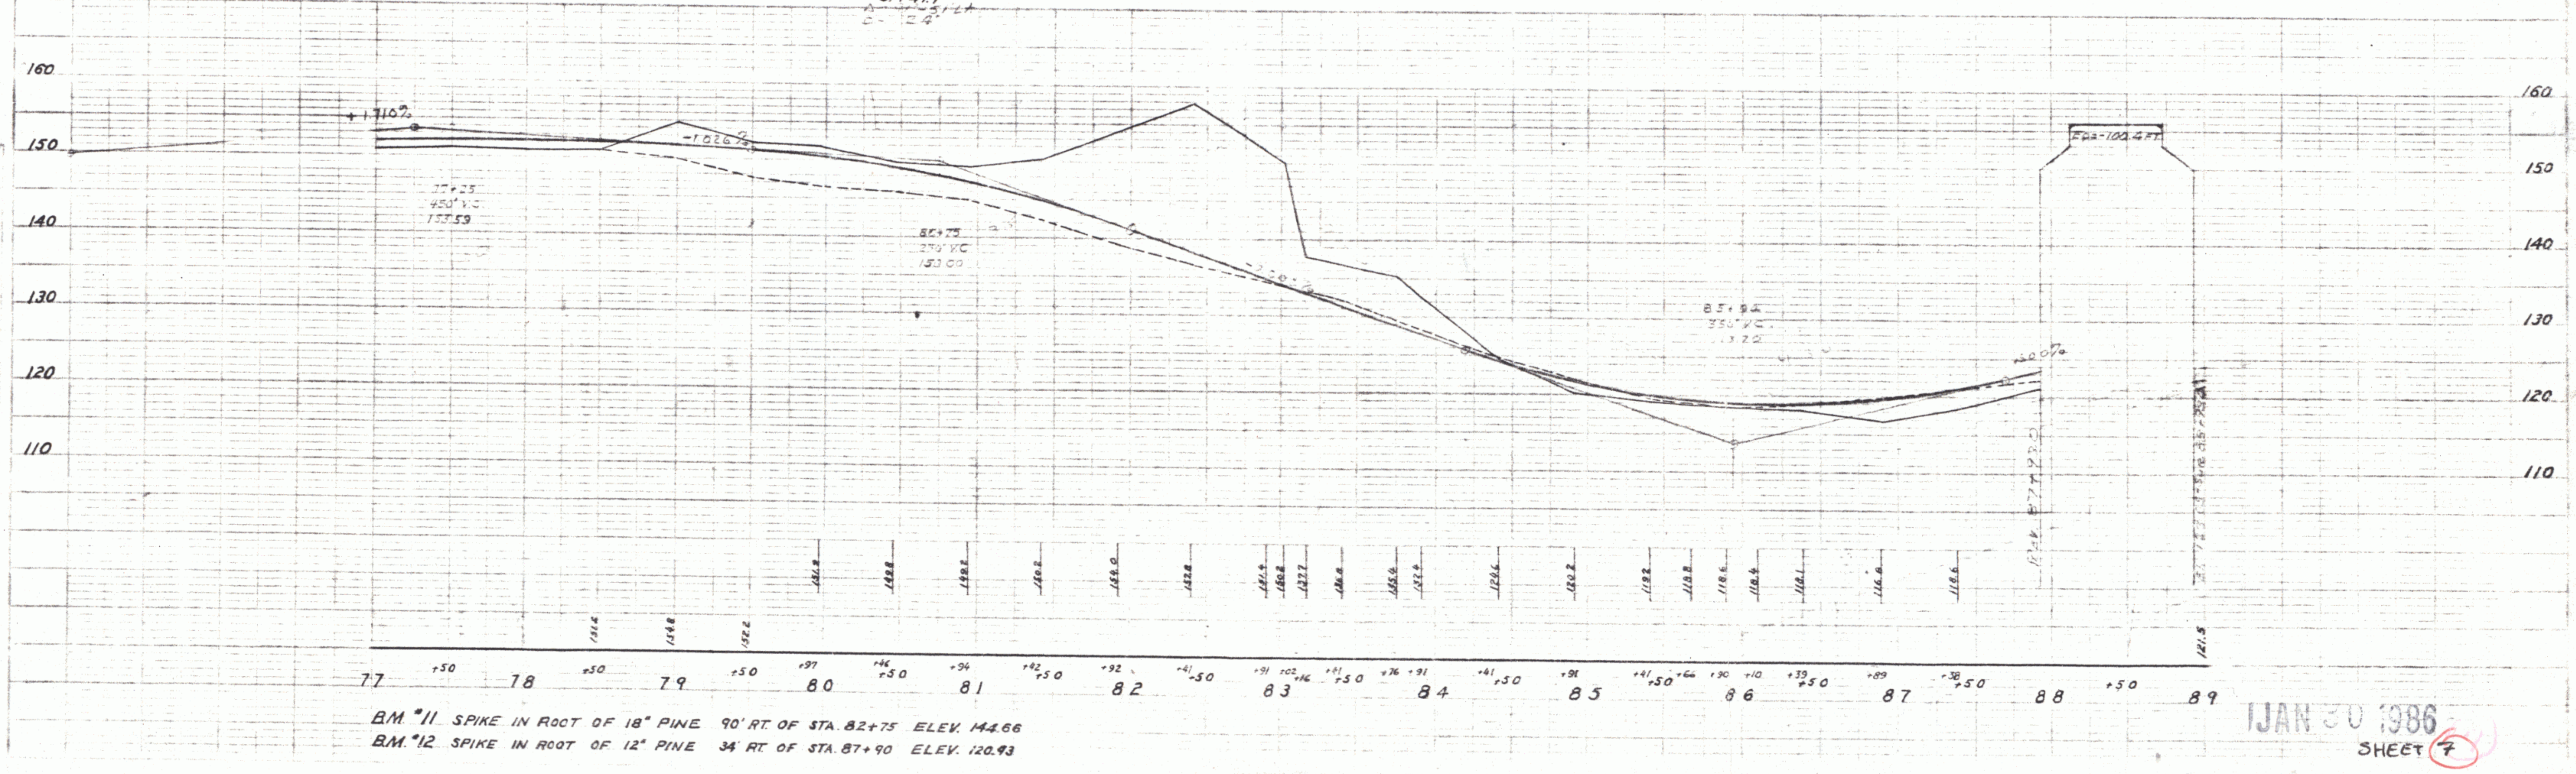

B.M. #11 SPIKE IN ROOT OF 18" PINE 90' RT. OF STA. 82+75 ELEV. 144.66
B.M. #12 SPIKE IN ROOT OF 12" PINE 34' RT. OF STA. 87+90 ELEV. 120.93

RIGHT-OF-WAY DIVISION
TOWN FILE
PERPETUAL
Town of Vt 105
(To Be Returned To R.O.W. Division)

JAN 30 1986

SHEET 7

6