Parcel	Kind of Instrument	Date of Instrument	Grantor	Grantee	Recorded Brighton Book/Page	Date	Remarks
F, G & H	W.D	5-18-34	Wm O. Bishop	Staff N.	19 158	5-18-34	

P.W.A. DOCKET 1161

139-M 1934 5 33

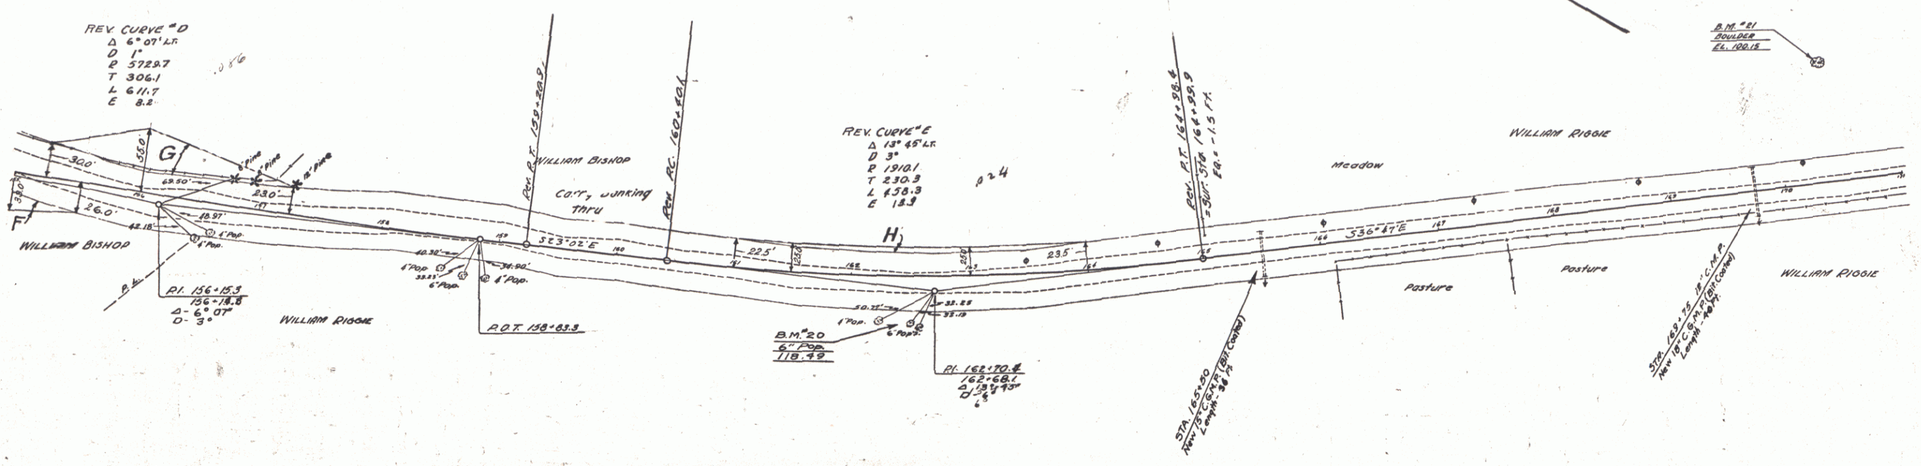

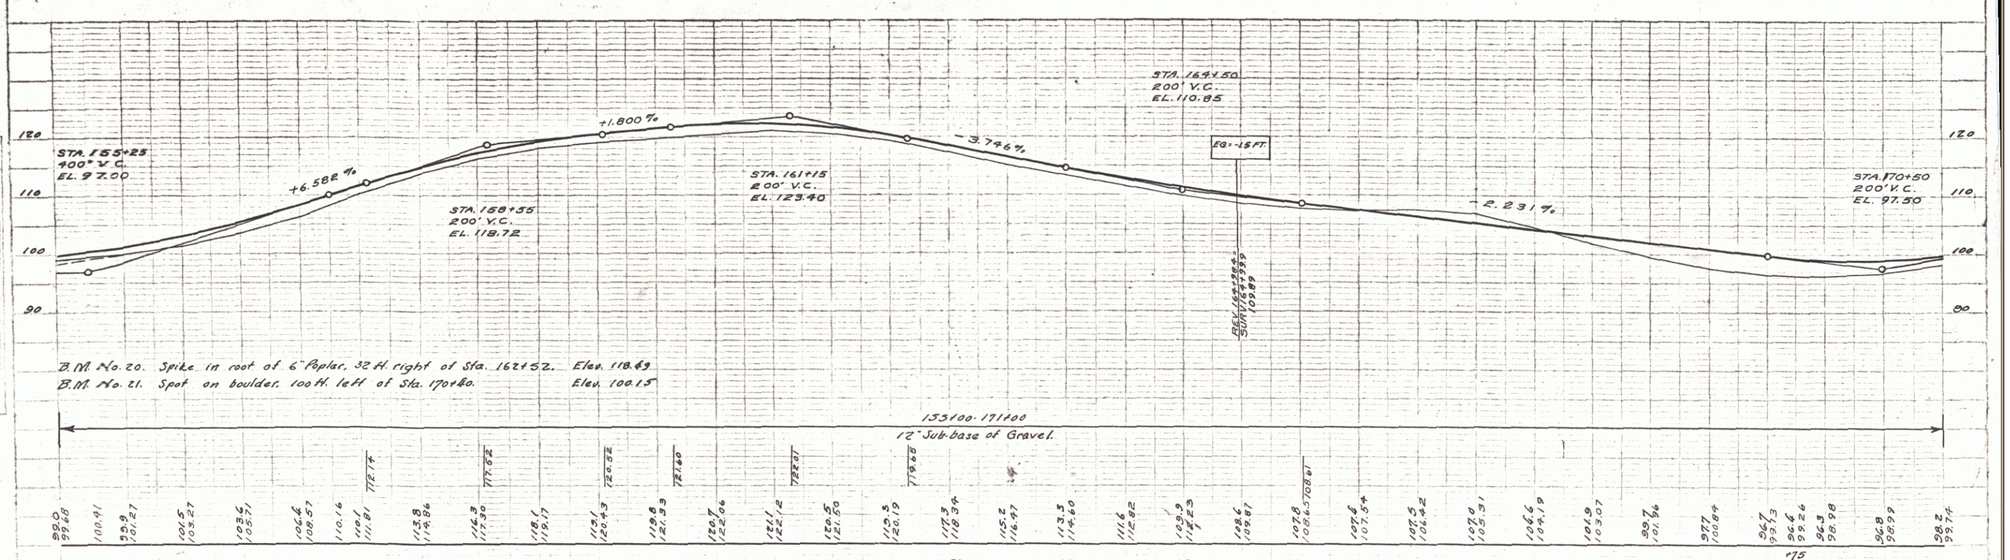

B.M. No. 20. Spike in root of 6" Poplar, 32 ft. right of Sta. 162+52. Elev. 118.49

B.M. No. 21. Spot on boulder, 100 ft. left of Sta. 170+80. Elev. 100.15

133+00 - 171+00

12" Sub-base of Gravel.


BRIGHTON EXTENSION - 139-M
SHEET 5 OF 33
P.W.A. Docket 1161

4