| FED. ROAD DIST. NO. | STATE | FED. AID PROJ. NO. | FISCAL YEAR | SHEET NO. | TOTAL SHEETS |
|---|---|---|---|---|---|
| 9 | Vt. | 139F(1) | 1941 | 9 | 112 |

Note: Sta 80+75 – 84+00 Poor foundation material to be excavated as shown on sections, see sheets #45 of 119, or as ordered by the engineer. P.F.M. to be used in flattening fill slopes between Sta 80+75 – 84+00 ft. or as directed by the engineer. P.F.M. excavation, stockpiling same and placing on slopes to be included in bid price for Common Excavation Including Borrow Item 10-11, measured in its original location.

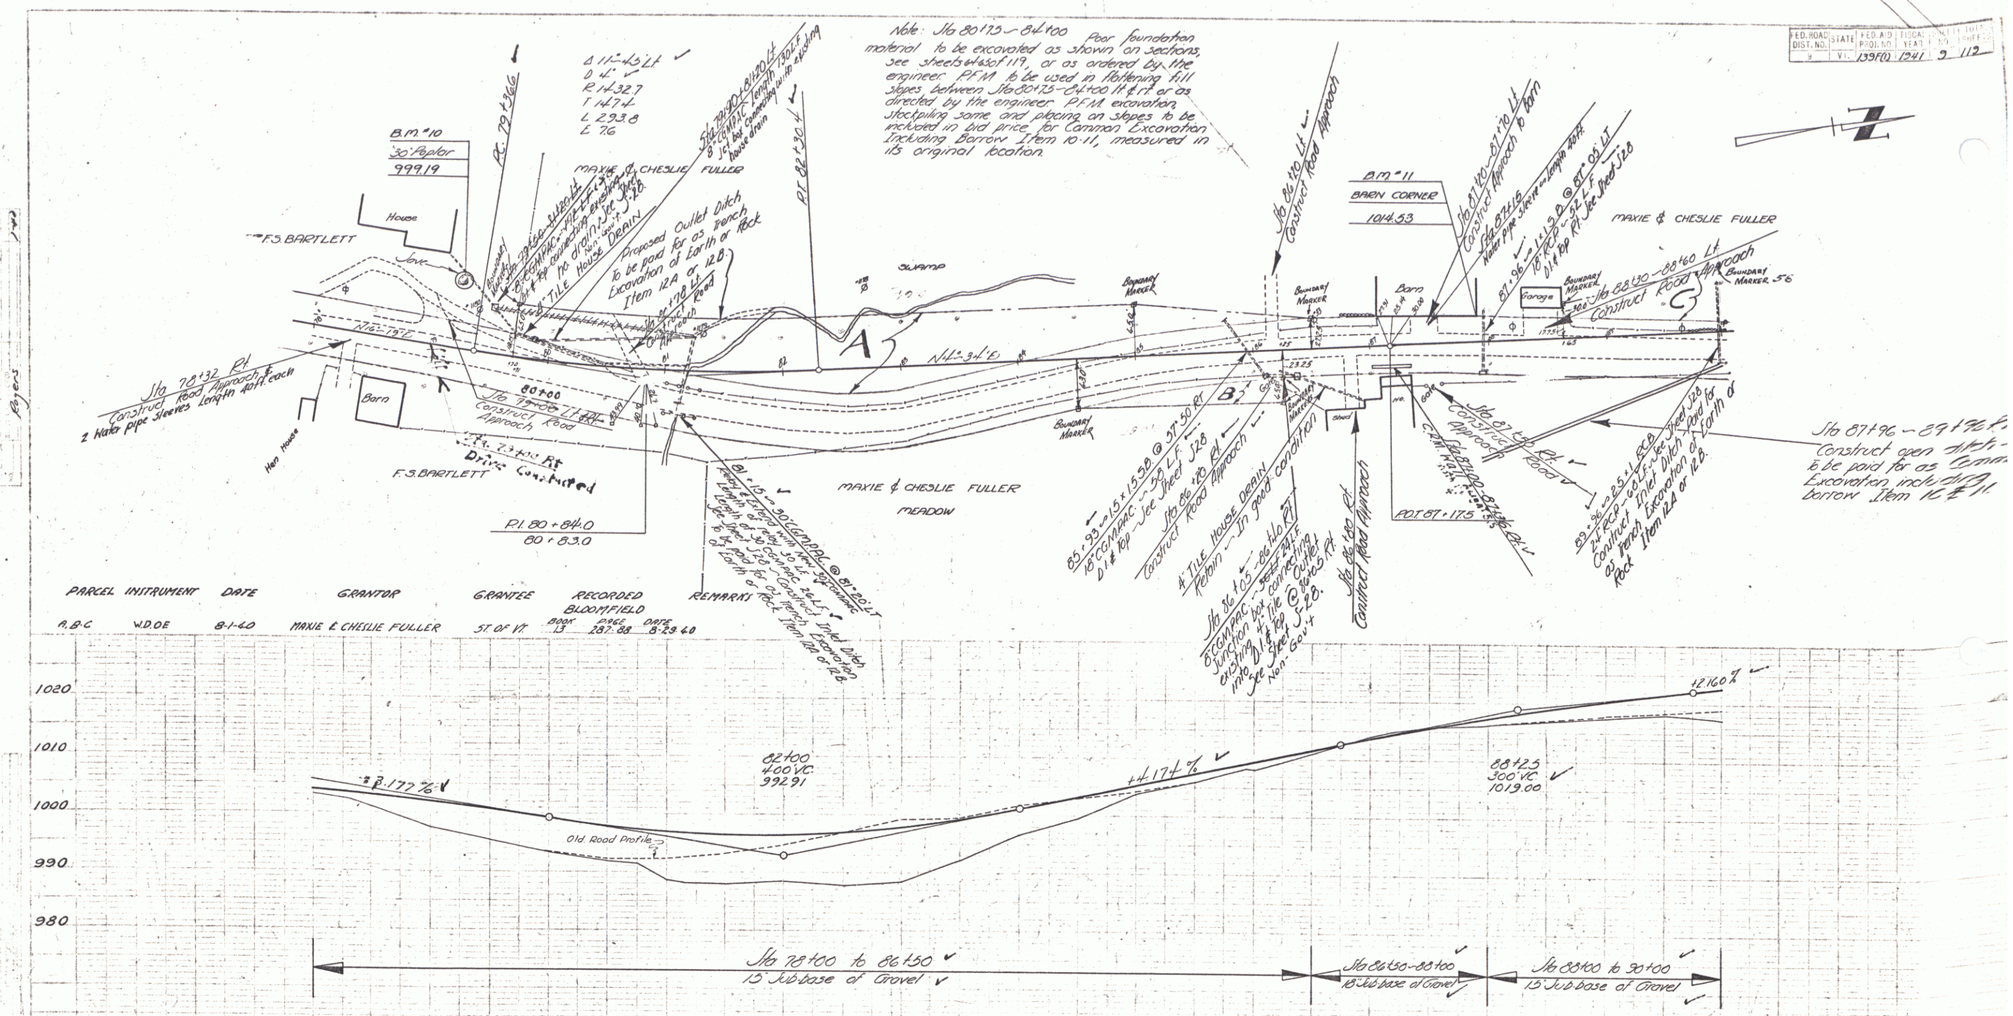
B.M. #10
30" Poplar
999.19
House
F.S. BARTLETT
Barn
Hen House
Sta 78+32 Rt
Construct Road Approach
2 Water pipe Sleeves Length 40 ft. each
Sta 79+66 Rt
Drive Constructed
Sta 80+00
Construct Approach Road
P.I. 80+84.0
80+83.0
Sta 79+96
Δ 11°-45' Lt
D 4°
R 1432.7
T 147.4
L 293.8
E 7.6
Sta 79+30 Lt
8" CMP Length 130 ft.
Sta 79+30 Lt
Proposed Outlet Ditch
To be paid for as Trench Excavation of Earth or Rock Item 12A or 12B
Sta 80+75 Lt
Construct Road
MAXIE & CHESLIE FULLER
Swamp
A
N 14° 34' E
Boundary Marker
MAXIE & CHESLIE FULLER
MEADOW
B
Sta 80+75 – 84+00 Rt
Construct Road Approach
Sta 80+75 Lt
Construct Road Approach
B.M. #11
BARN CORNER
1014.53
Barn
Garage
Shed
Sta 87+96 – 89+96 Lt
Construct open ditch to be paid for as Common Excavation including Borrow Item 10 & 11
