PROJECT	FEDERAL AID	STATE	FISCAL YEAR	SHEET NO.	TOTAL SHEETS
	139F(1)		1941	13	119

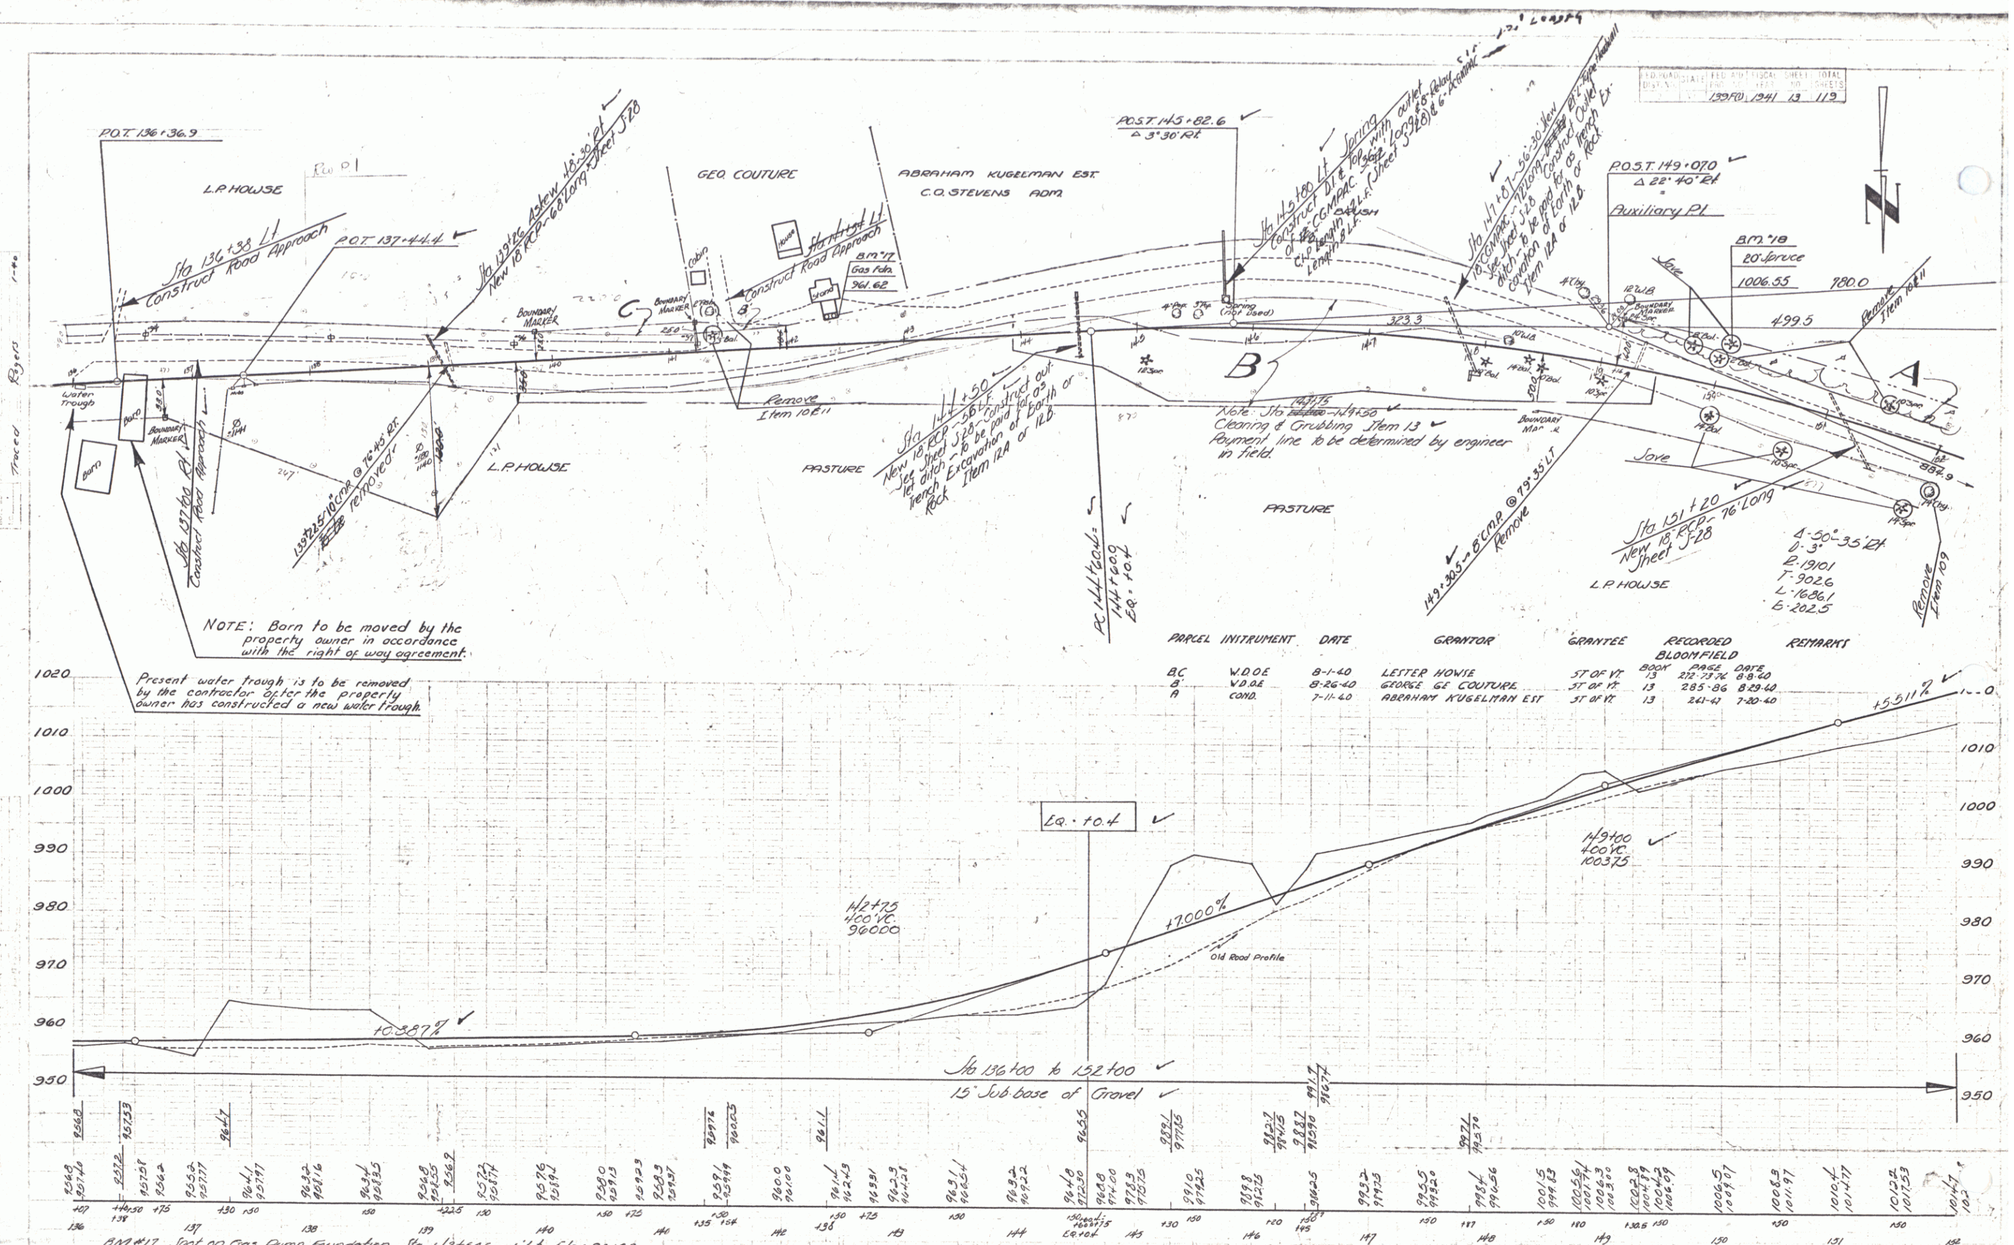

NOTE: Barn to be moved by the property owner in accordance with the right of way agreement.

Present water trough is to be removed by the contractor after the property owner has constructed a new water trough.

PARCEL	INSTRUMENT	DATE	GRANTOR	GRANTEE	RECORDED BLOOMFIELD BOOK	PAGE	DATE	REMARKS
B.C.	W.D.O.E.	8-1-40	LESTER HOWIE	ST OF VT	13	272-73	8-8-40	
B'	W.D.O.E.	8-26-40	GEORGE G. COUTURE	ST OF VT	13	285-86	8-29-40	
A	COND.	7-11-40	ABRAHAM KUGELMAN EST	ST OF VT	13	261-62	7-20-40	