PARCEL	INSTRUMENT	DATE	GRANTOR	GRANTEE	RECORDED BLOOMFIELD BOOK	PAGE	DATE	REMARKS
A	QCD	8-2-60	N.H.-VT. LUMBER CO	ST OF VT	13	281-286	8-24-60	1 Cut.

FED. ROAD DIST. NO.	STATE	FED. AID PROJ. NO.	FISCAL YEAR	SHEET NO.	TOTAL SHEETS
	VT.	139F(1)	1941	14	119

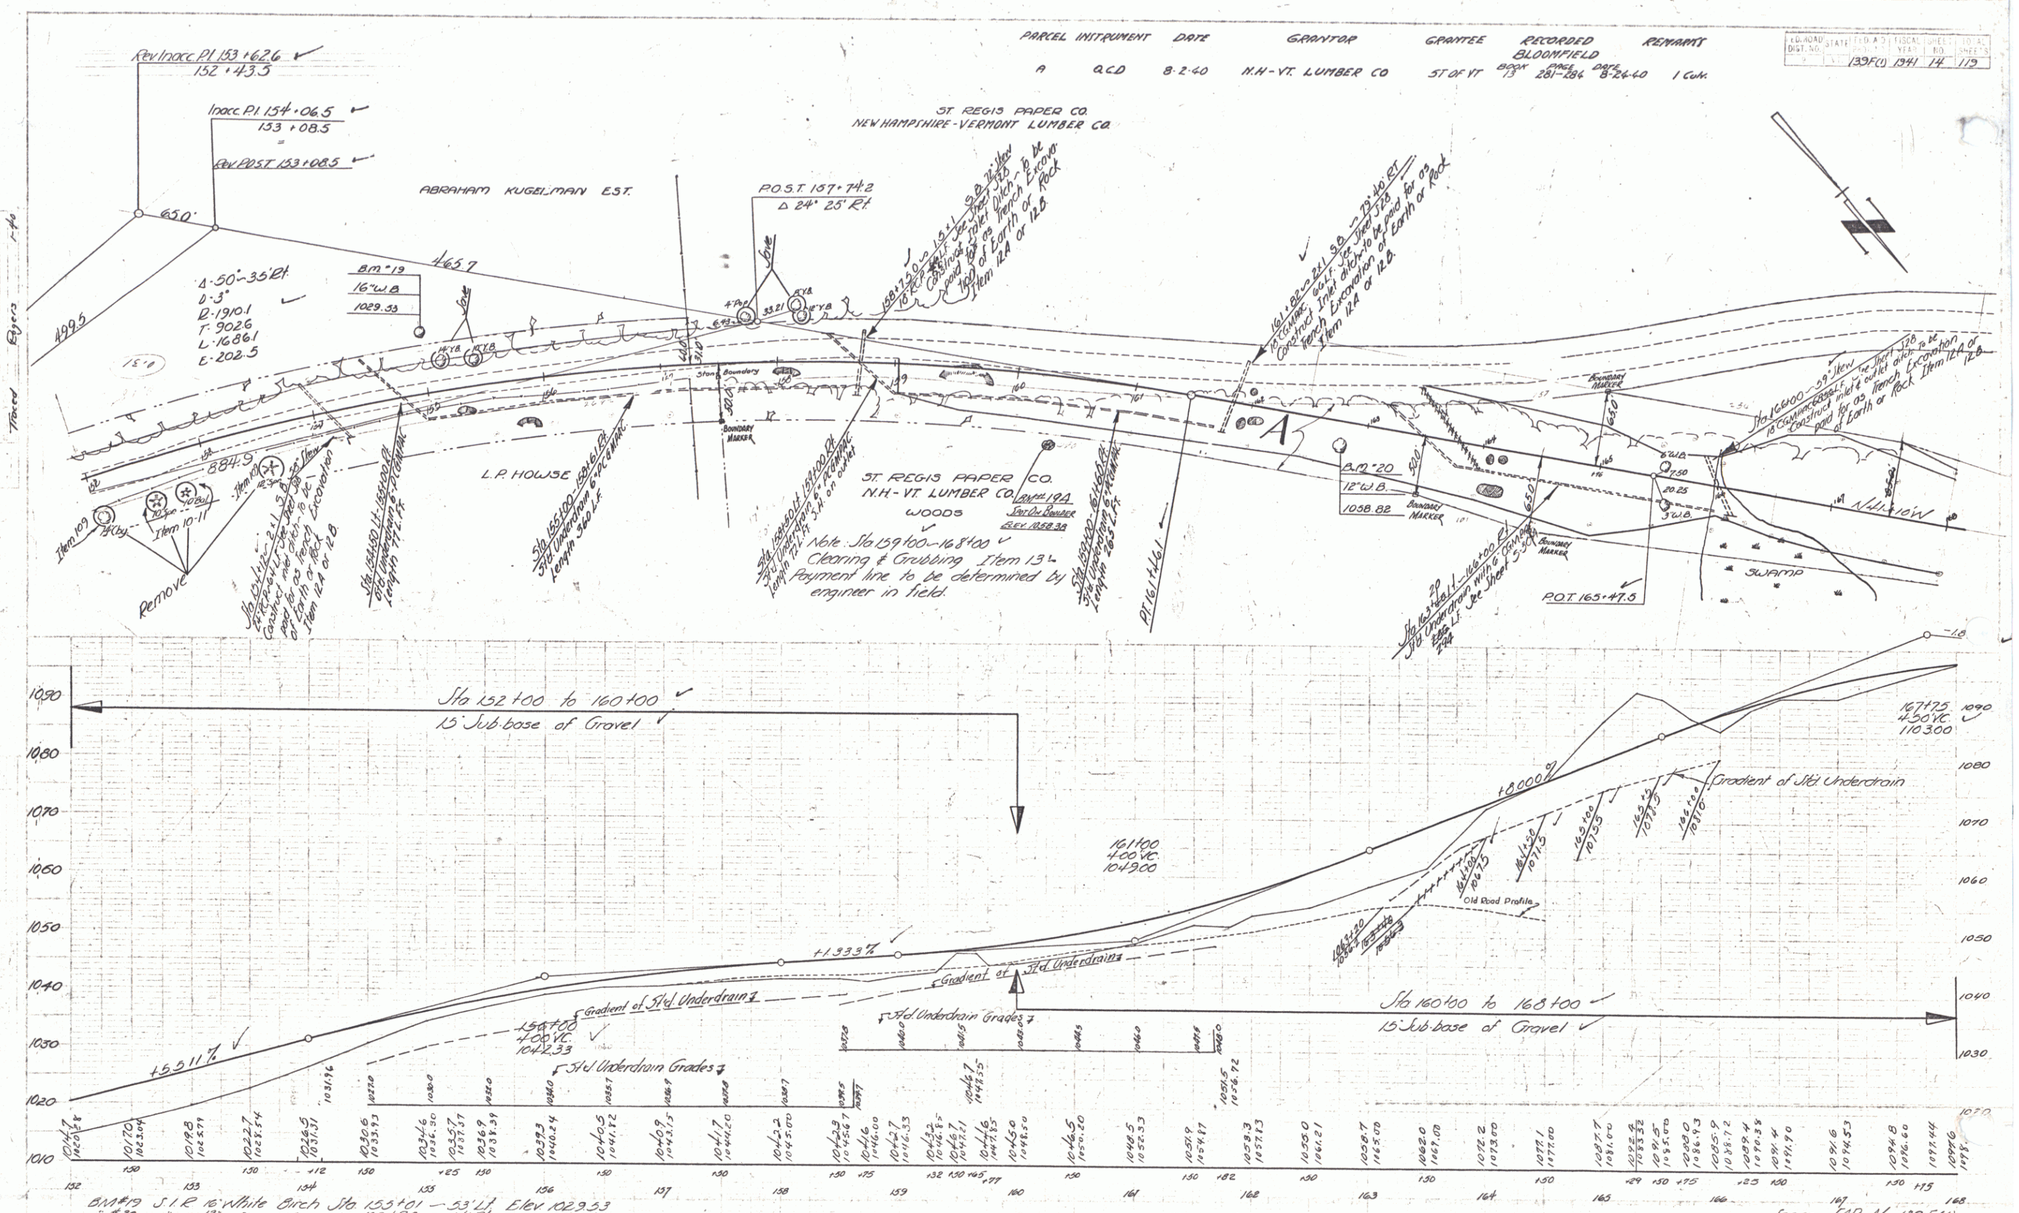
Rev Inacc P.I. 153+62.6
152+43.5
Inacc P.I. 154+06.5
153+08.5
Rev P.O.S.T. 153+08.5
ST. REGIS PAPER CO.
NEW HAMPSHIRE-VERMONT LUMBER CO.
ABRAHAM KUGELMAN EST.
P.O.S.T. 157+74.2
Δ 24° 25' Rt.
Δ 50°-35' Rt.
D 3°
R 1910.1
T 902.6
L 1686.1
E 202.5
465.7
884.9
L.P. HOWSE
ST. REGIS PAPER CO.
N.H.-VT. LUMBER CO.
WOODS
Note: Sta 159+00 - 168+00
Clearing & Grubbing Item 13
Payment line to be determined by engineer in field.
Remove
Item 10-11
Item 10-9
Item 12A or 12B
Item 12A or 12B
Item 12A or 12B