


PARCEL INSTRUMENT DATE	GRANTOR	GRANTEE	RECORDED BLOODFIELD PAGE DATE	REMARKS
B.C. Q.C.D. 8-2-40	N.H.-VT LUMBER CO	ST REGIS PAPER CO	13 281-284 8-22-40	1 cut

PLD ROAD	STAT	PLD AID	PLD SHEET	TOTAL SHEETS
3	139	10	16	112

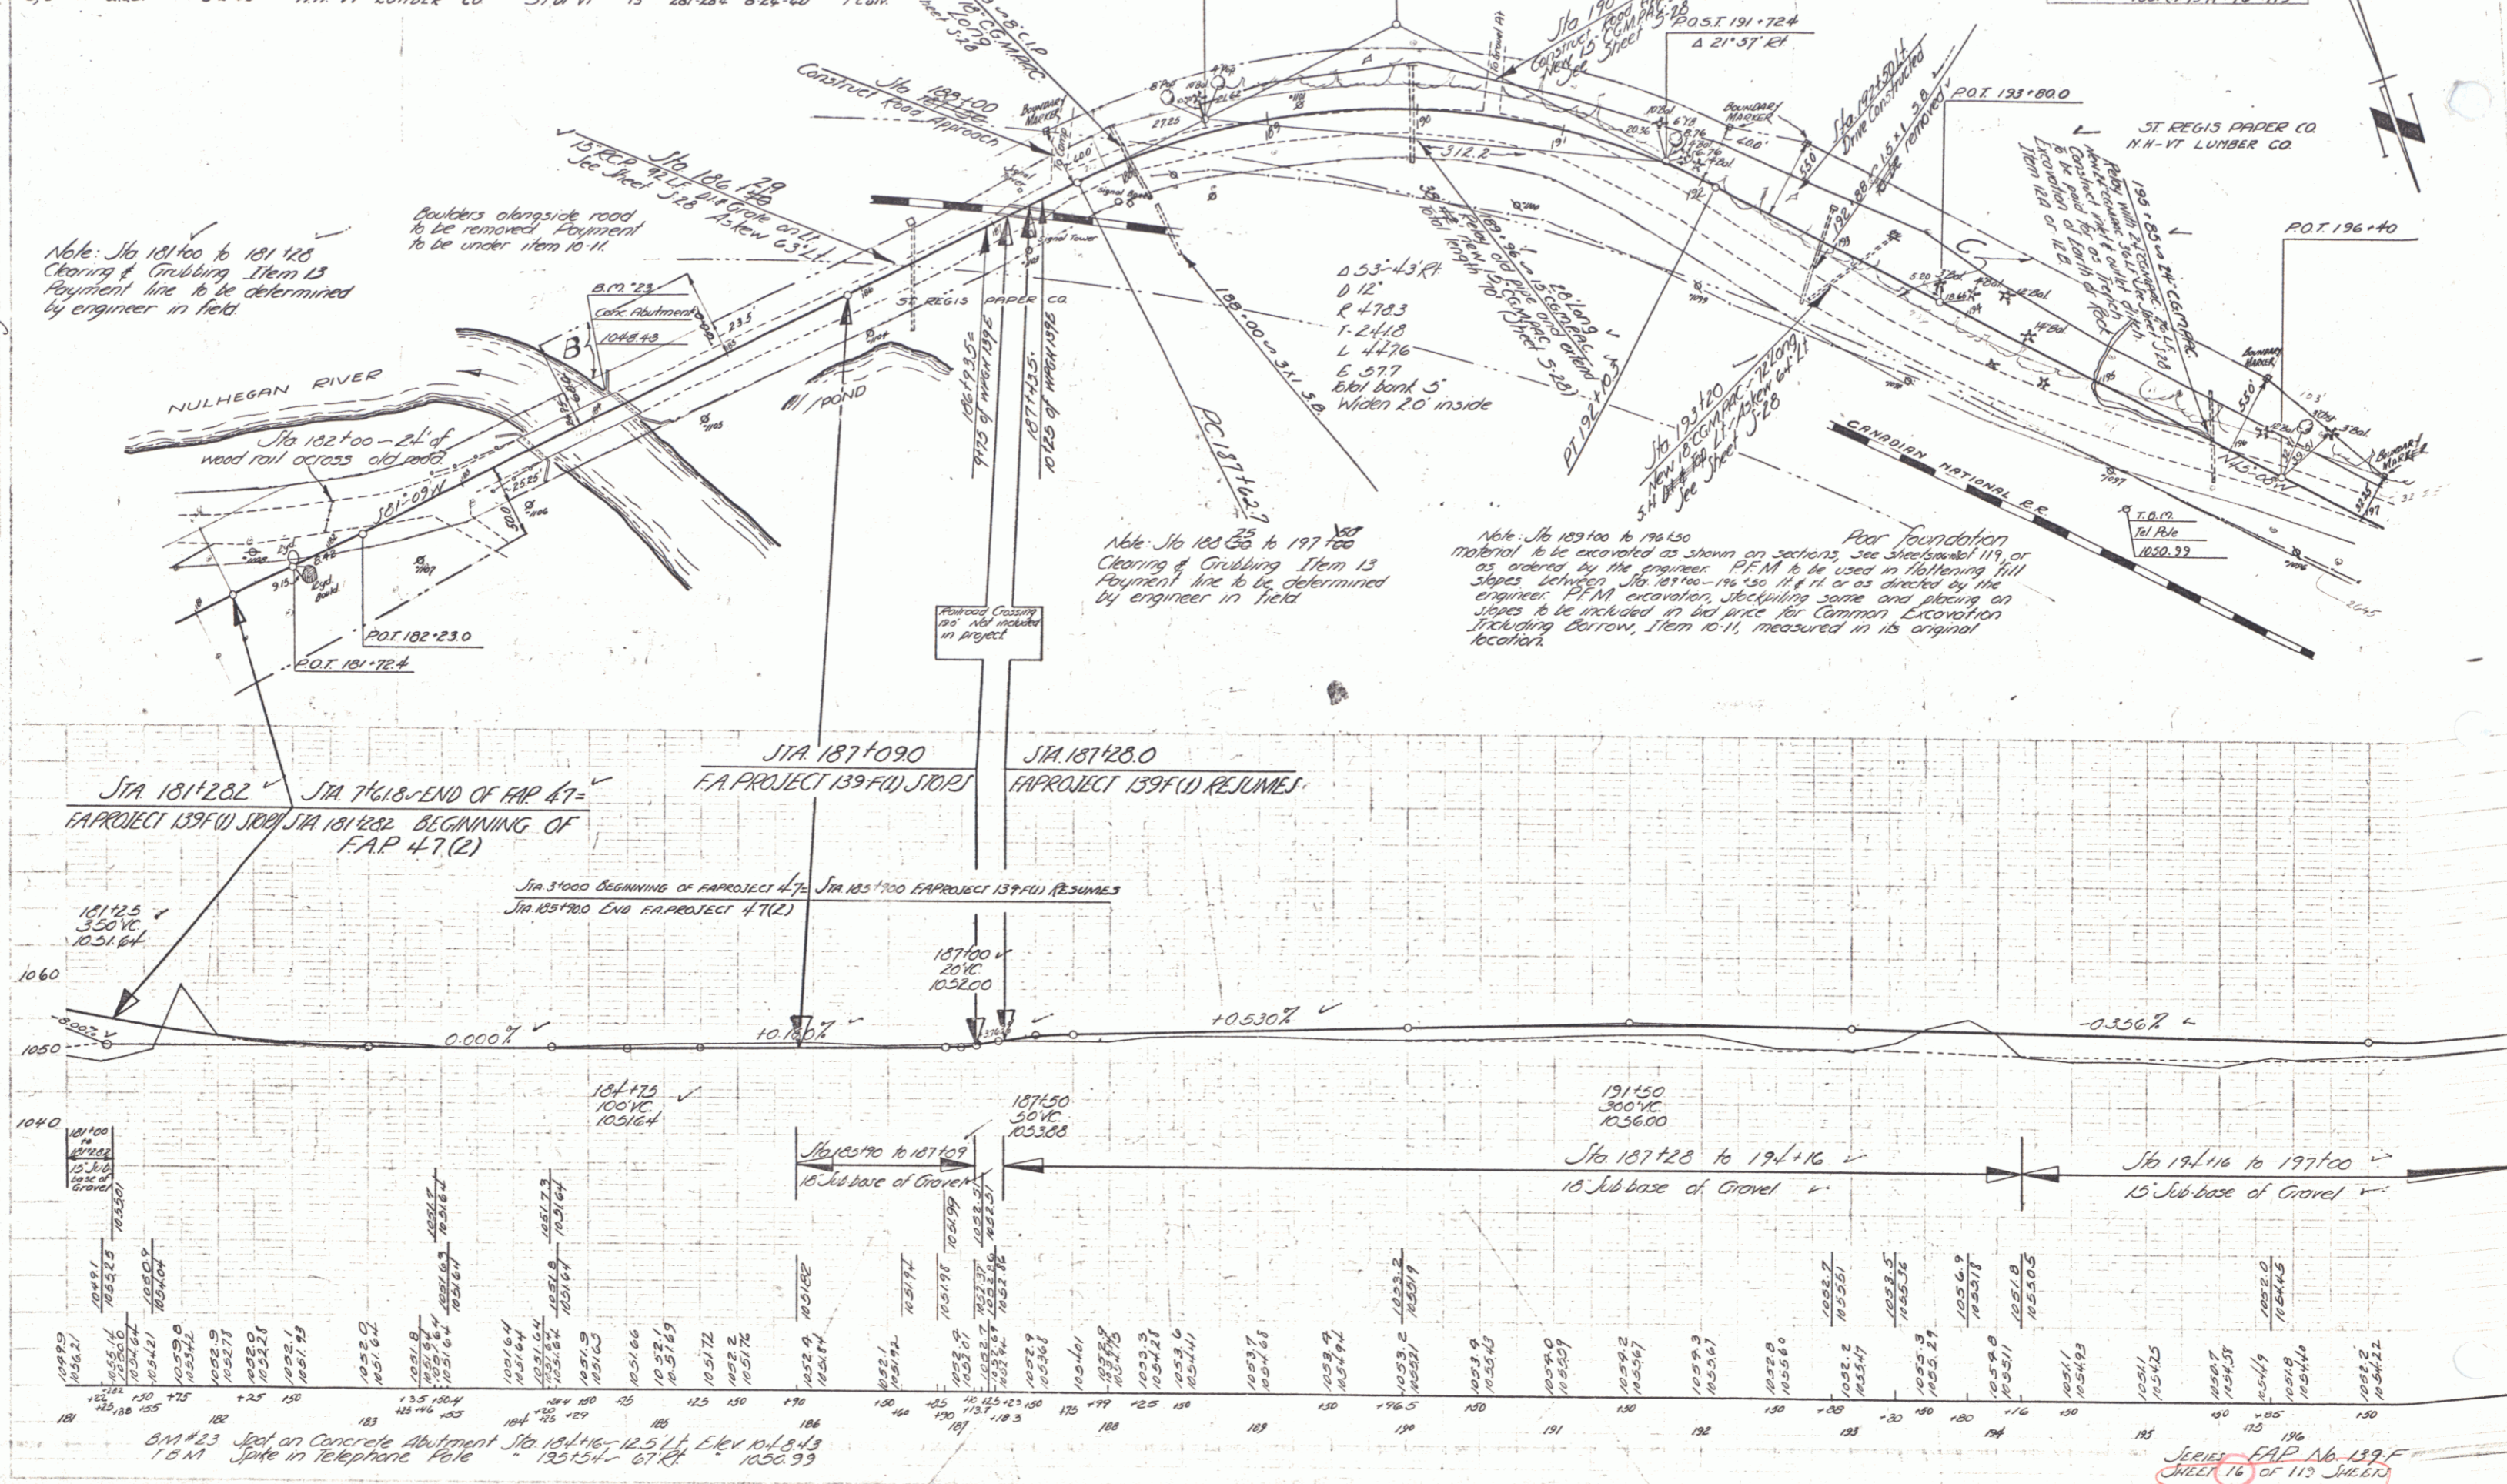

Survey
 Project
 1895


Sheets F.A.P. No. 139 F
 Sheet 16 of 112 sheets