PARCEL	INSTRUMENT	DATE	GRANTOR	GRANTEE	RECORDED BLOOMFIELD BOOK	PAGE	DATE	REMARKS
D.E	Q.C.D	8-24-40	N.H.-VT LUMBER CO.	ST OF VT	73	281-284	8-24-40	

ST. REGIS PAPER CO
N.H.-VT LUMBER CO.

Note: Sta 212+00 to 223+50
Clearing & Grubbing Item 13
Payment line to be determined by engineer in field

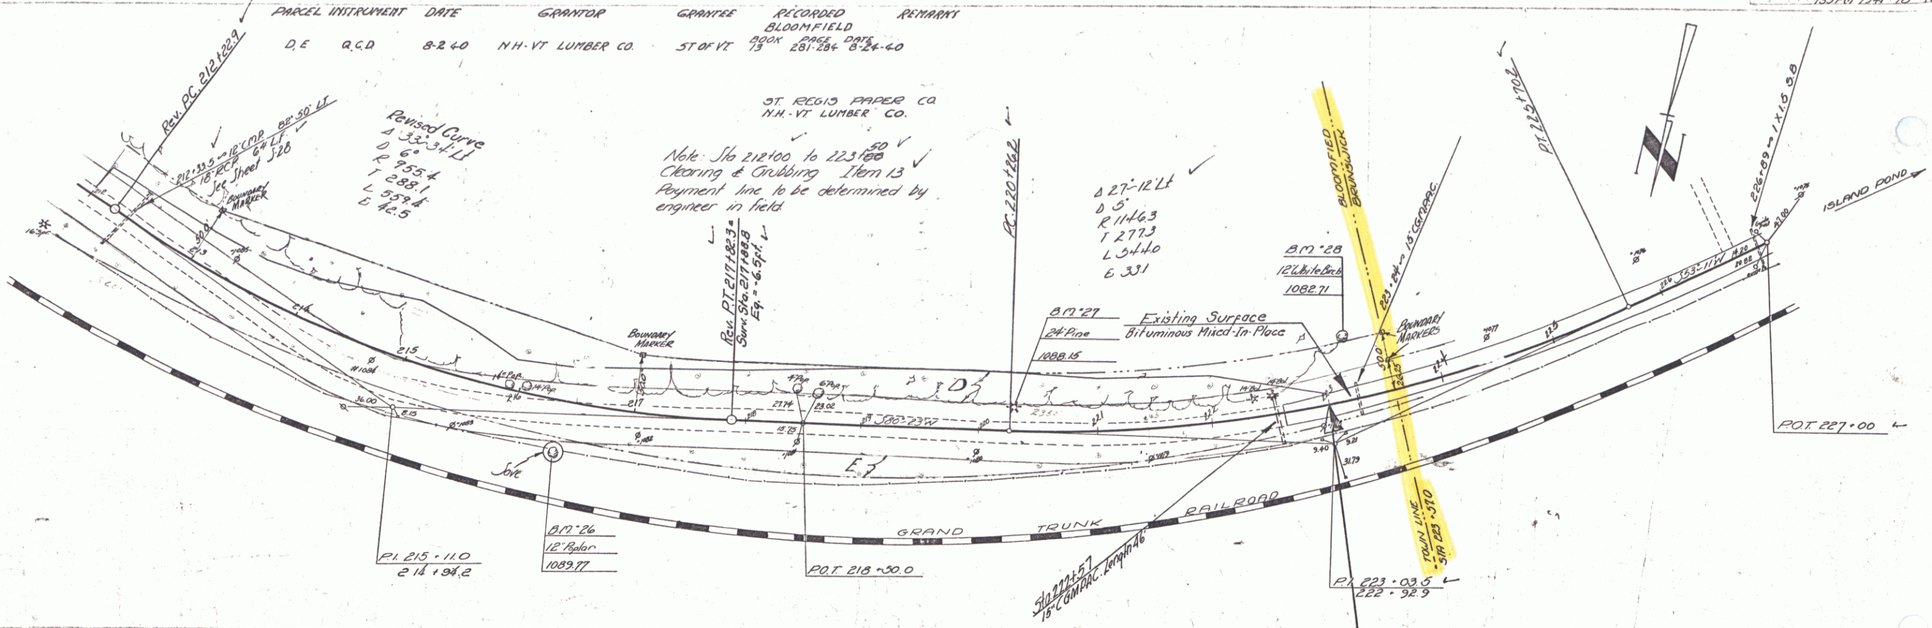

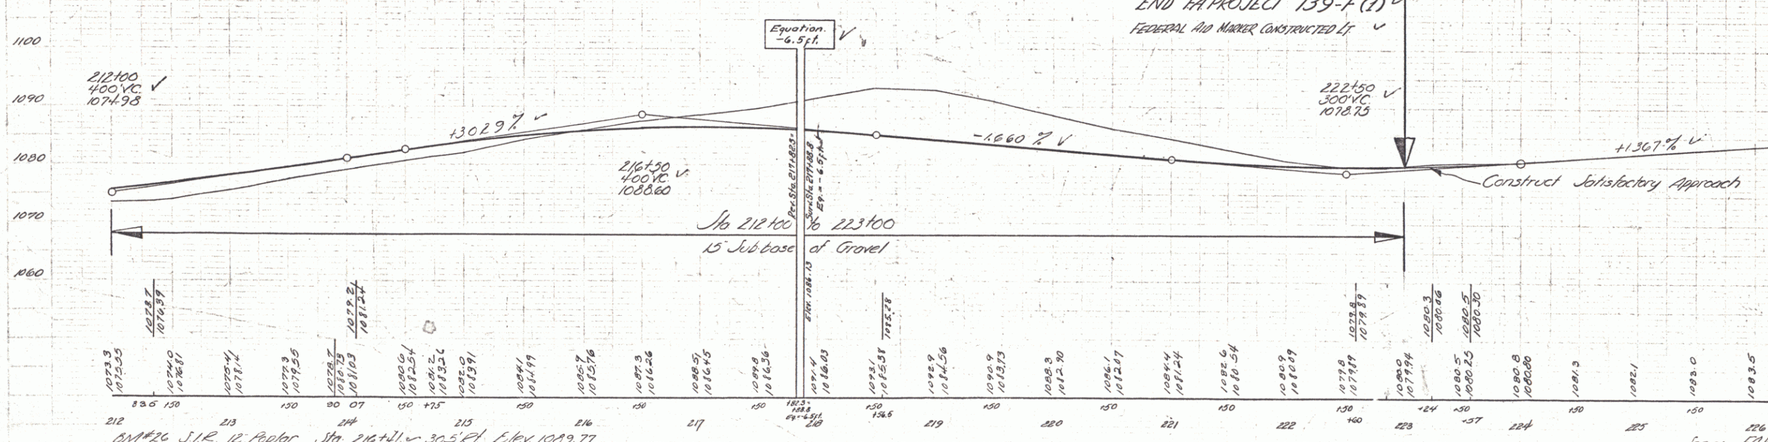

Series FAP No. 139-F(1)
Sheet 18 of 115 Sheets

16