Town of Bloomfield
Pin # COR190
Route # VT105
Project # SN FAP 296(1)
Date 9/19/1945

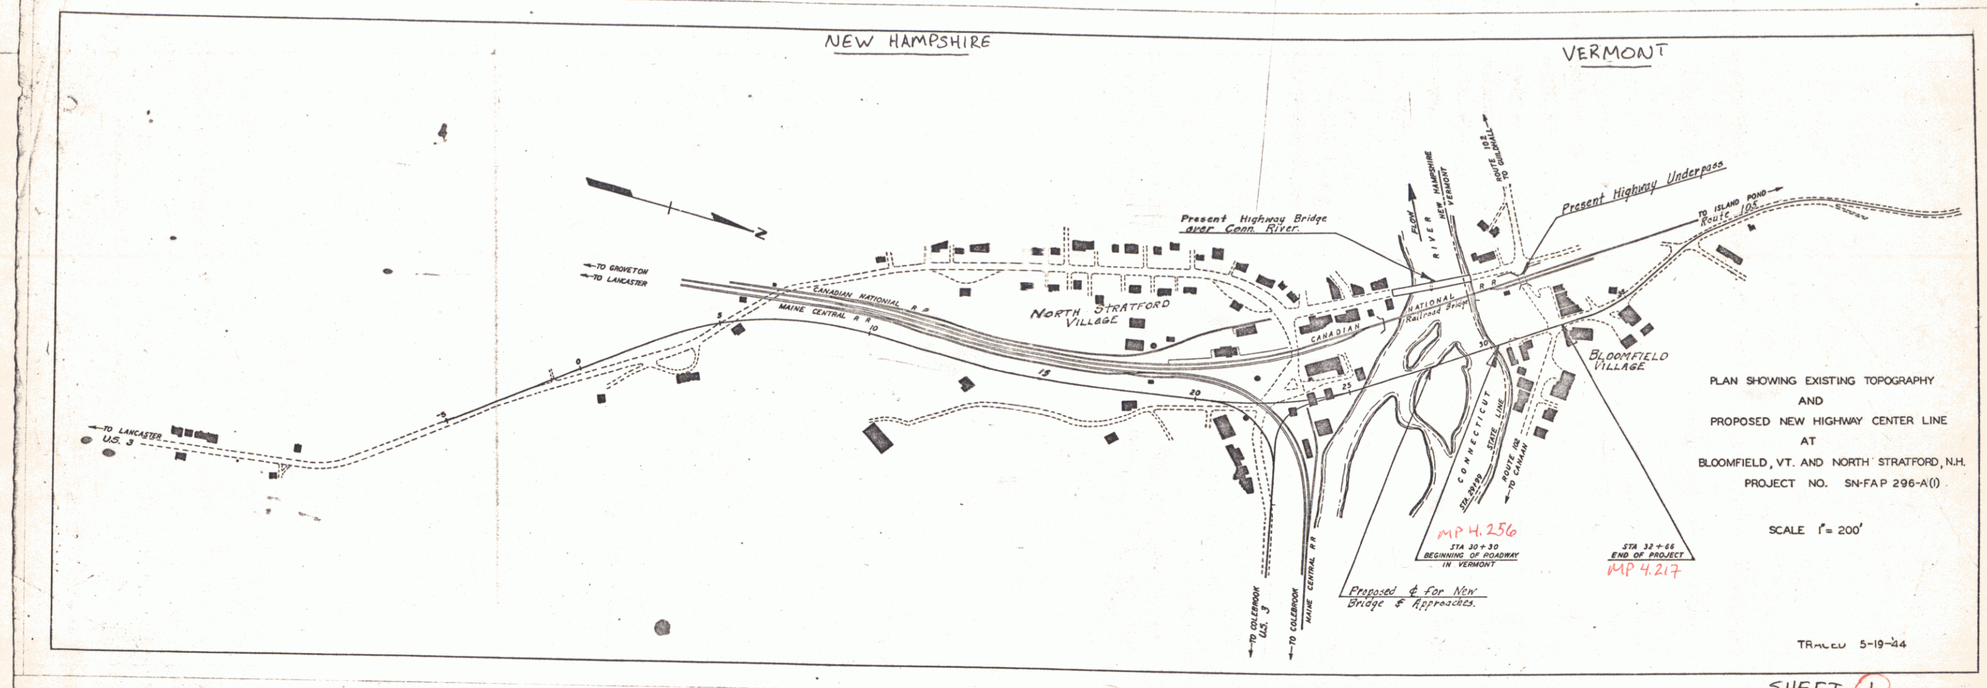

SHEET 1

Date 9/19/45
Pin # COR190
VT # 105
Proj # VT FAP 296(1)
Bloomfield