POOR ORIGINAL COPY

STATE OF VERMONT
DEPARTMENT OF HIGHWAYS

PROPOSED IMPROVEMENT

Bridge green box

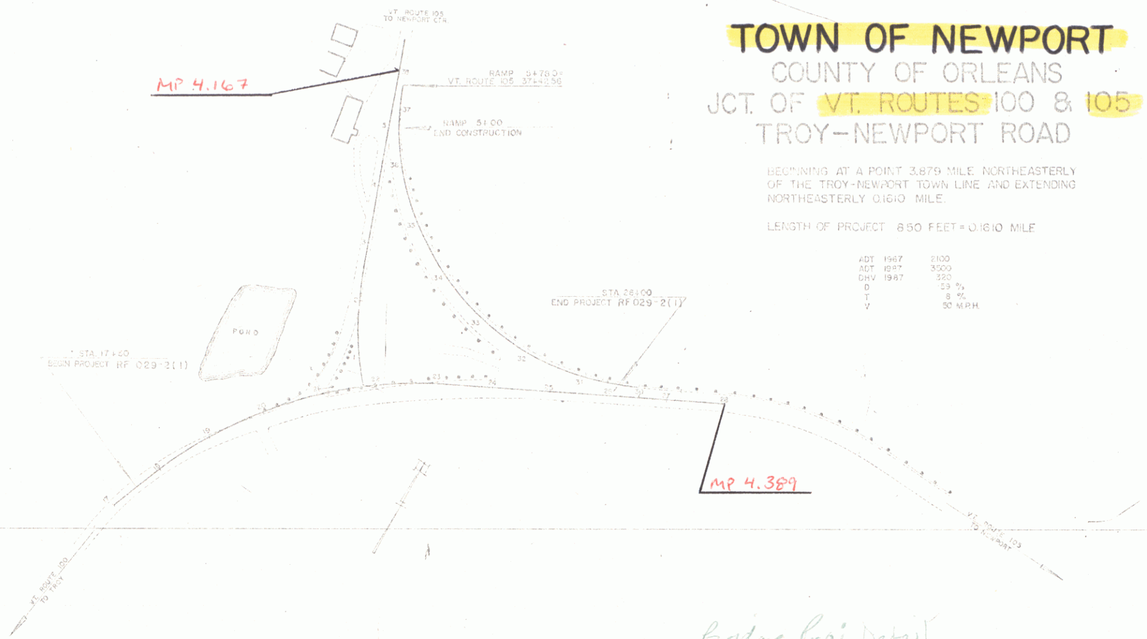

TOWN OF NEWPORT
COUNTY OF ORLEANS
JCT. OF VT. ROUTES 100 & 105
TROY–NEWPORT ROAD

BEGINNING AT A POINT 3.879 MILE NORTHEASTERLY OF THE TROY-NEWPORT TOWN LINE AND EXTENDING NORTHEASTERLY 0.1610 MILE.

LENGTH OF PROJECT 850 FEET = 0.1610 MILE

ADT 1967	2100
ADT 1987	3500
DHV 1967	550
D	59 %
T	8 %
V	50 M.P.H.

Date: 8/1/66
Project: BP 034-2-6611
Pin # 00R193

RIGHT-OF-WAY DIVISION
TOWN FILE
PERPETUAL
~~Rte~~ ~~Town~~ of VT 105
(To Be Returned To R.O.W. Division)

CONVENTIONAL SIGNS

POINT OF ACCESS X
LIMITS OF ACCESS
CENTER LINE
TOWN LINE
FENCE LINE
STONE WALL
WIRELESS PATCHEY
BRIDGE
TRAVELED WAY
RAILROAD
RETAINING WALL
CENTER LINE
SHOULDER LINE
CULVERT
STOP SIGN
SHEET
DATUM

SLOPE RIGHTS SR SR

GROUND ELEVATION DATUM
GRADE ELEVATION DATUM

CURVE DATA
DEFLECTION OF ANGLE Δ
DEGREE OF CURVE D
RADIUS OF CURVE R
TANGENT DISTANCE T
LENGTH OF CURVE L
EXTERNAL DISTANCE E
POINT OF CURVATURE PC
POINT OF CURVE PC
POINT OF TANGENCY POT
POINT OF TANGENCY POT

FOR RIGHT OF WAY DETAILS, SEE RIGHT OF WAY PLANS FOR THIS PROJECT.

Bridge Proj. Detail
BP 034-2-6611

For Roadway Proj. (See RF 029-2(1)) PIN 00R192

034-2-6611

THESE PLANS ARE SUBJECT TO SUCH REVISIONS AS MAY BE REQUIRED BY THE BUREAU OF PUBLIC ROADS OR THE COMMISSIONER OF HIGHWAYS.

CONSTRUCTION TO BE PERFORMED ONLY IN ACCORDANCE WITH THESE PLANS, THE STANDARD SPECIFICATIONS FOR HIGHWAY AND BRIDGE CONSTRUCTION, DATED 1956, ADOPTED BY THE DEPARTMENT OF PUBLIC WORKS OF VERMONT, THEIR AMENDMENTS AND SUPPLEMENTS, AND THE SPECIAL PROVISIONS, SPECIAL PROVISIONS AND SPECIAL NOTES, IF ANY, ATTACHED HERETO AND MADE A PART HEREOF.

DEPARTMENT OF CONSTRUCTION
BUREAU OF PUBLIC ROADS
APPROVED

APPROVED
APPROVED
APPROVED