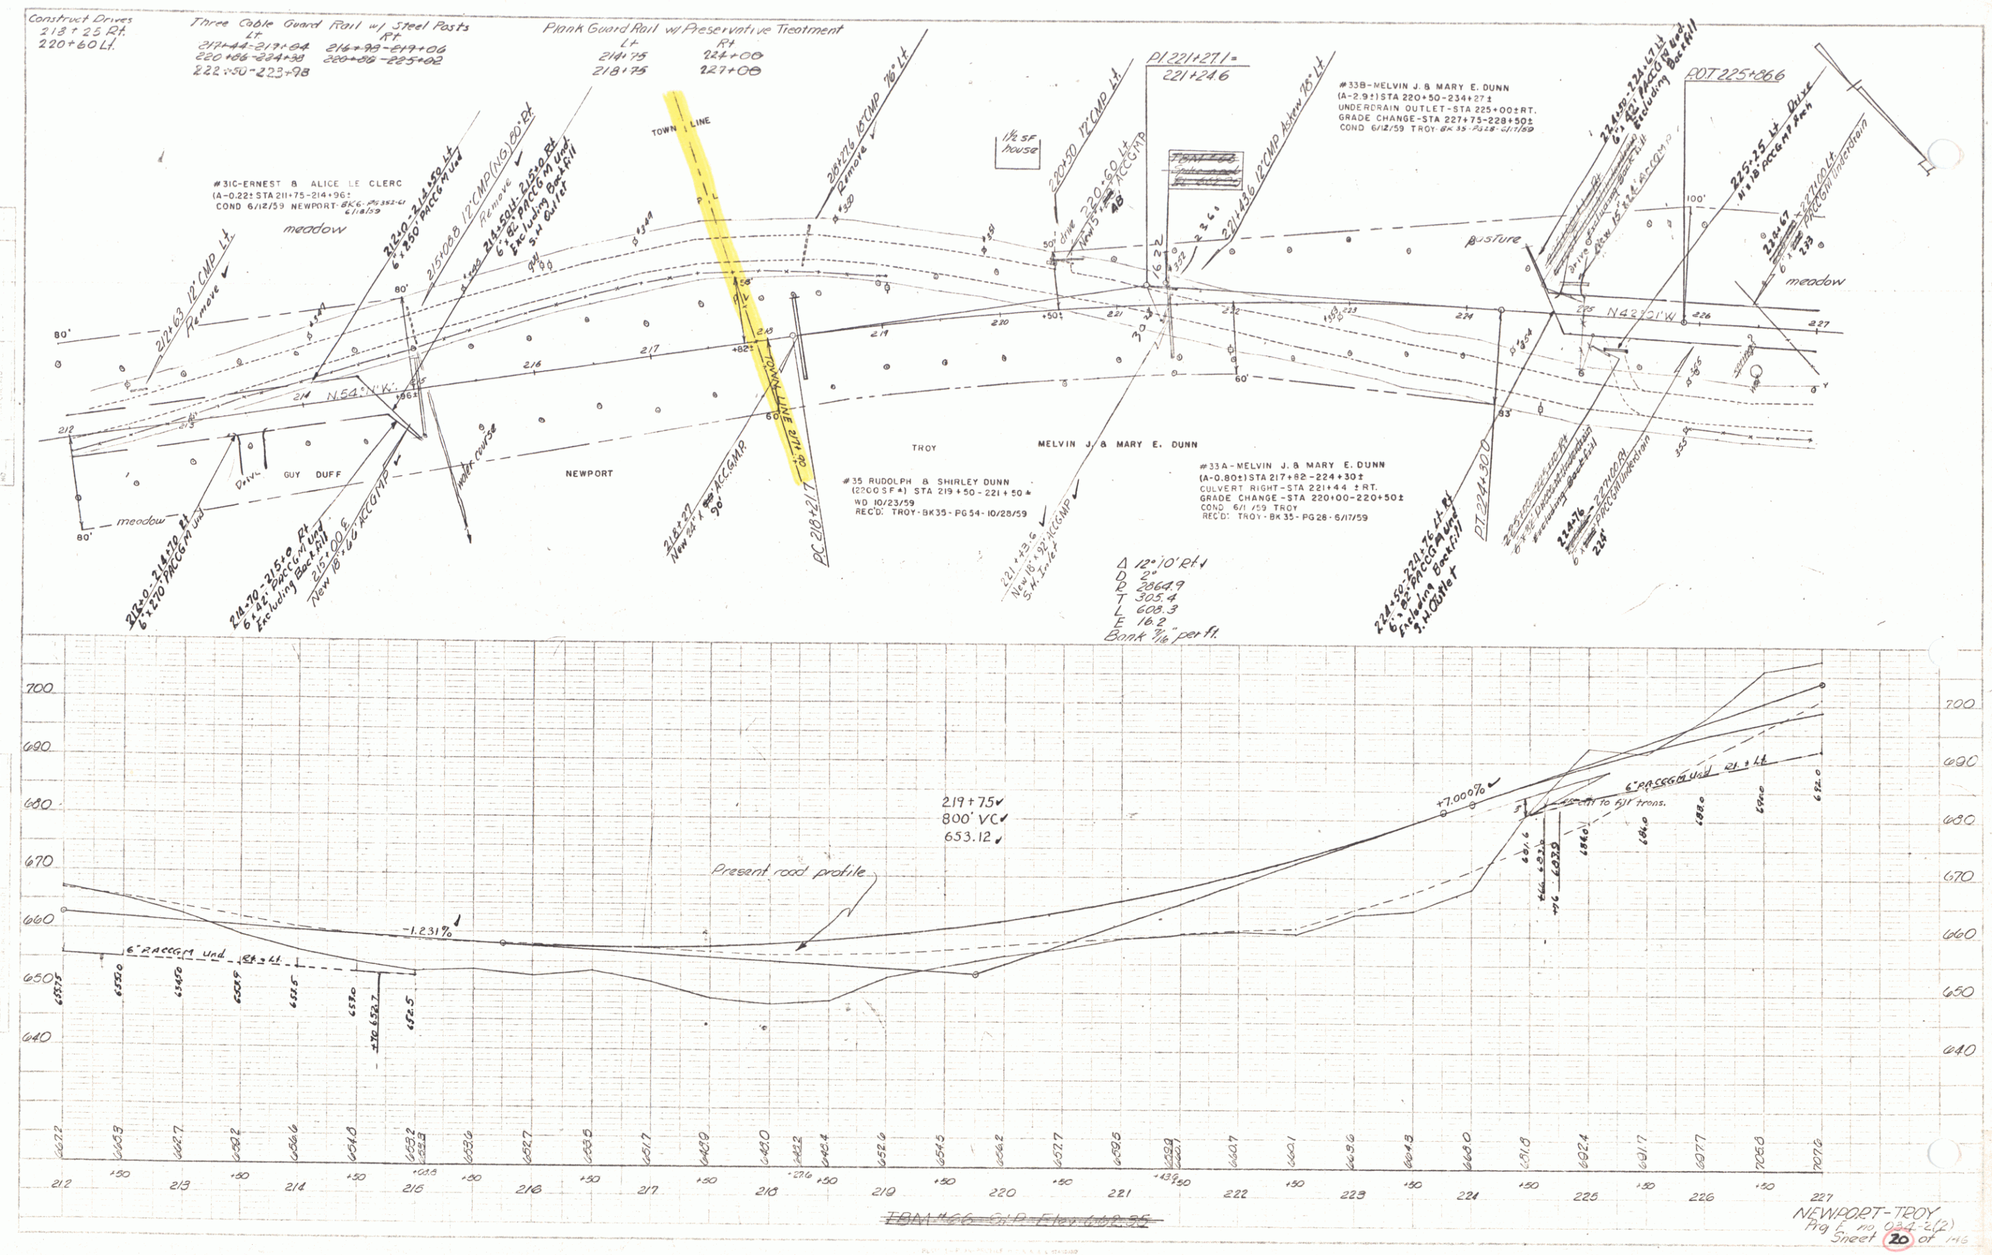

~~TBM #66 Grid Elev. 668.96~~

NEWPORT-TROY
Proj. no. 024-2(2)
Sheet 20 of 146

Delano 7-57

Bryant 7-57

13