Fed Aid
30-C 1936 8 15

F.A.P. 30-C Wood Guard Rail		
Station	Lt	Rt
302+06	24	
307+00	48	48

F.A.P. 30-C Guide Posts		
Station	Lt	Rt
298+00	11	10
302+06		10

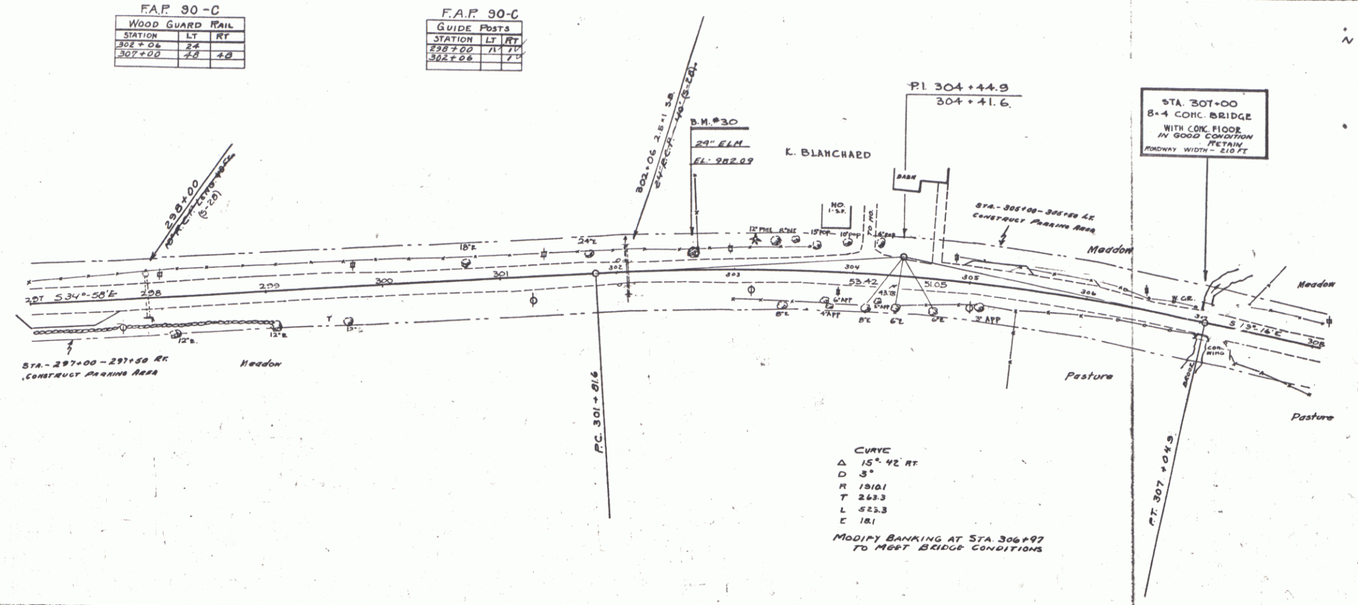

Series F.A.P. No. 30-C
Sheet 6 of 15

6