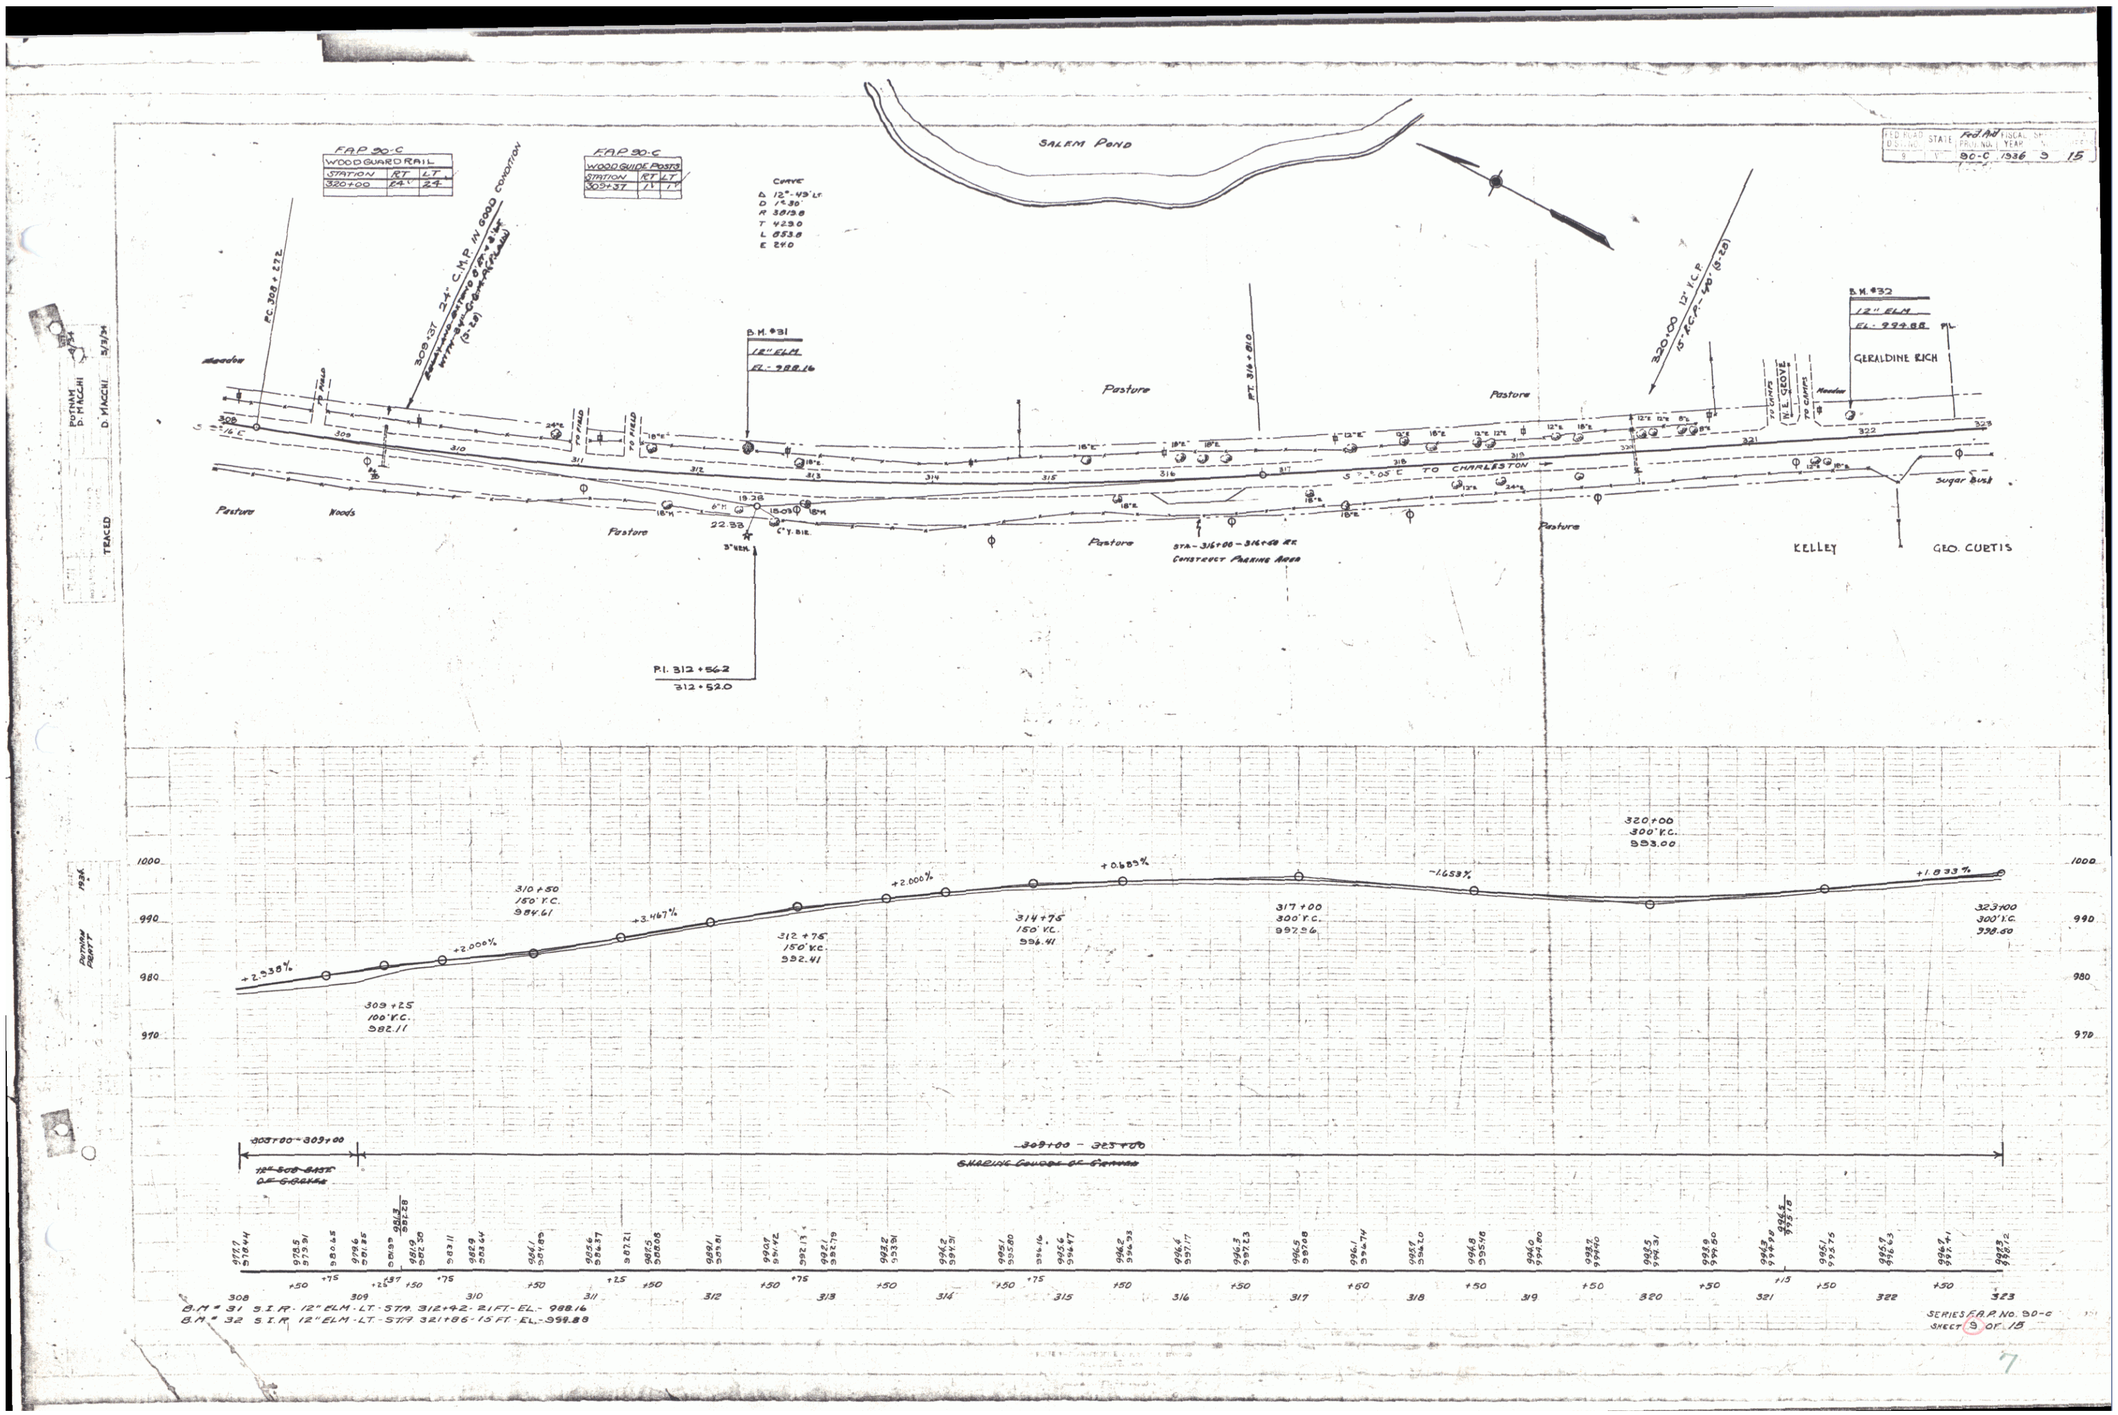
FED. ROAD STATE Fed Aid FISCAL SH. DIVISION PROJ. NO. YEAR SHEET
SALEM POND
FAP 80-C
WOOD GUARD RAIL
STATION RT LT
320+00 24" 24"
FAP 80-C
WOOD GUIDE POSTS
STATION RT LT
305+37
Curve
Δ 12°-43' LT.
P.C. 308 + 22.2
308+37 24" C.M.P. IN GOOD CONDITION
B.M. #31
12" ELM
EL. 988.16
Meadow
Pasture
Woods
TO FIELD
P.T. 316 + 81.0
320+00 12" V.C.P.
15" R.C.P. - 40' (S-28)
B.M. #32
12" ELM
EL. 999.88
GERALDINE RICH
TO LIGHTS
N.E. GROVE
TO CAMPS
Sugar Bush
S 75°-05' E TO CHARLESTON
22.33
19.38
15.03
C.Y. BIR.
3" ELM.
STA. - 316+00 - 316+60 R.R.
CONSTRUCT PARKING AREA
KELLEY
GEO. CURTIS
P.I. 312 + 56.2
312 + 52.0
TRACED D. MAGGI 3/3/34
POTNAM D. MAGGI
1000
990
980
970
+2.338%
309+25
100' V.C.
982.11
310+50
150' V.C.
984.61
+2.000%
+3.167%
312+75
150' V.C.
992.41
+2.000%
314+75
150' V.C.
996.41
+0.683%
317+00
300' V.C.
997.56
-1.653%
320+00
300' V.C.
993.00
323+00
300' V.C.
998.60
+1.833%
303+00 - 309+00
12" SOD BASE OF GRADE
309+00 - 323+00
SHARING GROUND OF GRADE
B.M. # 31 S.I.R. - 12" ELM - LT. - STA. 312+42 - 21 FT. - EL. - 988.16
B.M. # 32 S.I.R. 12" ELM - LT. - STA 321+86 - 15 FT. - EL. - 999.88
SERIES F.A.P. NO. 80-C
SHEET 9 OF 15

7