STATE	FED. AID PROJ. NO.	FISCAL YEAR	SHEET NO.	TOTAL SHEETS
VT.	30-D	1936	4	70

90-C	1936	13	15

F.A.P. 90-C WOOD GUARD RAIL		
STATION TO STATION	LT.	RT.
366+50	24'	
371+50 372+38	88'	

F.A.P. 90-C GUIDE POSTS		
STATION	LT.	RT.
366+50		1
372+24		1
373+89	1	1

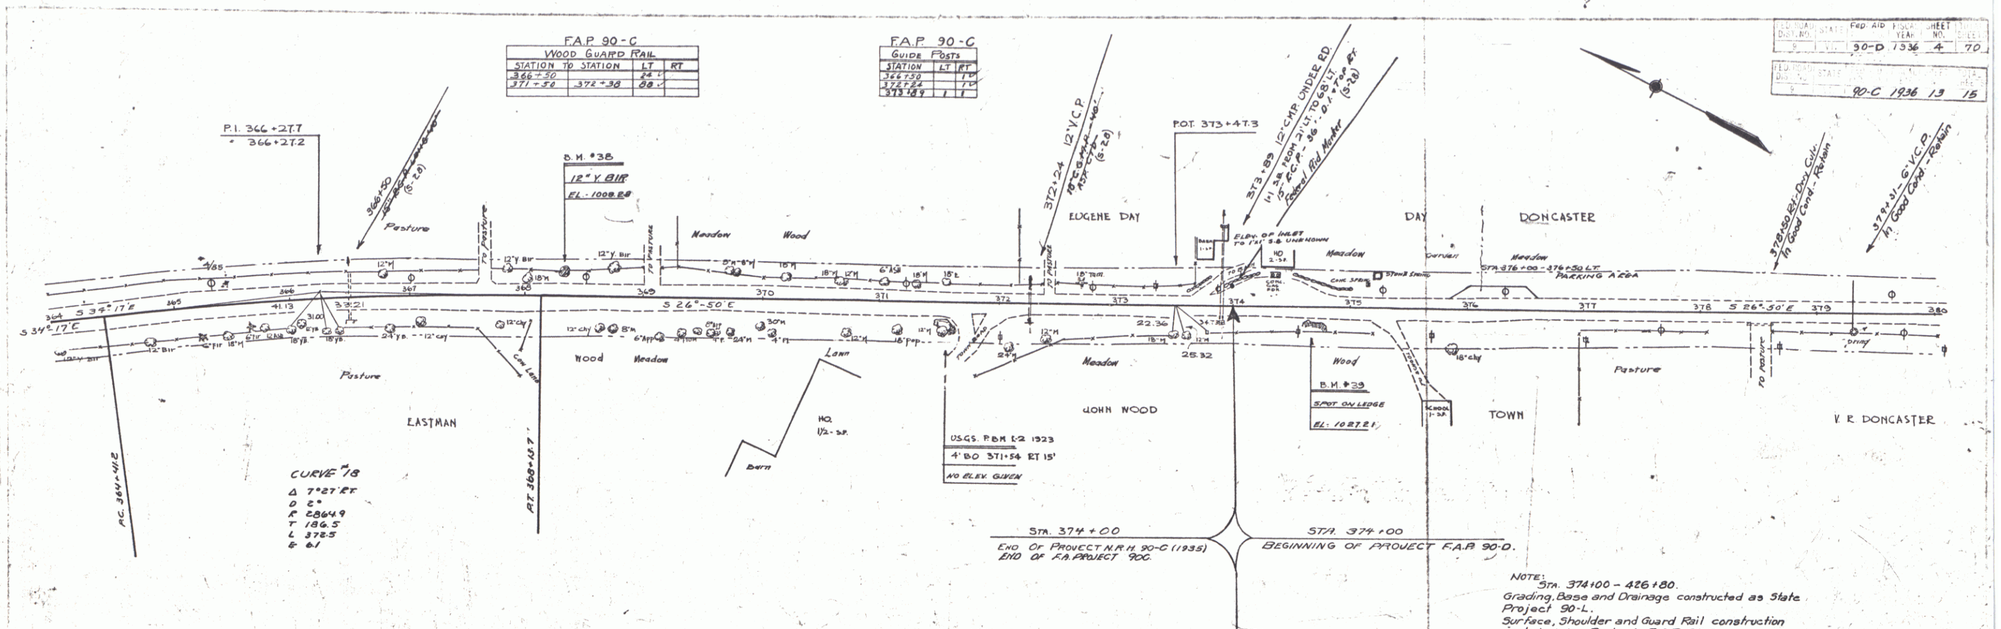

PUTNAM
D. MACCHI
D. MACCHI
TRACED
D. MACCHI 5/1/34

11